


BEGIN MAINT. AGREE. AREA NO. 2
 STA. WB 1197+70 228' LT. L=922±

PROPERTY LINE FENCE WITH STEEL POSTS ITEM 583-II MOD.		
STATION	STATION	POS.
WB 1197+70	1197+70	1
WB 1199+00	1199+00	2
WB 1199+00	1200+00	3

DEMOLITION AND DISPOSAL OF BUILDING ITEM 586	
STATION	POS.
1197+70	RT
1197+70	RT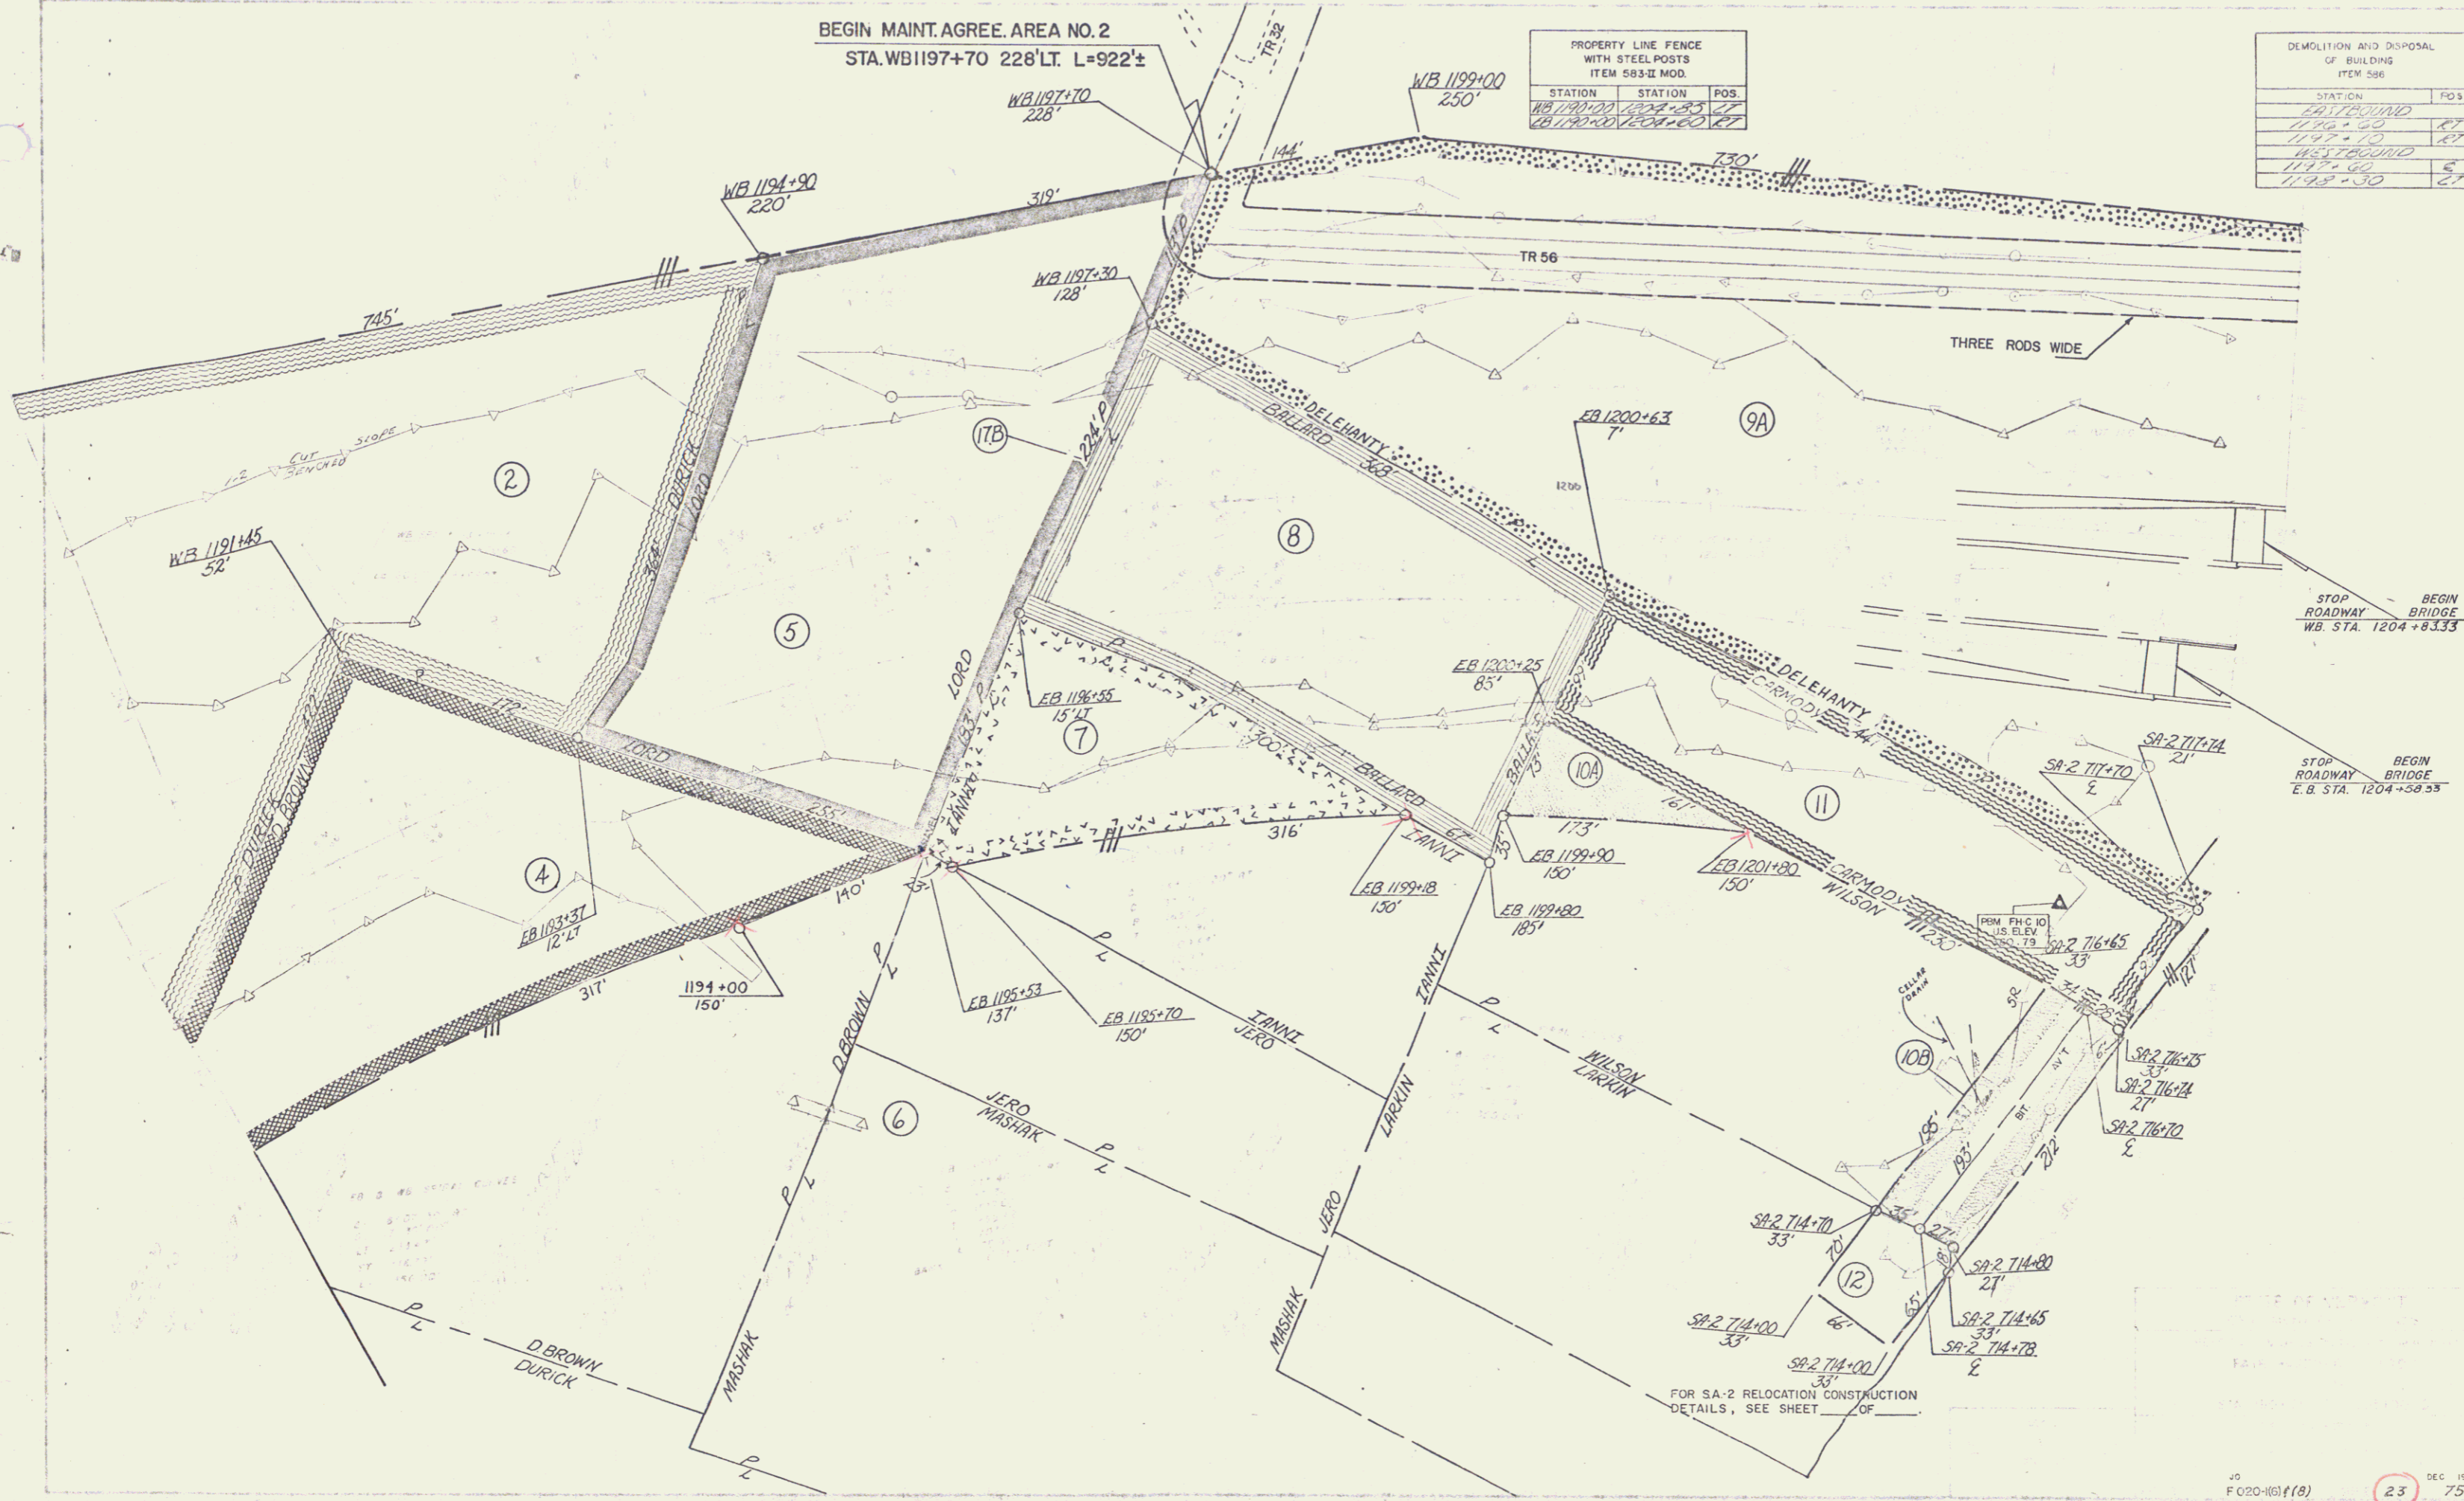
FOR SA-2 RELOCATION CONSTRUCTION DETAILS, SEE SHEET OF

4