


PROPERTY LINE FENCE
WITH STEEL POSTS
ITEM 583-II MOD.

STATION	STATION	POS.
1323+00	1340+00	BT
1326+00	1340+00	BT
1329+00	1344+00	BT

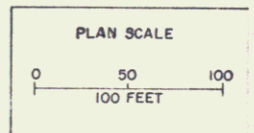

37 DEC 1967 75

18