


PROPERTY LINE FENCE WITH STEEL POSTS ITEM 593-II MOD.		
STATION	STATION	POS.
	EASTBOUND	
1355+00	1371+00	127
	WESTBOUND	
1360+00	1323+00	127

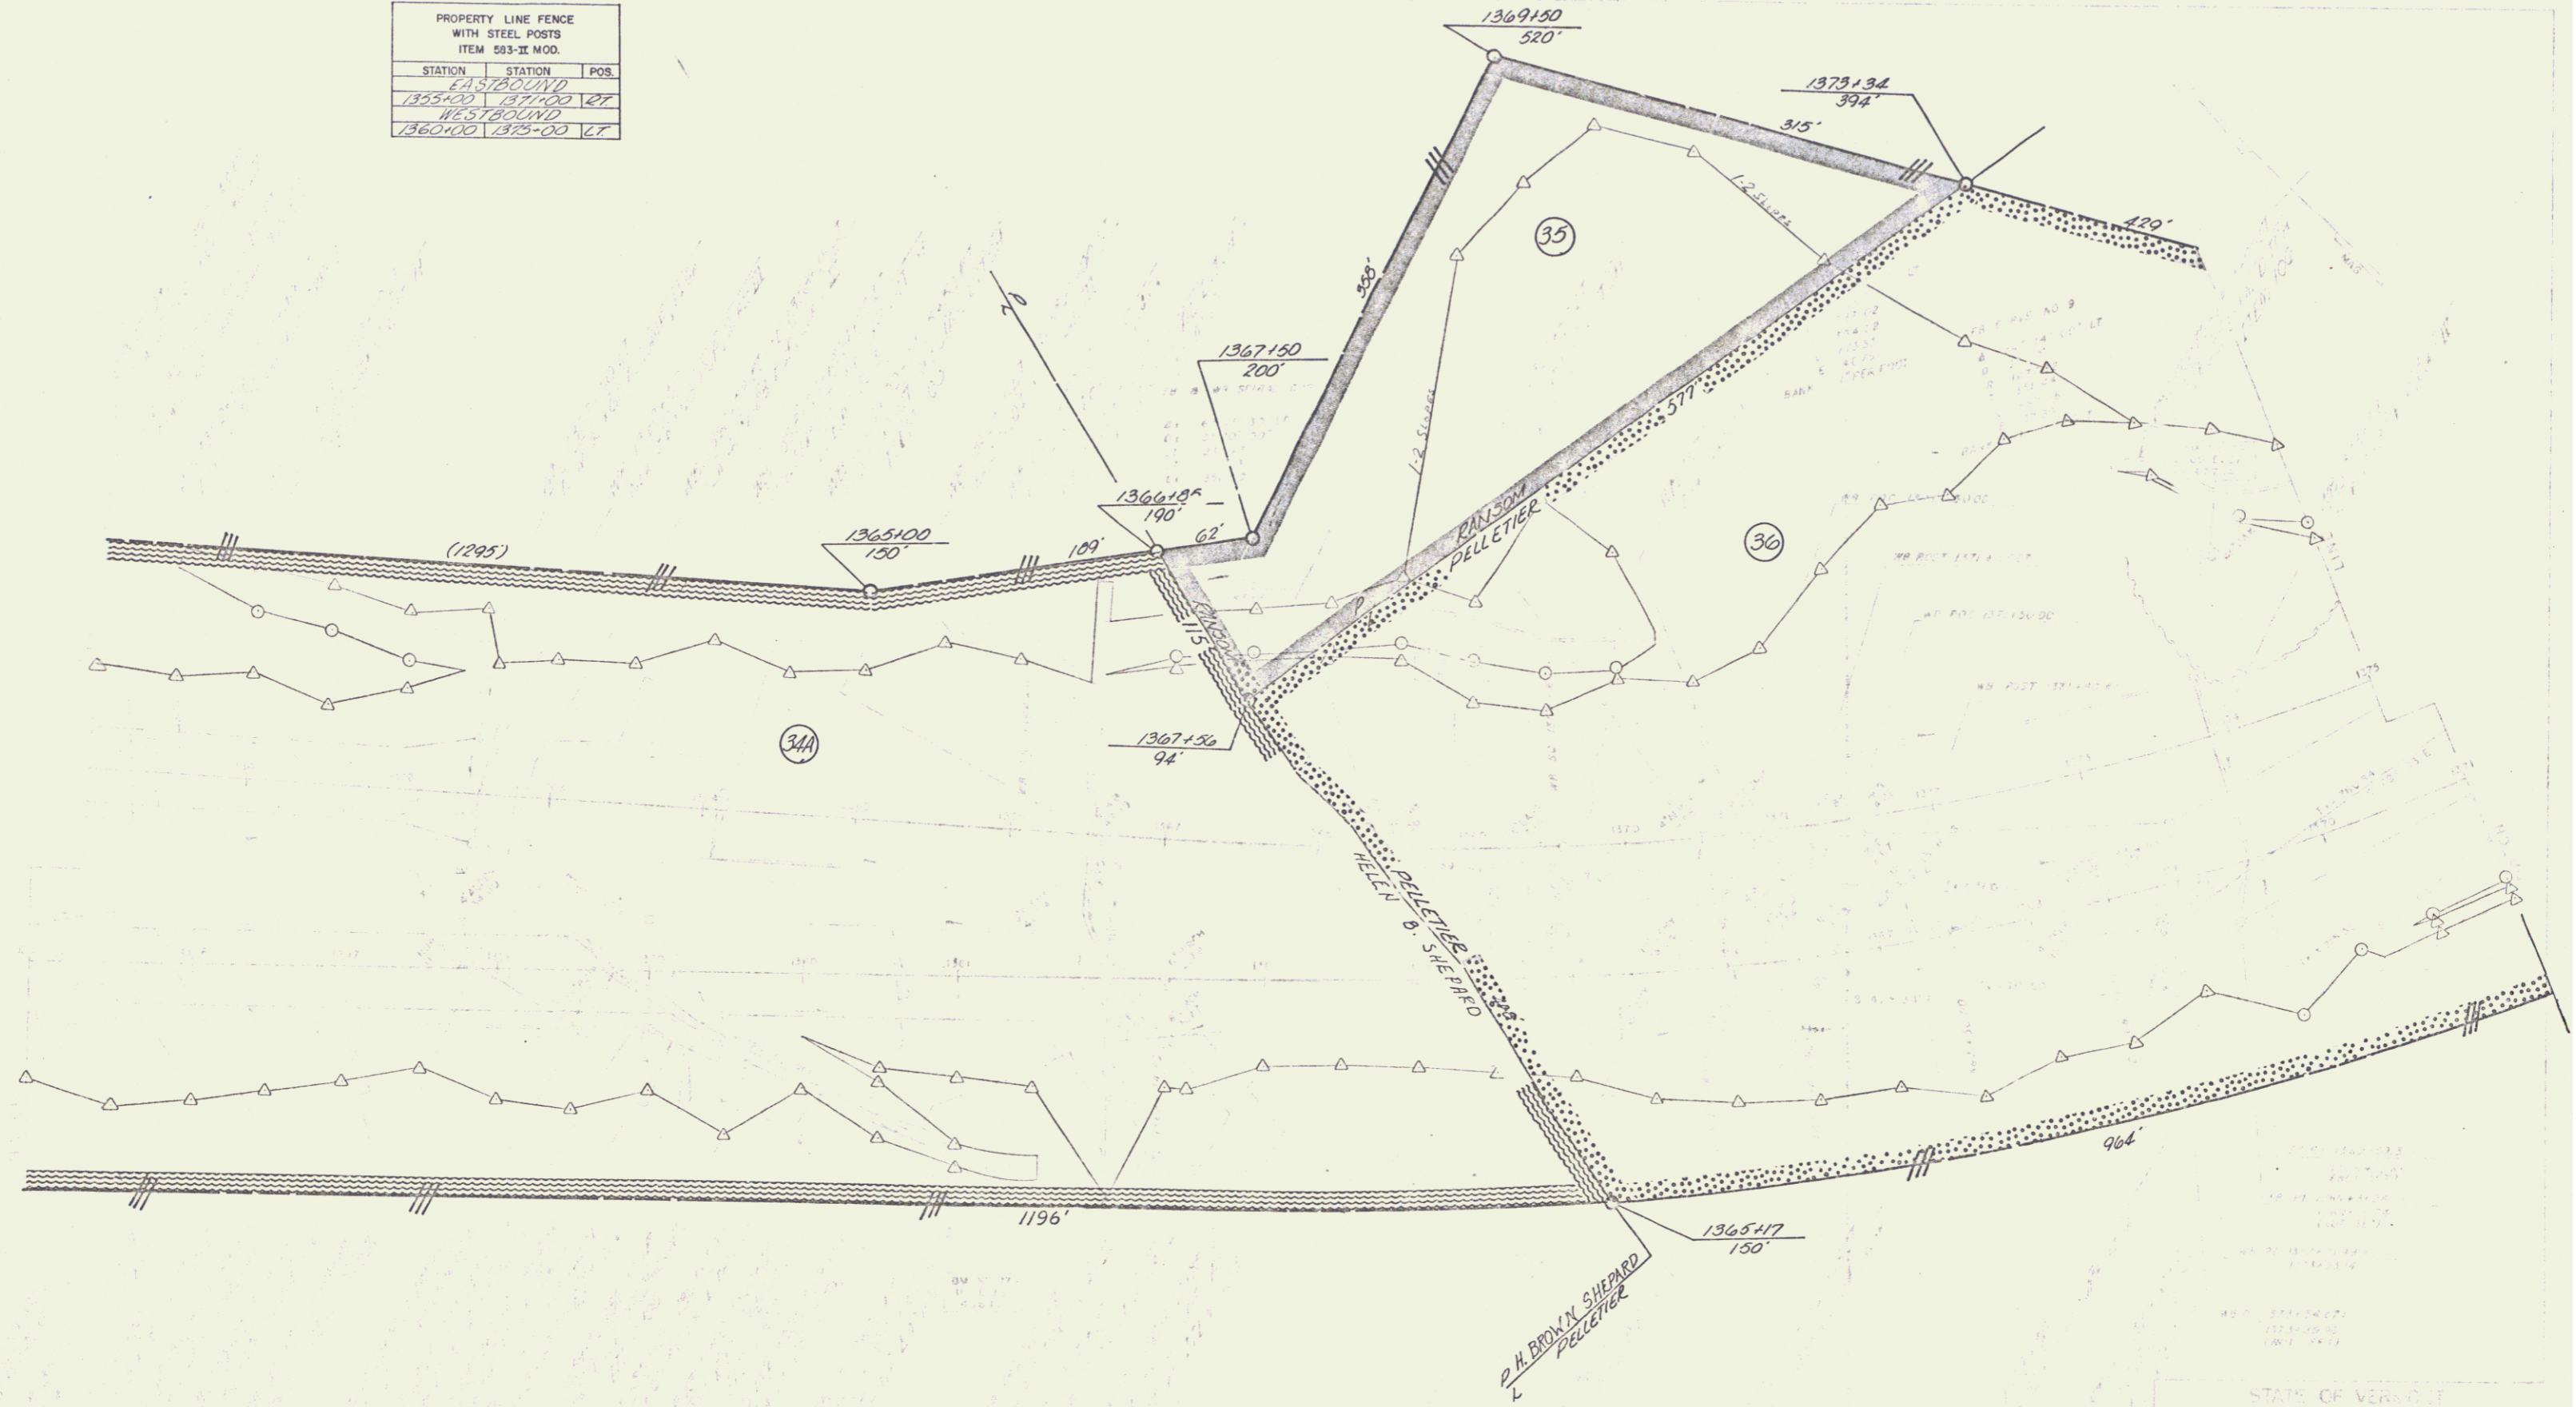

STATE OF VERMONT  
 PLANNING BOARD  
 DEC 19 1975  
 41