


POOR ORIGINAL COPY

CONSTRUCT DRIVE	594.75-6023 ITEM 556-B	TOP-OIL FLOORING ITEM 551-161	DEMOLITION & DISPOSAL OF BUILDING ITEM 555	GRADING & ELASTICITY OF SOIL
US 5 447+00-451+00	US 5 447+30-448+60	US 5 451+00-453+75	US 5 451+00-453+75	20% SUBGRADE ITEM 55
US 5 449+70-450+00	US 5 449+00-450+00	Ramp A 1+40-4+40	US 5 451+00-453+75	VI 2% 2+50-3+00
US 5 451+00-453+75	US 5 451+00-453+75	Ramp A 1+40-4+40	US 5 451+00-453+75	VI 2% 2+50-3+00
US 5 451+00-453+75	US 5 451+00-453+75	Ramp A 1+40-4+40	US 5 451+00-453+75	VI 2% 2+50-3+00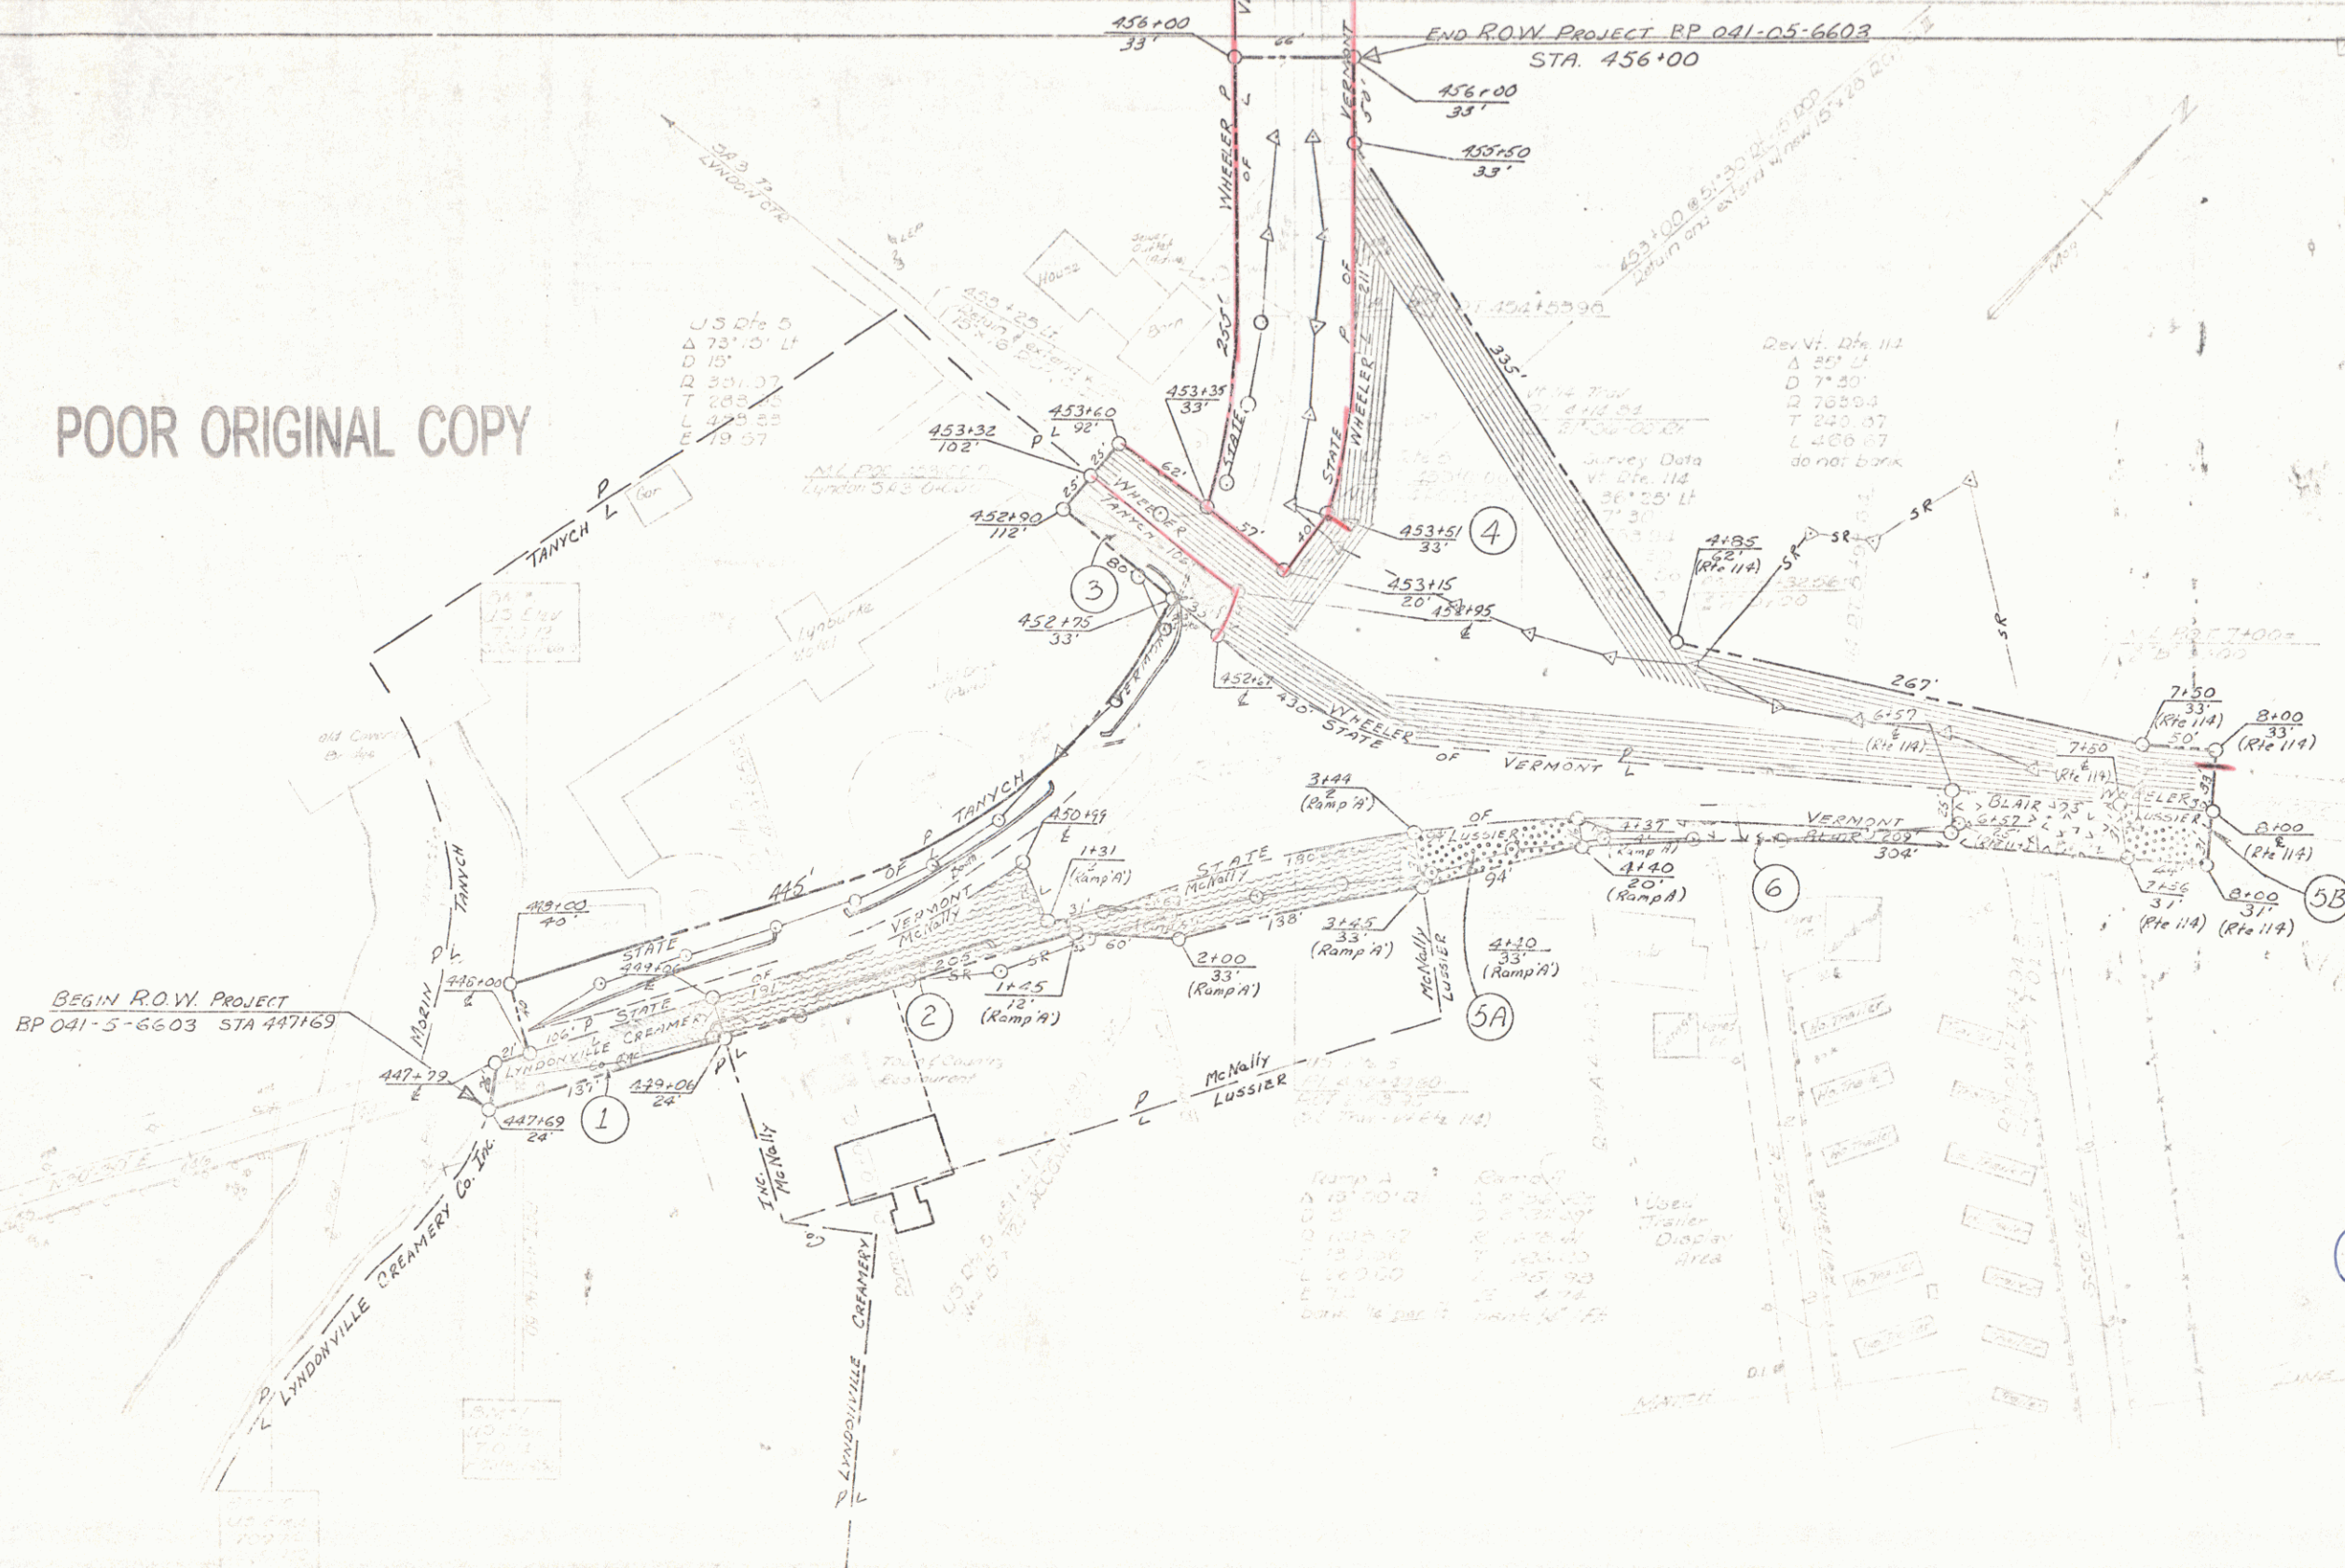
Row not acquired

DATE: 5/1/50  
 DRAWN BY: [Signature]  
 CHECKED BY: [Signature]  
 TITLE: [Blank]  
 SHEET: 5