
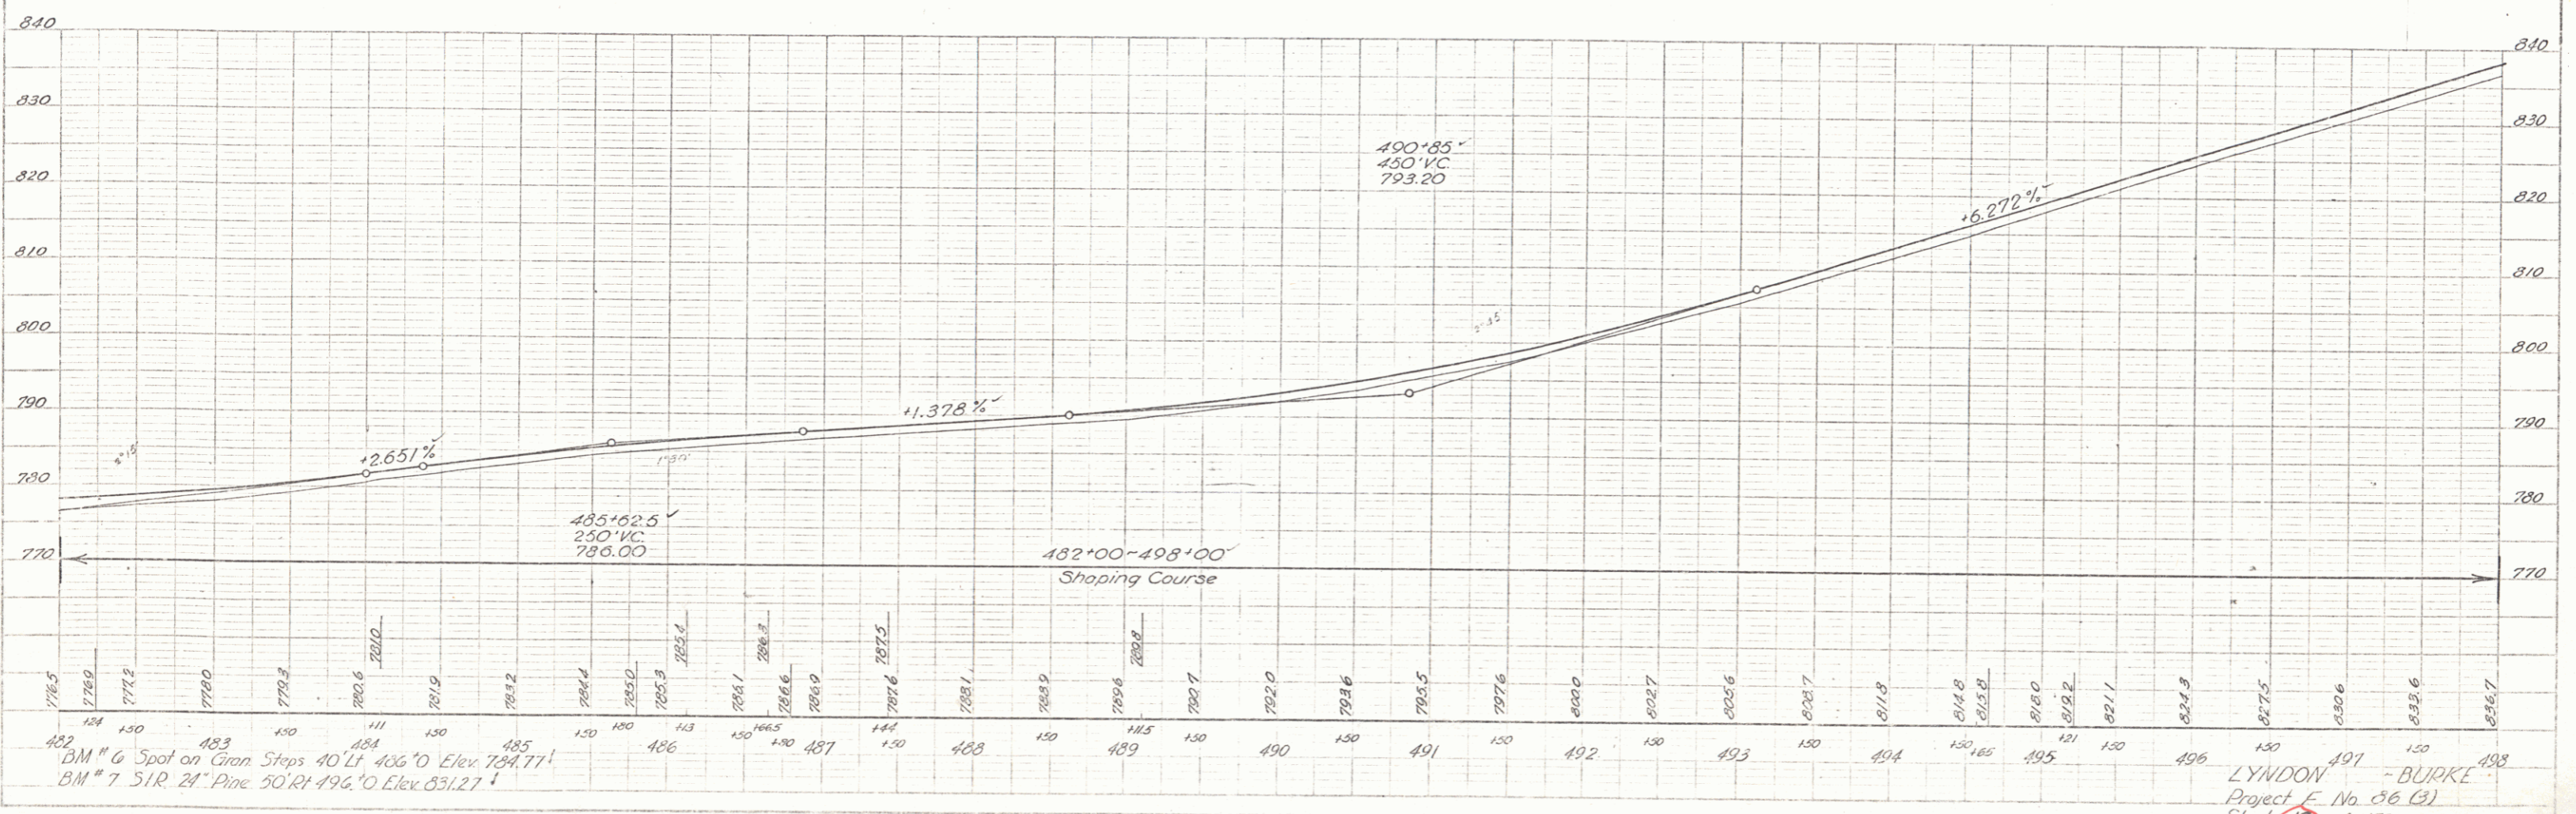


PLAN
 DATE 10/15/10
 DRAWN BY J. BURKE
 CHECKED BY J. BURKE
 PROJECT NO. 06(3)
 SHEET NO. 17

DATE 10/15/10
 DRAWN BY J. BURKE
 CHECKED BY J. BURKE
 PROJECT NO. 06(3)
 SHEET NO. 17

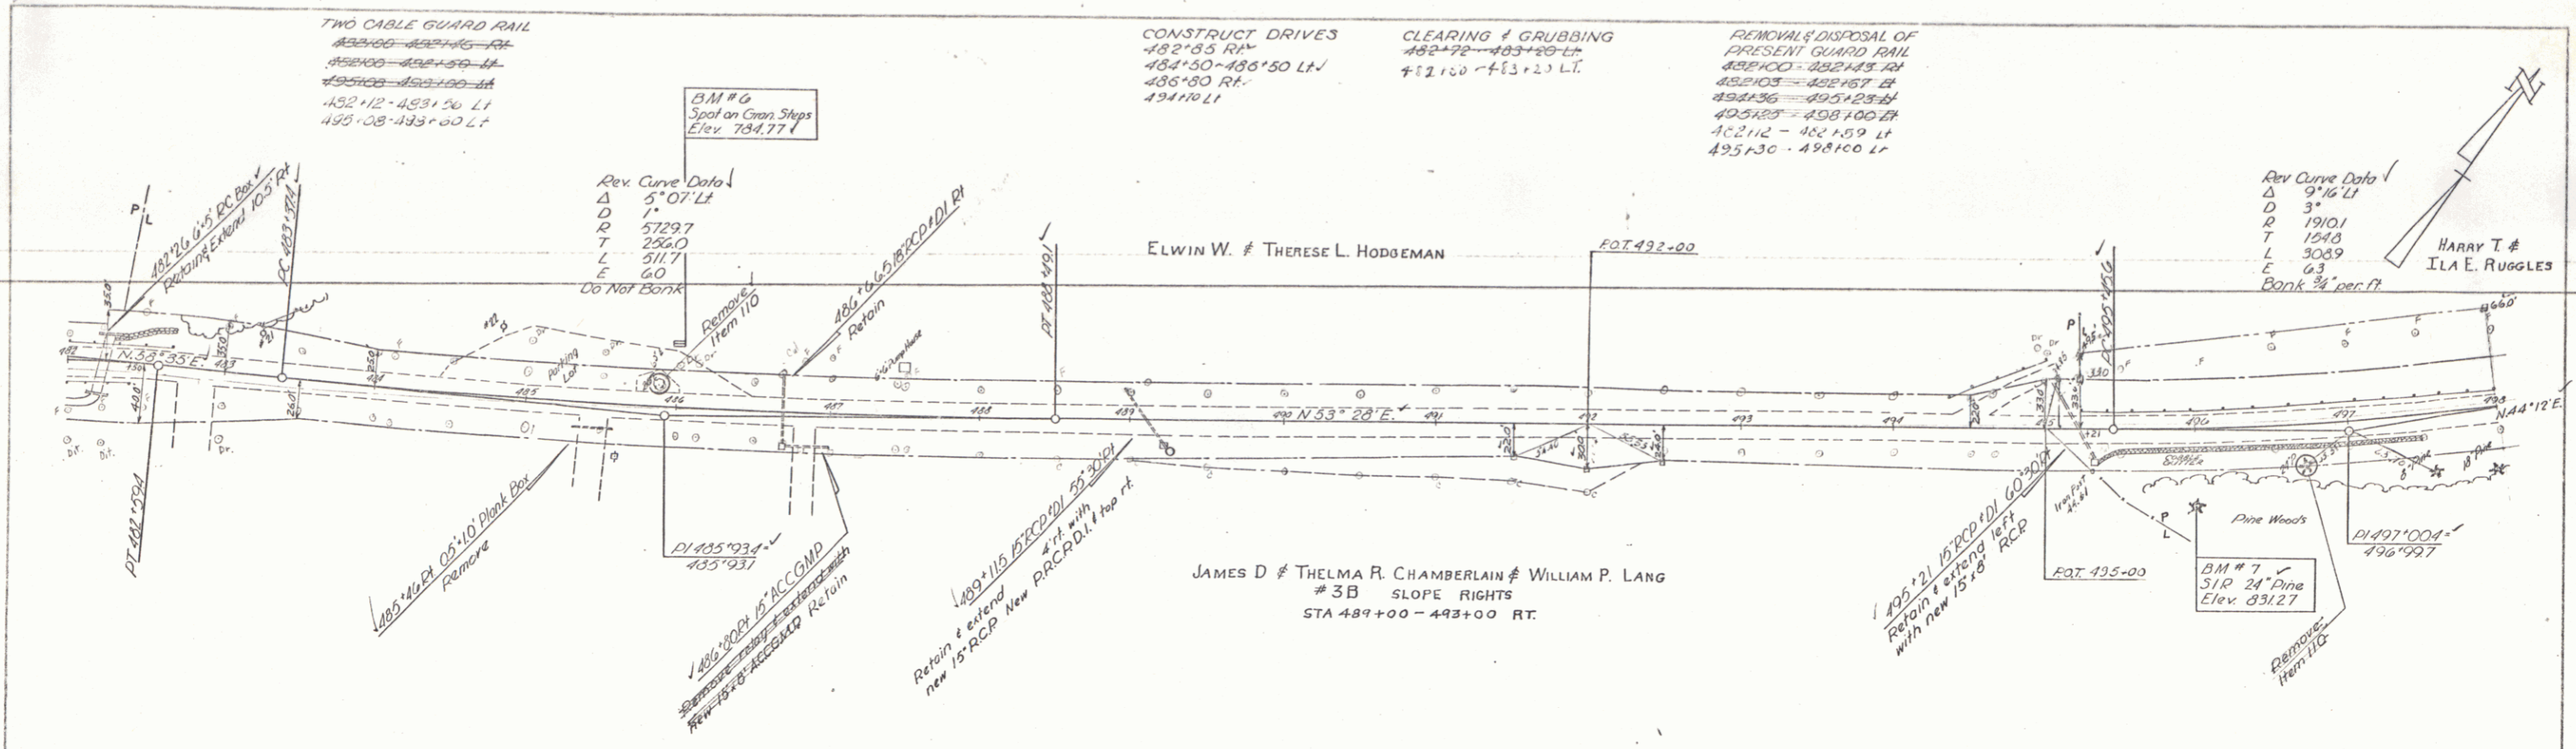

LYNDON - BURKE
 Project F. No. 06(3)
 Shed 17 of 173