

CONSTRUCT DRIVE  
 520+00-521+50 LT  
 522+70 RA -

CLEARING & GRUBBING  
 518+95-519+50 RT  
 526+25-527+75 LT  
 518+50-519+00 RT

WOOD CURVE POSTS  
 LT 16' 4"  
 516+83-519+11  
 RT  
 526+84-528+00

$\Delta$  14°24'11"  
 D 4'  
 R 1432.7  
 T 131.0  
 L 360.0  
 E 11.4  
 Bank 3/4' per ft.


$\Delta$  17°11'14" RT  
 D 3'  
 R 1910.1  
 T 282.4  
 L 572.4  
 E 21.8  
 Bank 3/4' per ft.

A.E. BISHOP  
 #2C  
 SLOPE RIGHTS  
 STA 515+30-520+15 RT.

F.D. GREENE  
 #6D  
 SLOPE RIGHTS  
 STA 526+00-528+00 LT

F.D. GREENE  
 #6A  
 0.50 ACRE±  
 STA 520+15-530+50 RT.

PARCEL	INSTRUMENT	DATE	GRANTOR	GRANTEE	RECORDED	BOOK	PAGE	DATE	REMARKS
6ABC	WDOE	11-3-55	F.D. GREENE	ST OF VT	LYNDON	45	435	2-2-56	see sheet 20 also slope rights
6D	WDOE	5-12-56	MRS. F.D. GREENE	ST OF VT	LYNDON	45	428	5-19-56	culvert rights

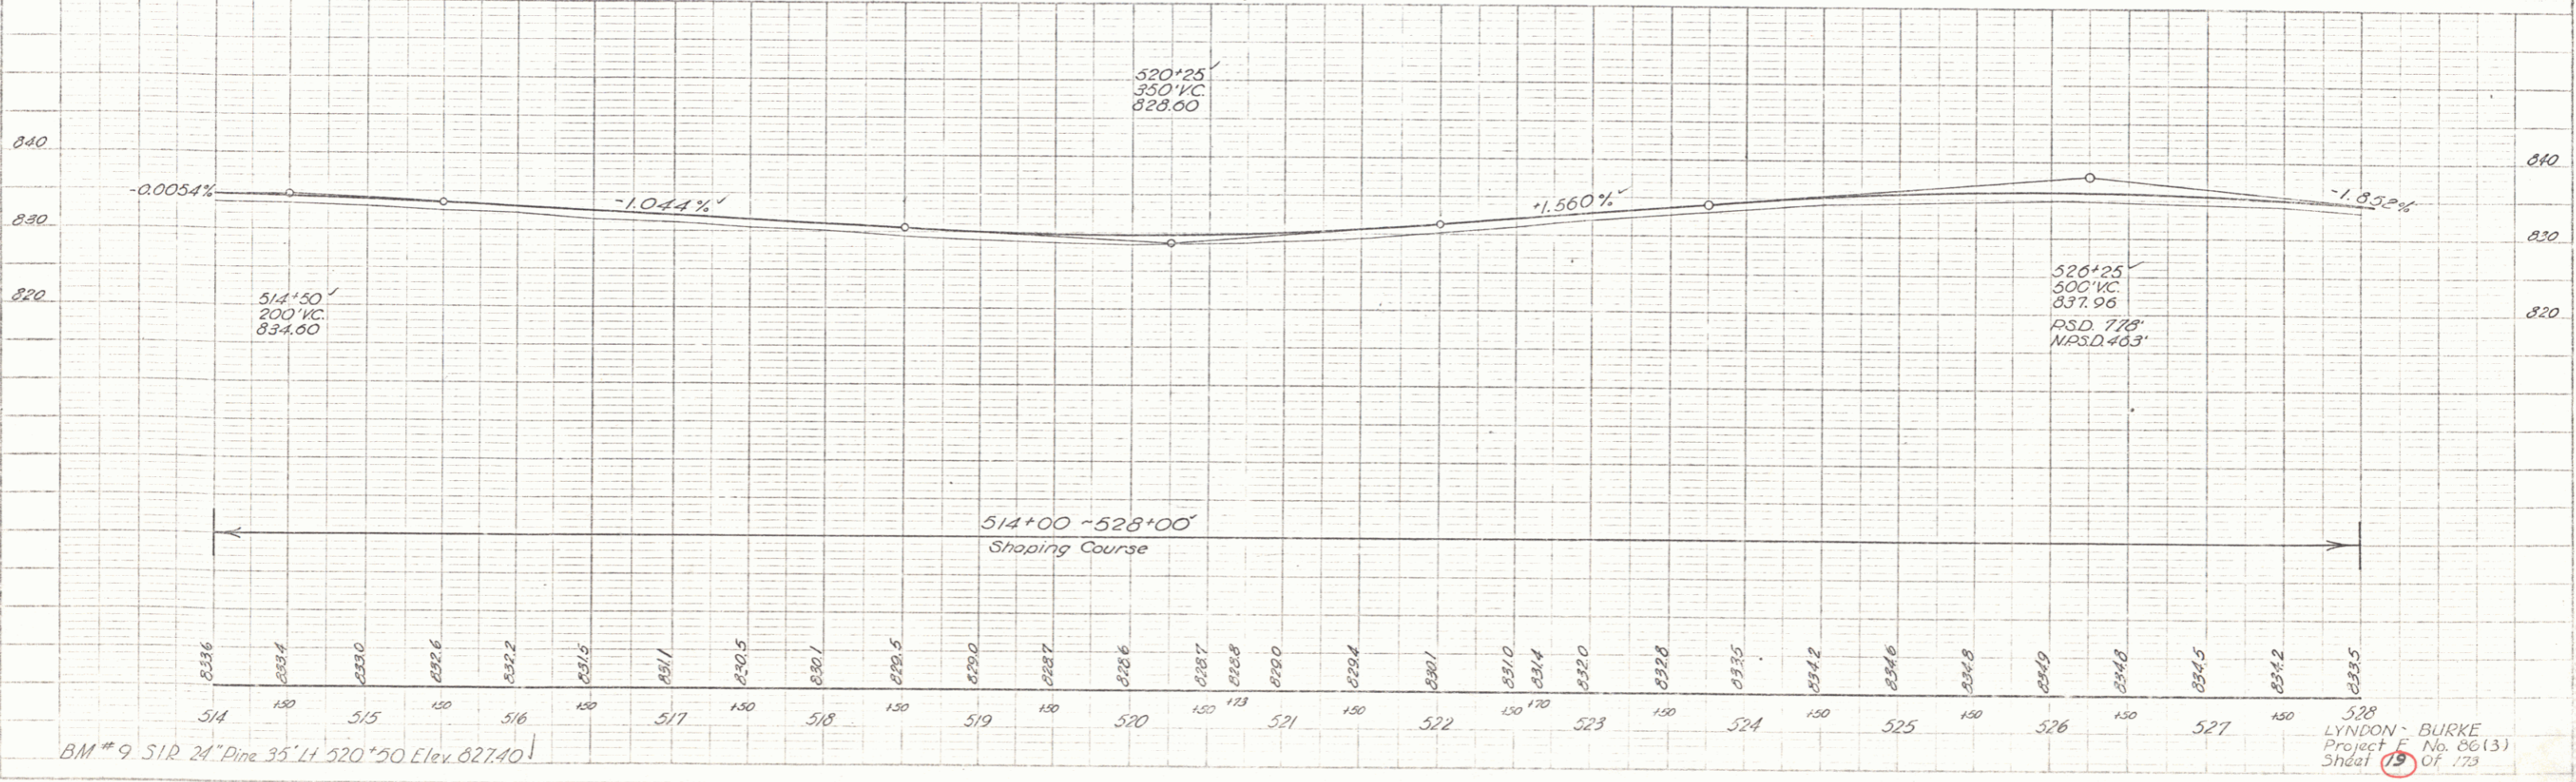

BM #9 SIR 24" Pipe 35' LT 520+50 Elev. 827.40'

528 BURKE  
 LYNDON Project No. 66(3)  
 Sheet 15 of 173