


TWO CABLE GUARD RAIL
 WOOD GUIDE POSTS
 631100 - 635100 LF
 631114 ~ 631198

CLEARING & GRUBBING
 631100 - 637170 RT
 630145 - 642130 RT

REMOVAL & DISPOSAL OF
 PRESENT GUARD RAIL
 631100 - 633105 LF
 631105 - 633187 LF

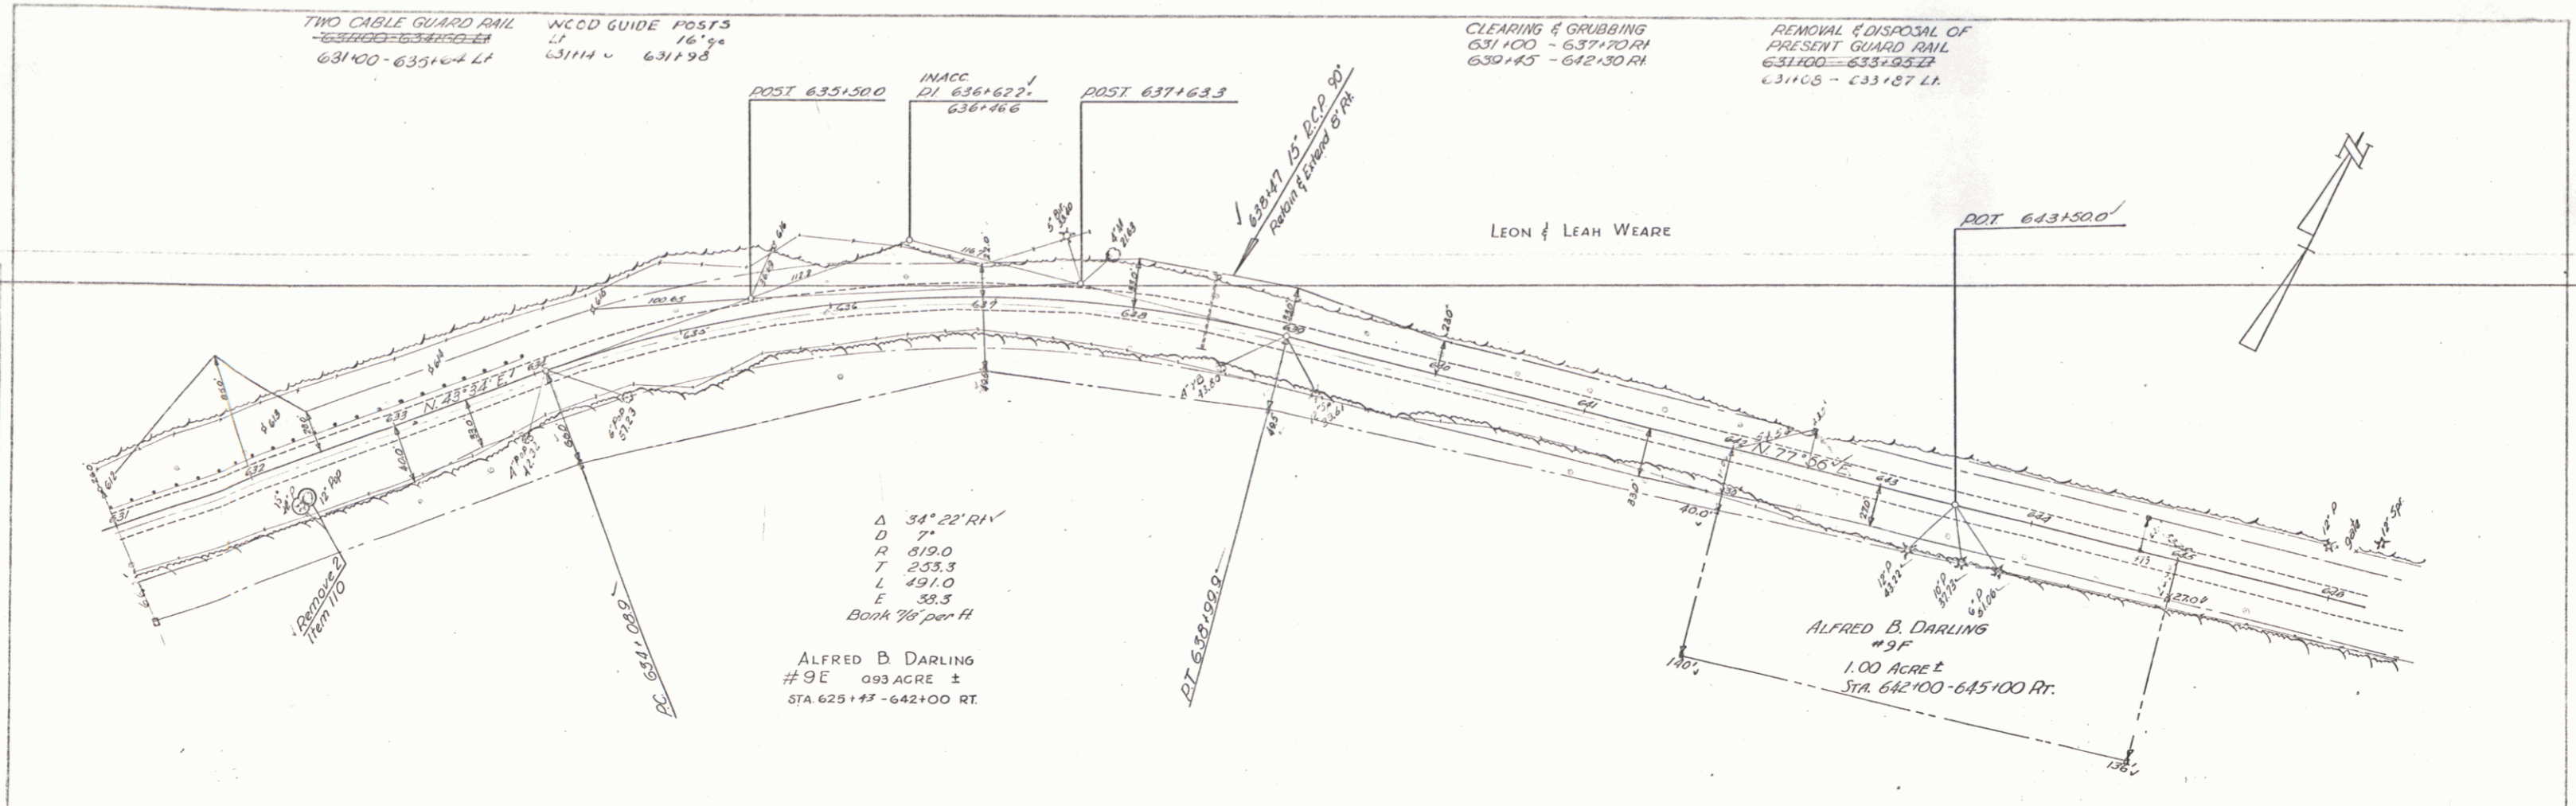

LYNDON - BURKE
 Proj. F. 100 66 (3)
 Sheet 27 of 173