


PARCEL INSTRUMENT DATE	GRANTOR	GRANTEE	RECORDED TOWN OF	Book Page	REMARKS
11 QCD	EDWARD C. & CECILE REYMERS	ST OF VT	BURKE		

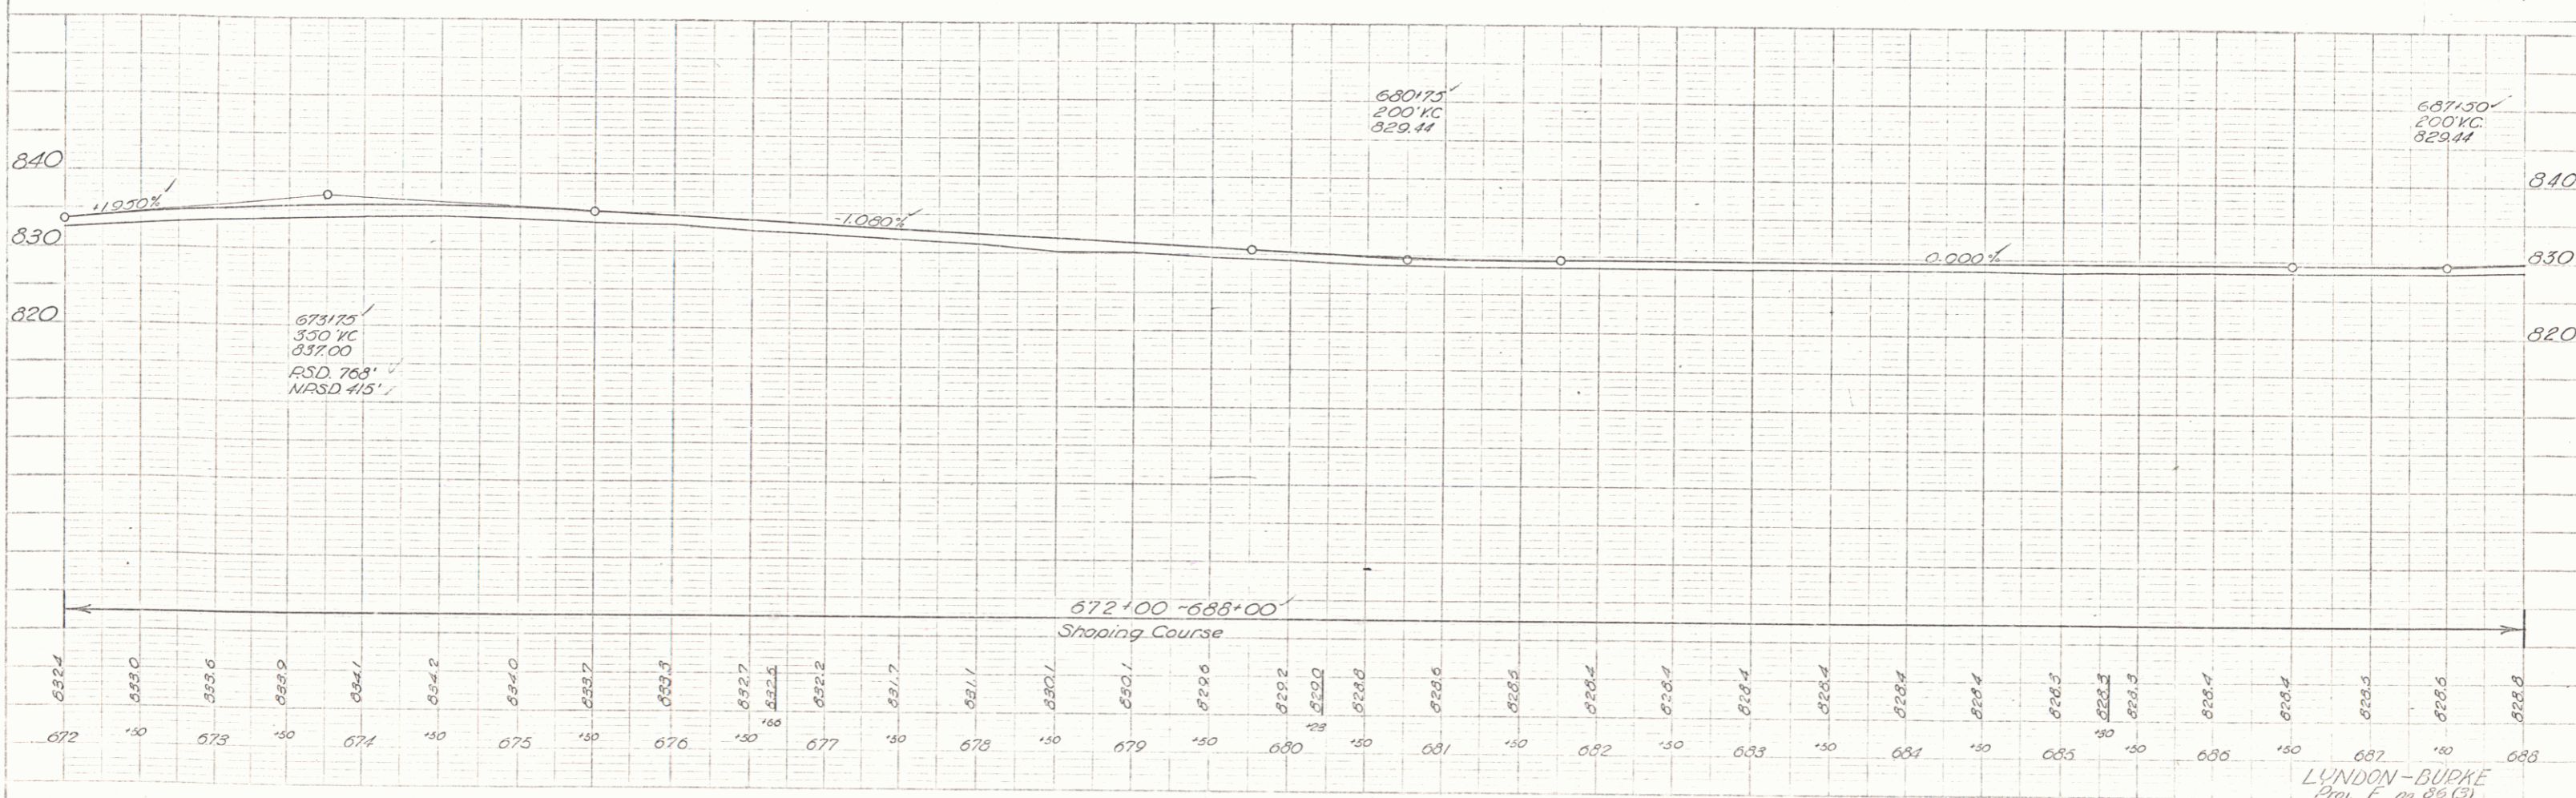

LUNDON-BURKE
 Proj. E. no. 86(2)
 Sheet 20 of 173