


PLAN
 DATE 11-1-55
 BY J. BURKE
 CHECKED BY J. BURKE

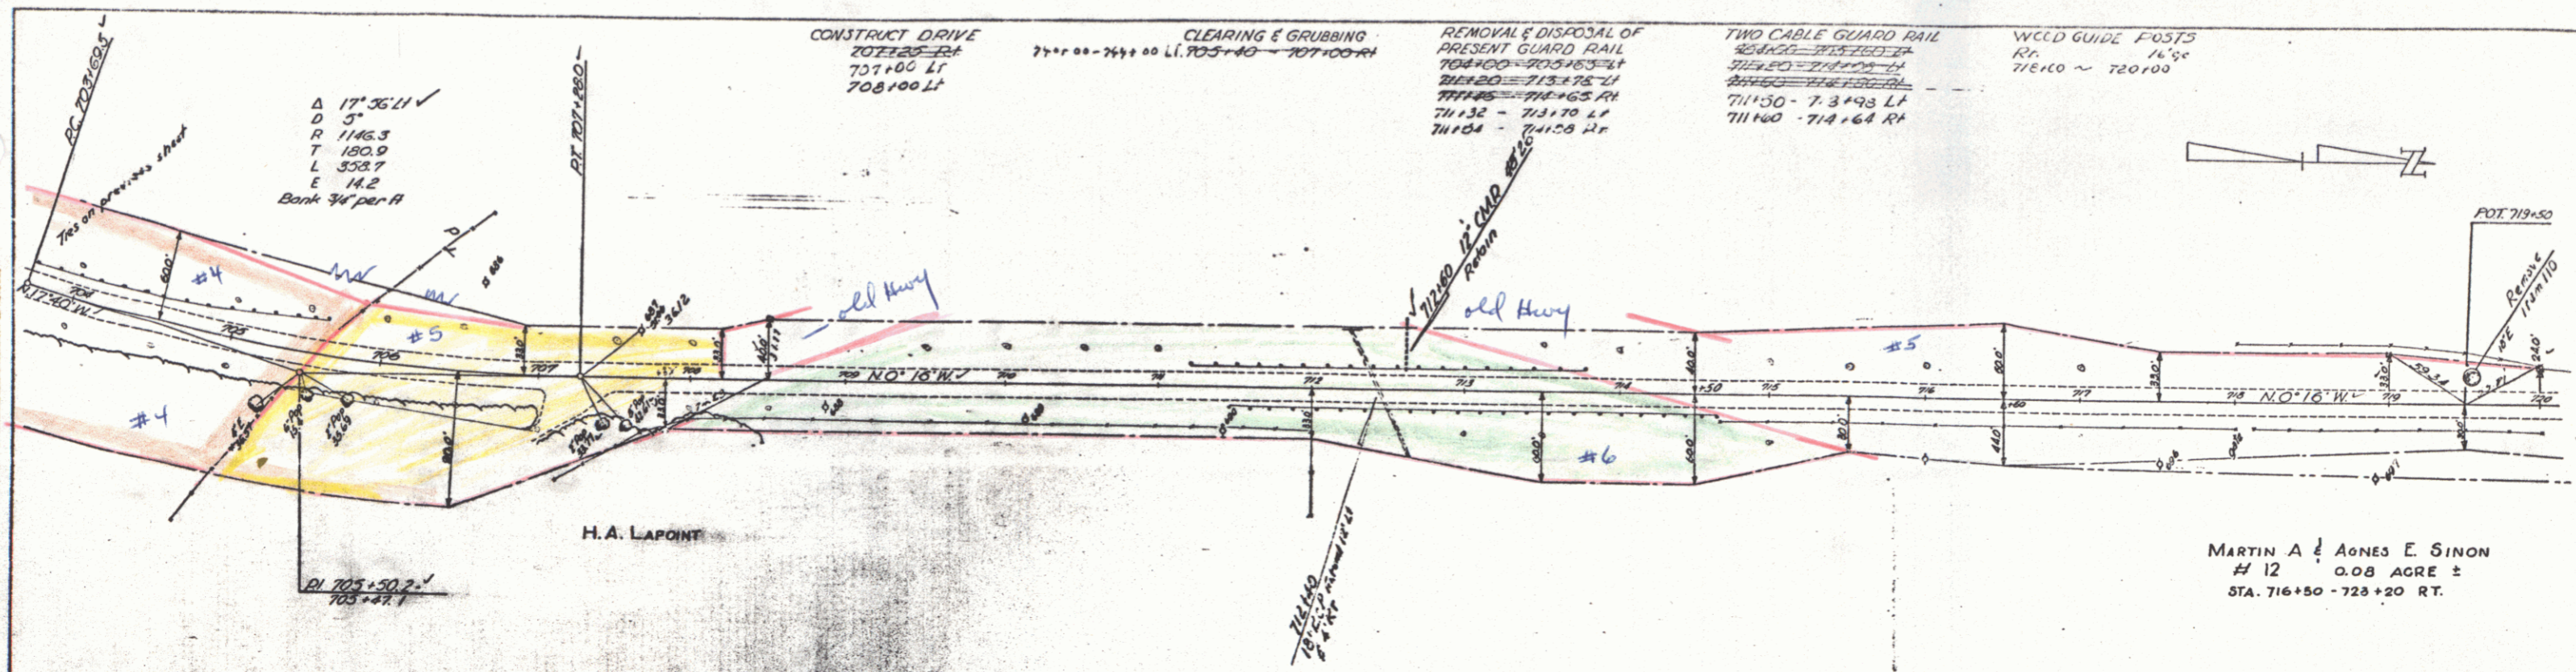

PARCEL INSTRUMENT DATE	GRANTOR	GRANTEE	RECORDED TOWN OF	BOOK	PAGE	DATE	REMARKS
12	WIDOE	11-1-53	MARTIN A & AGNES E SINON	VT	36	2-2-56	see also sheet 33

PROFILE
 DATE 11-1-55
 BY J. BURKE
 CHECKED BY J. BURKE

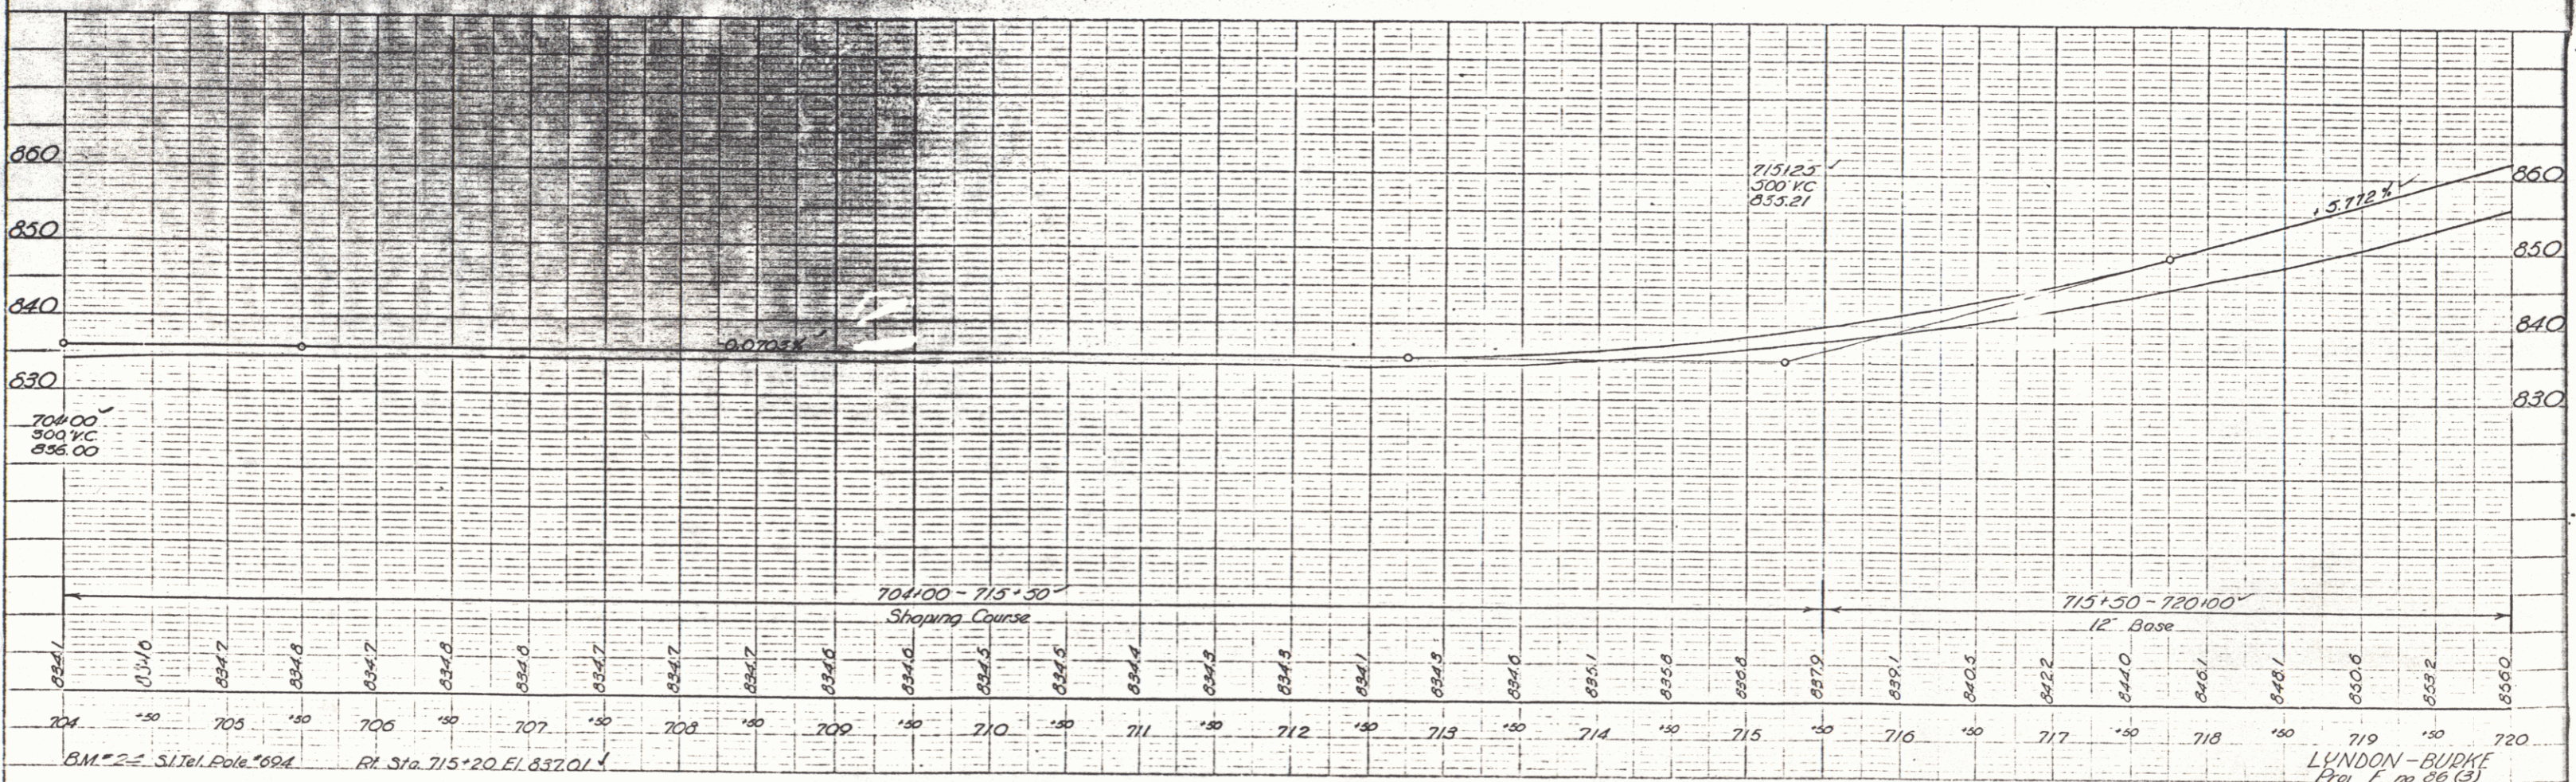


PLATE 1 - PLAN AND PROFILE
 SCALE 1" = 40' HORIZ. 1" = 10' VERT.
 J. BURKE

LYNDON - BURKE
 Proj. F. 86 (3)
 Sheet 32 of 173