


Δ 2' 18" LI
 D 0' 30"
 R 11430.2
 T 230.0
 L 460.0
 E 2.2

Δ 2' 32" RV
 D 1'
 R 3722.7
 T 143.4
 L 296.7
 E 1.8

C. O. & EDNA G. BALL
 #14C 0.80 ACRE \pm
 STA. 763+61.5 - 777+70 RT.

PLAN
 NOTE BOOK IN FIELD AND REVISIONS

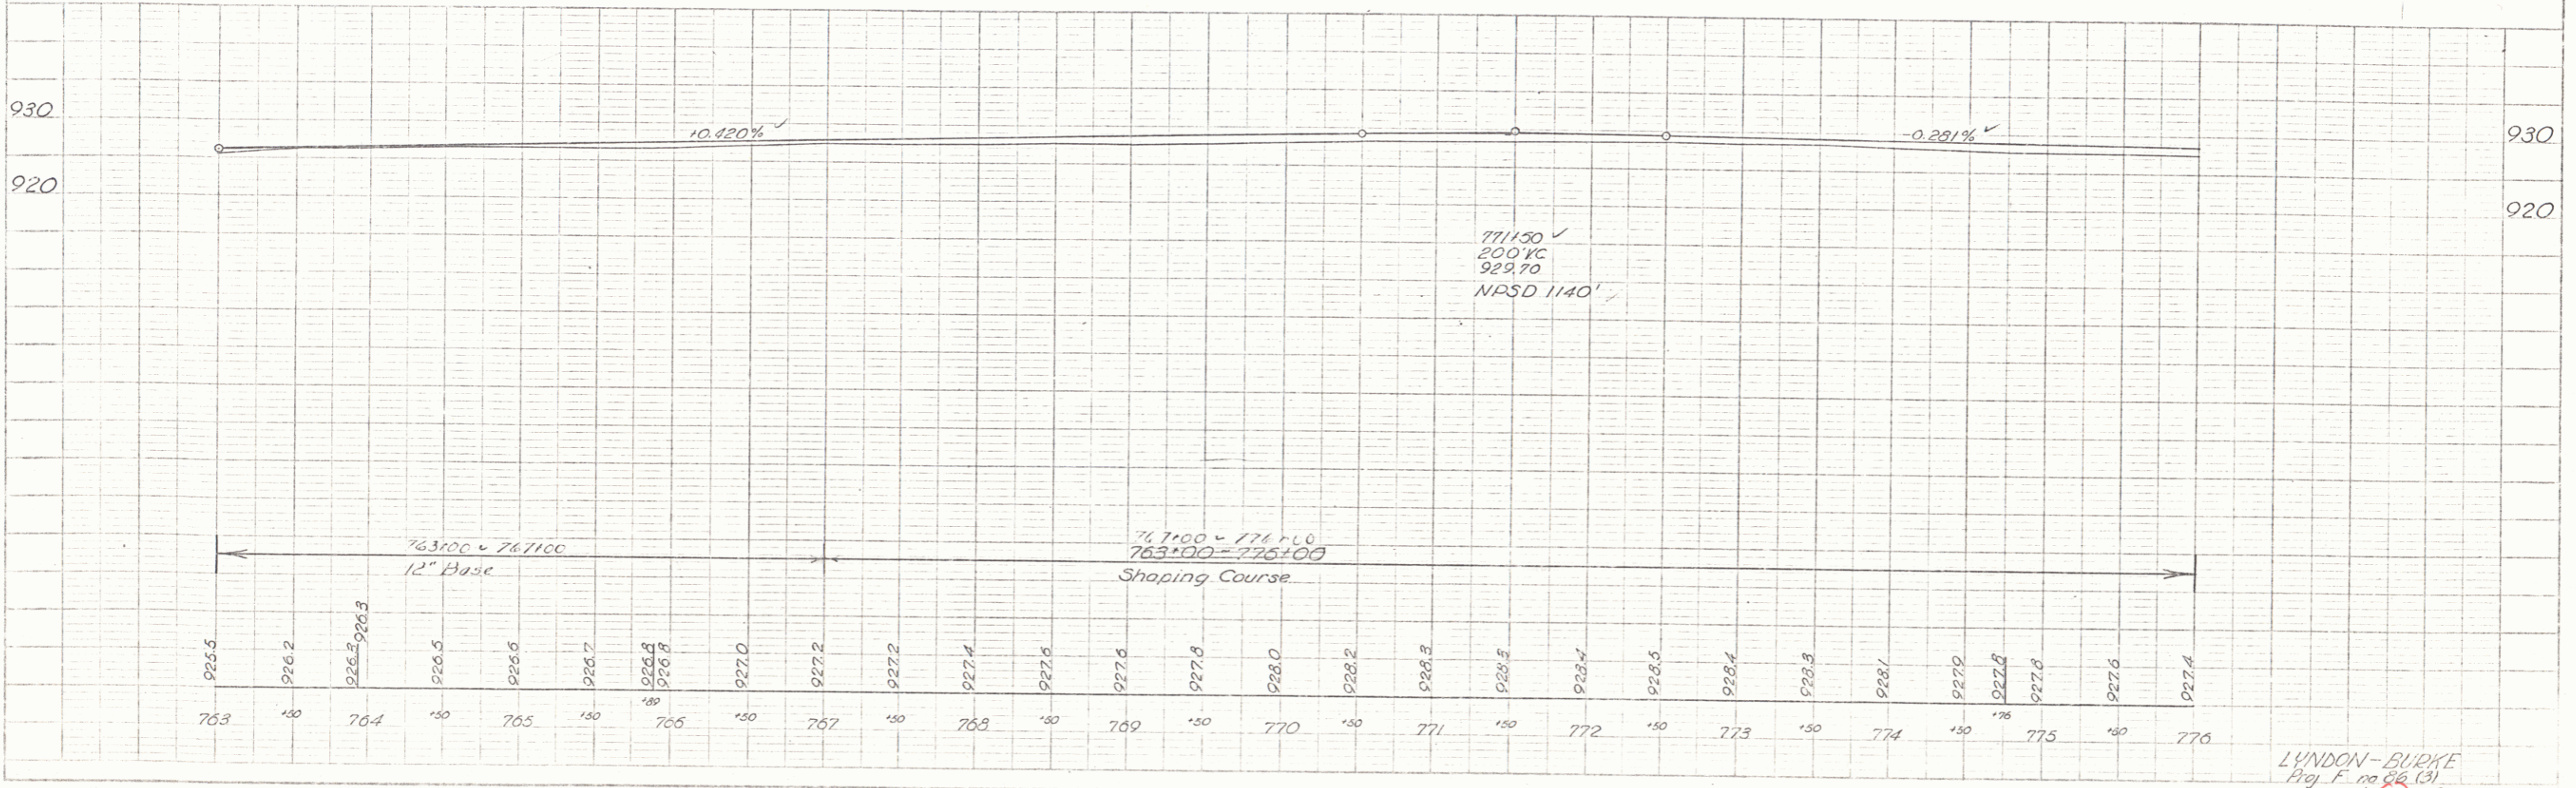

LYNDON-BURKE
 Proj. E. no. 226 (3)
 Sheet 36 of 173