

REMOVAL & DISPOSAL OF PRESENT GUARD RAIL
 781482 - 782+61 RT
 784172 - 785+00 LT
 784198 - 785+50 RT
 784190 - 782+02 RT
 784180 - 786102 LT
 785107 - 786+52 RT

CONSTRUCT DRIVE
 777130 RT
 781425 - 782+26 LT

CONSTRUCT APPROACH
 785+50 LT
 783+50 RT

TWO CABLE GUARD RAIL
 781450 - 782+55 RT
 783500 - 785+00 RT
 781460 - 783+44 RT
 783100 - 784+52 RT

WOOD GUIDE POSTS
 RT
 776100 - 777100
 777180 - 779+24
 789120 - 790100
 LT
 778502 - 789180

Δ 50° 13' 11"
 D 4'
 R 1132.7
 T 671.0
 L 1236.3
 E 149.7

C.O. EDNA G BALL
 #14 D 0.50 ACRE ±
 STA. 776+00 - 784+90 LT.


FRANKLIN G & LUCILLE K FAIRBANKS
 #15 0.29 ACRE ±
 STA. 786+60 - 793+50 LT.

ELWIN & PAULINE CROSS
 #16 B 0.83 ACRES ±
 STA. 789+50 - 793+50 RT.

C.O. EDNA G BALL

ELWIN & PAULINE CROSS
 #16A 0.53 ACRE ±
 STA. 777+70 - 784+25 RT

PARCEL INSTRUMENT DATE	GRANTOR	GRANTEE	RECORDED TOWN OF	BOOK	PAGE	DATE	REMARKS
15 WDOE	FRANKLIN G & LUCILLE K FAIRBANKS ST OF VT	ELWIN & PAULINE CROSS ST OF VT	BURKE	26	314	2-2-56	
16A,B,C WDOE	FRANKLIN G & LUCILLE K FAIRBANKS ST OF VT	ELWIN & PAULINE CROSS ST OF VT	BURKE	26	305	2-2-56	see also sheet 38

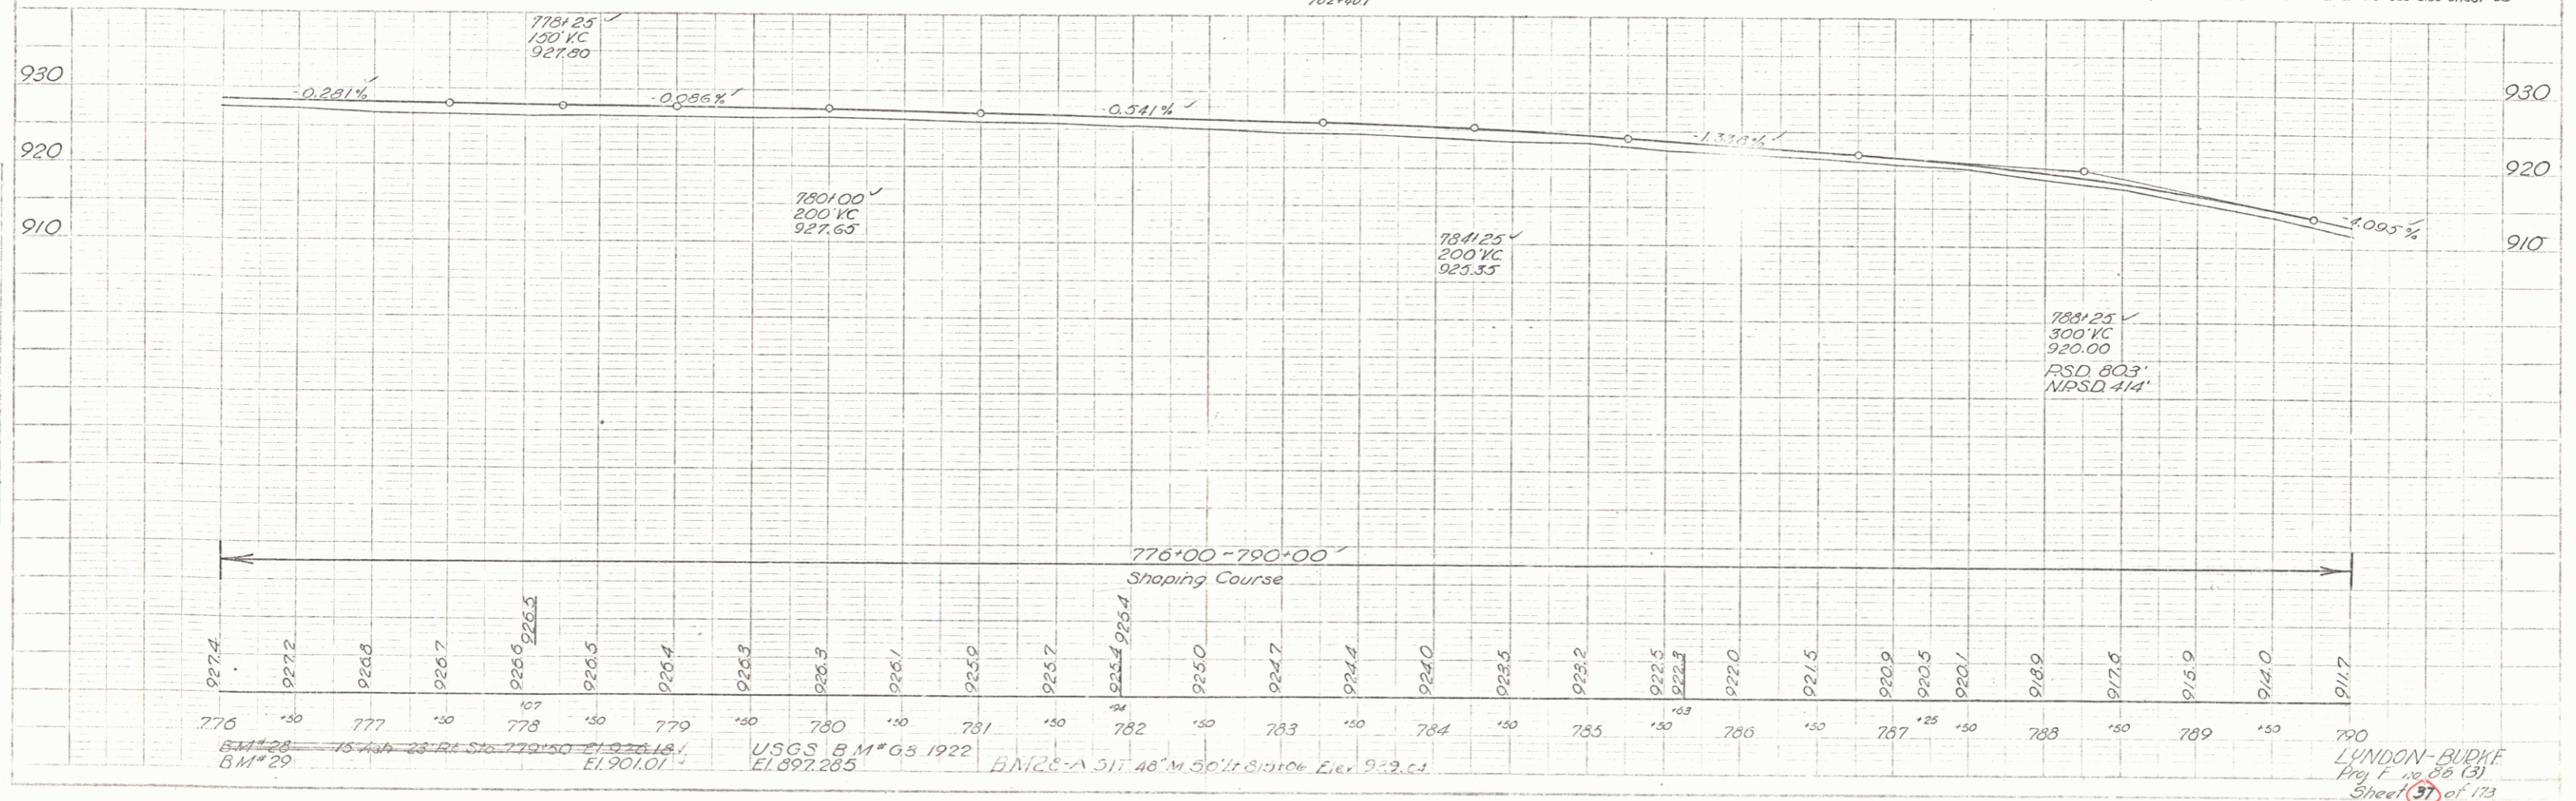

PLAN
 SCALE: 1" = 40'

PROFILE
 SCALE: 1" = 10'

LYNDON-BUDKE
 Proj. No. 56 (3)
 Sheet 37 of 173