


Δ 3°17' L^Δ
 D 1°
 R 5729.7
 T 164.2
 L 328.3
 E 23

CONSTRUCT DRIVES
 813+40 LT
 815+15 LT
 818+00 LT
 821+05 RT
 825+00 LT

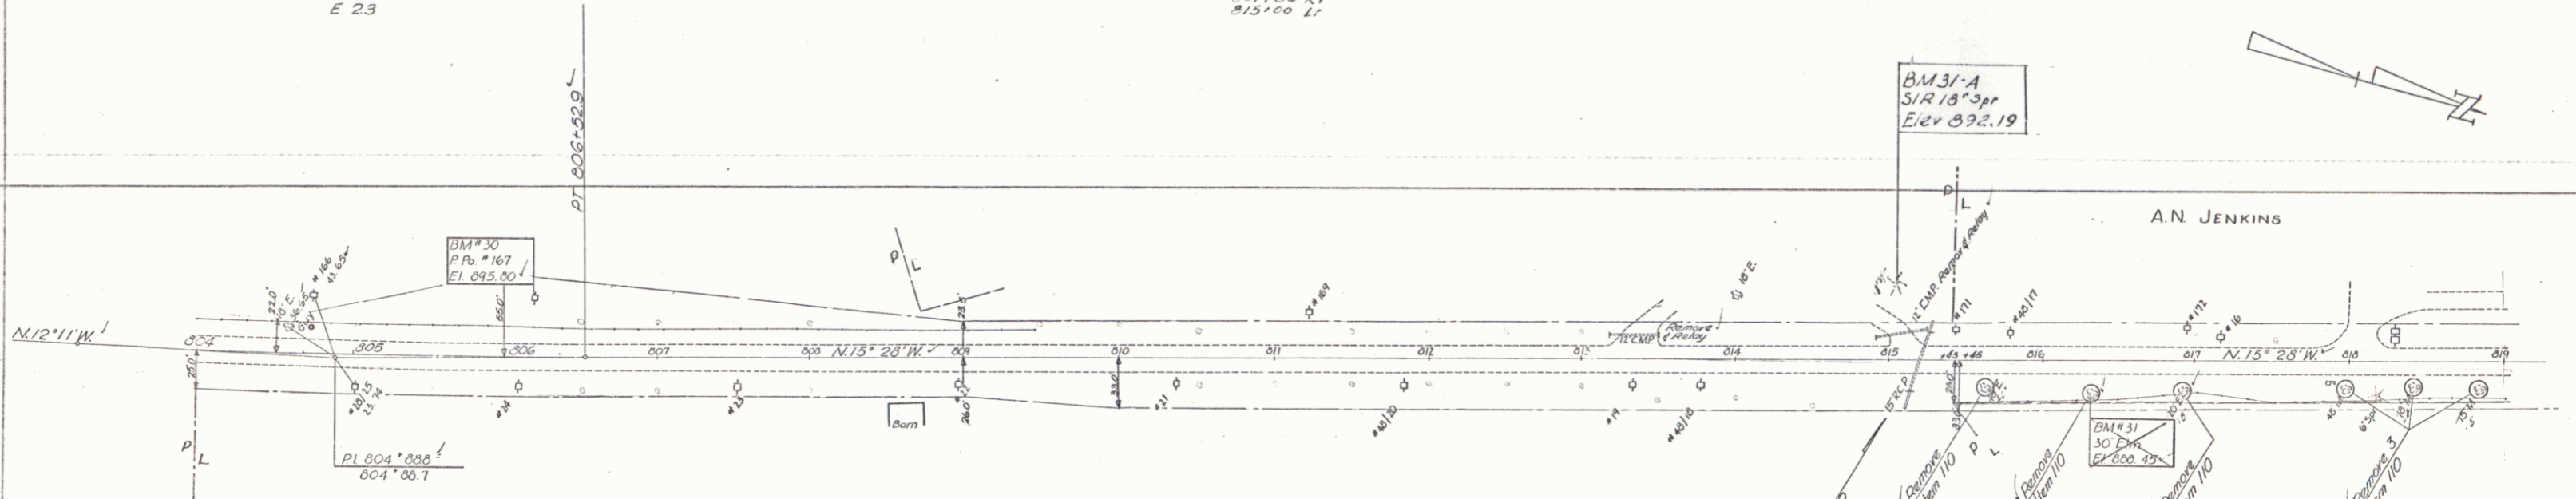


J.C. NEAYLE

A.N. JENKINS

W. J. & LILA M. BLAKE
 #17
 0.05 ACRE ±
 STA. 815+43 - 820+27 RT.

PARCEL	INSTRUMENT	DATE	GRANTOR	GRANTEE	RECORDED	TOWN OF	BOOK	PAGE	DATE	REMARKS
17	WDOE	11-8-55	W. J. & LILA M. BLAKE	ST OF VT	BURKE	BURKE	26	312	2-2-26	see also sheet 40

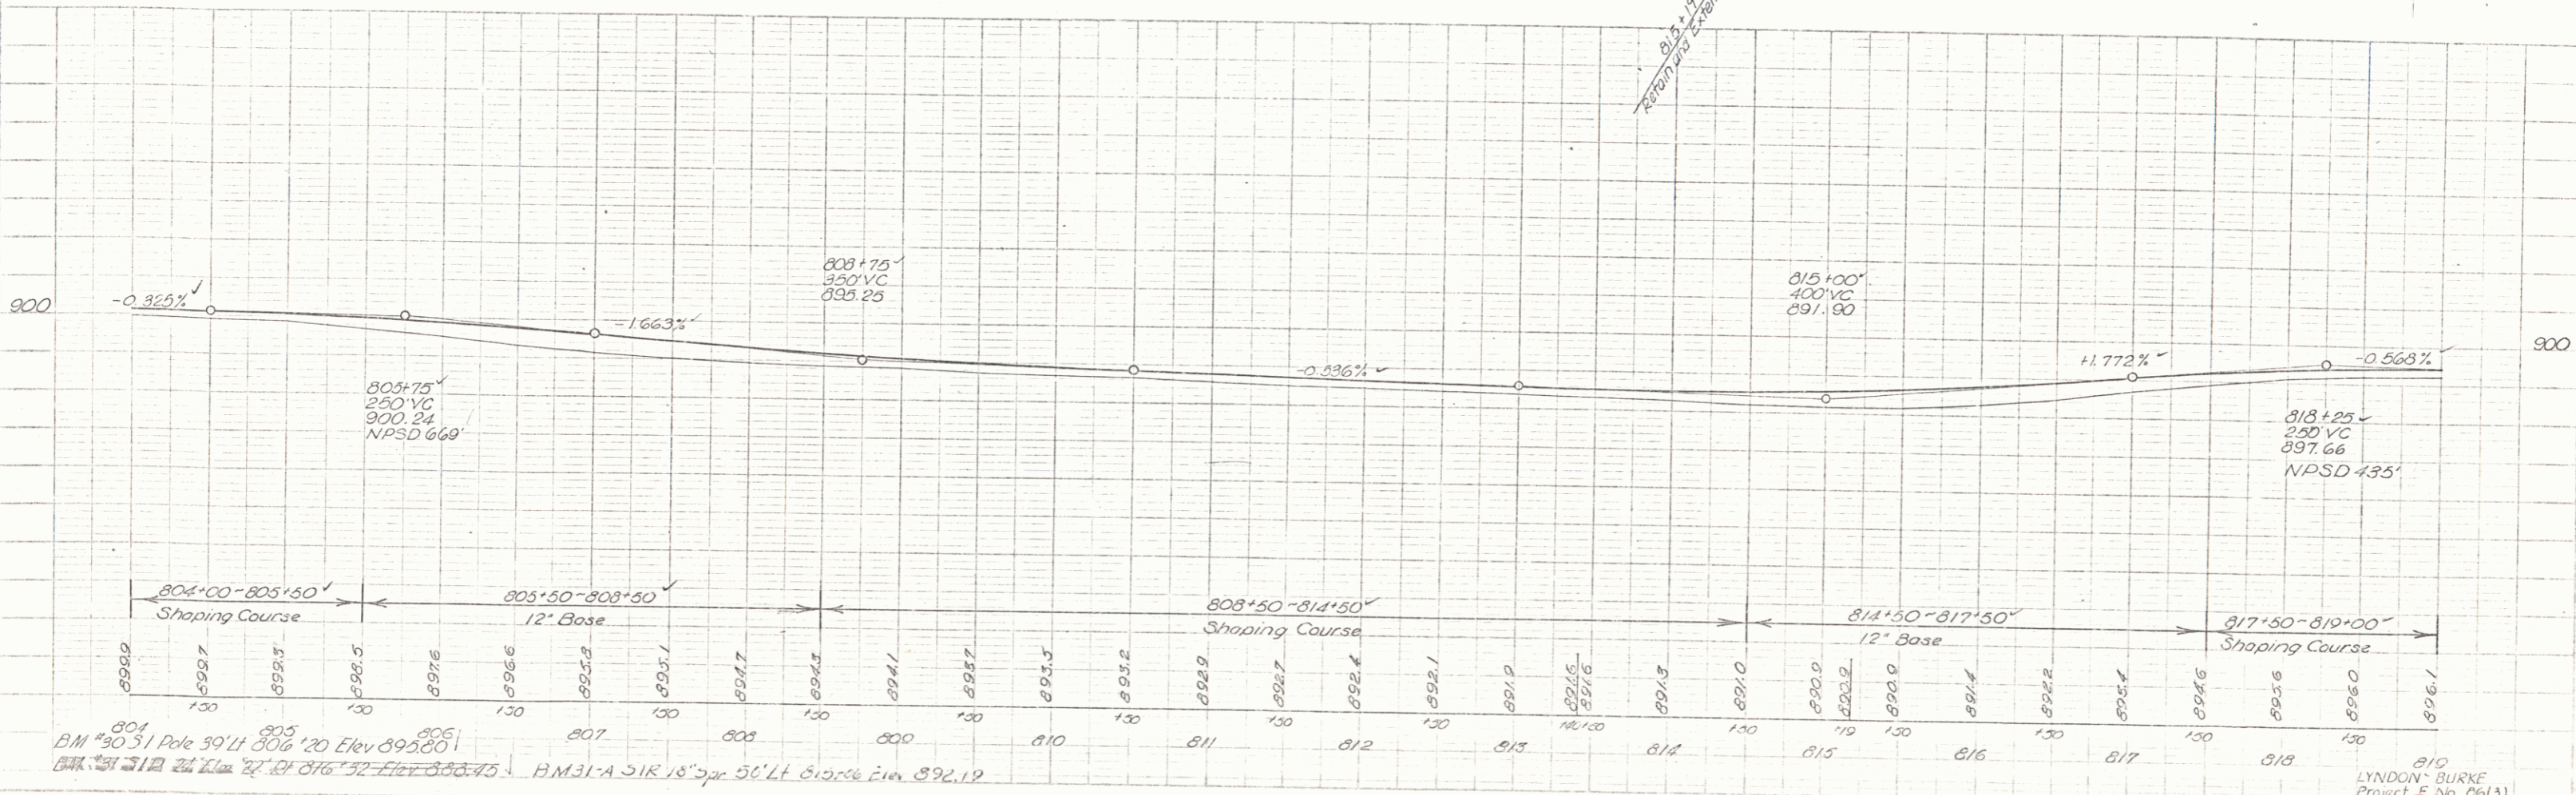

BM #30 P.B. #167 EL. 895.80
 BM #31 30' dia P.B. #200 EL. 897.49
 BM 31-A S1R 18°3pr Elev 892.19

LYNDON BURKE
 Project No 0613
 Sheet 39 of 173