
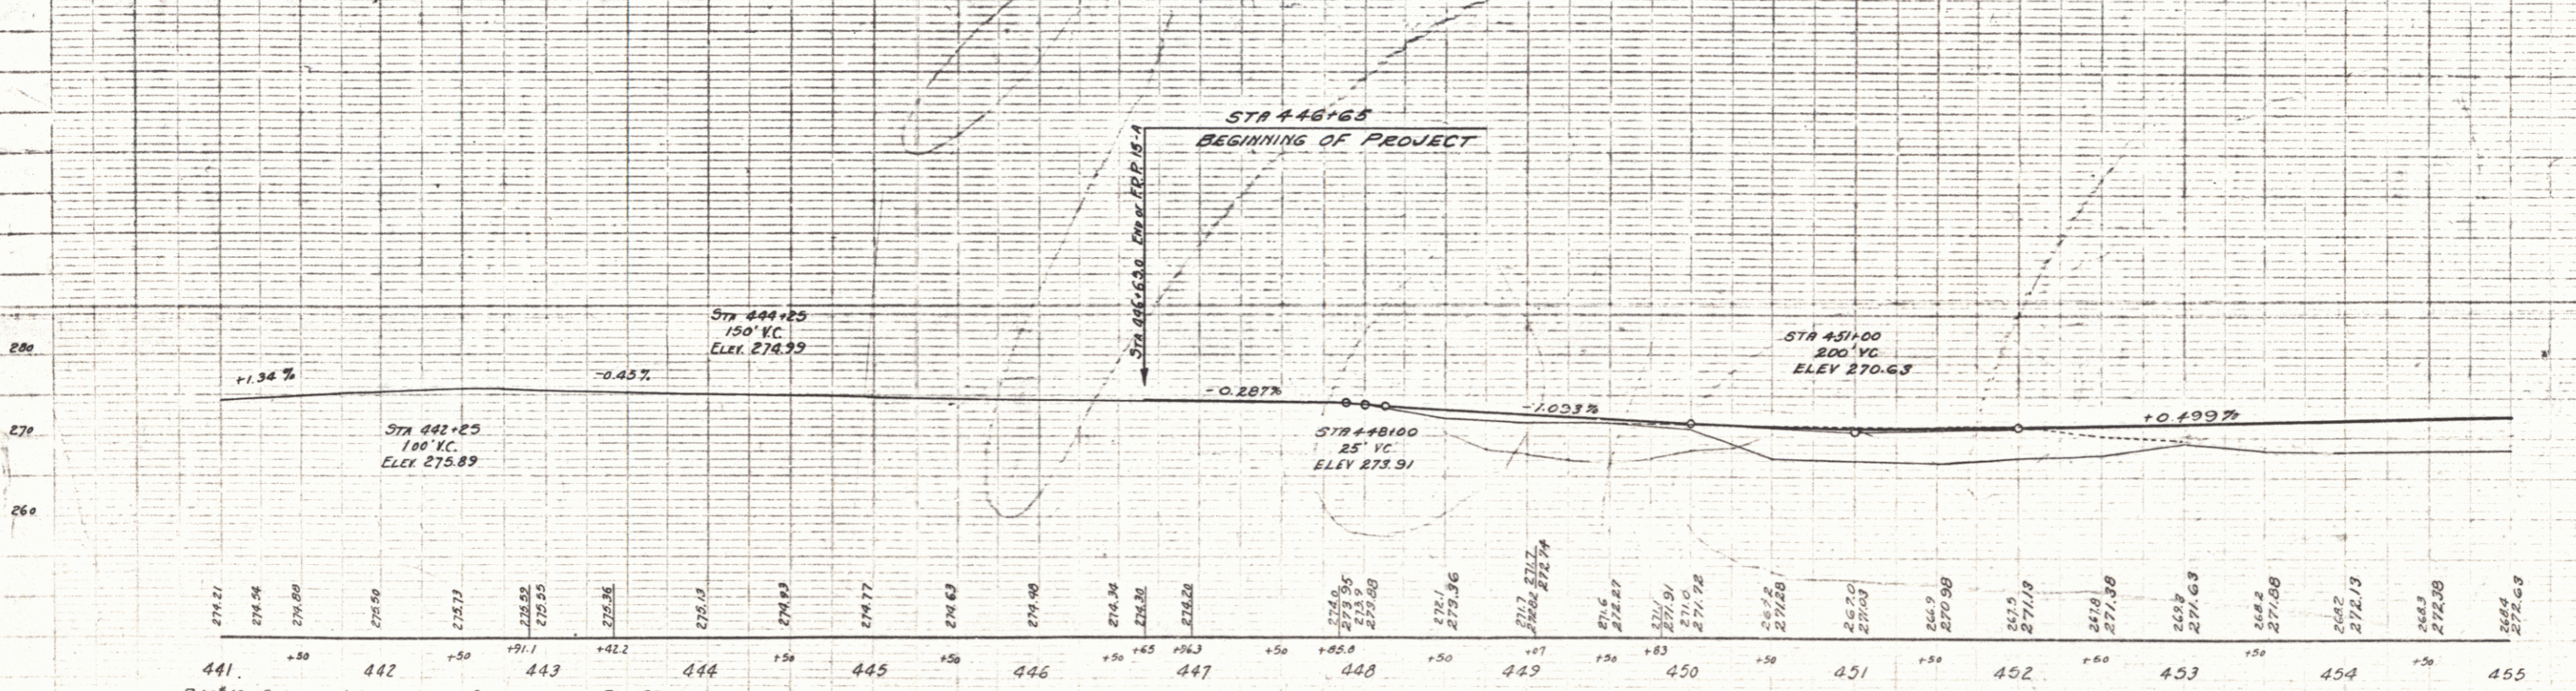


A. J. C. & S. Co.
 Civil Engineers
 1111 Broadway
 New York, N. Y.

A. J. C. & S. Co.
 Civil Engineers
 1111 Broadway
 New York, N. Y.

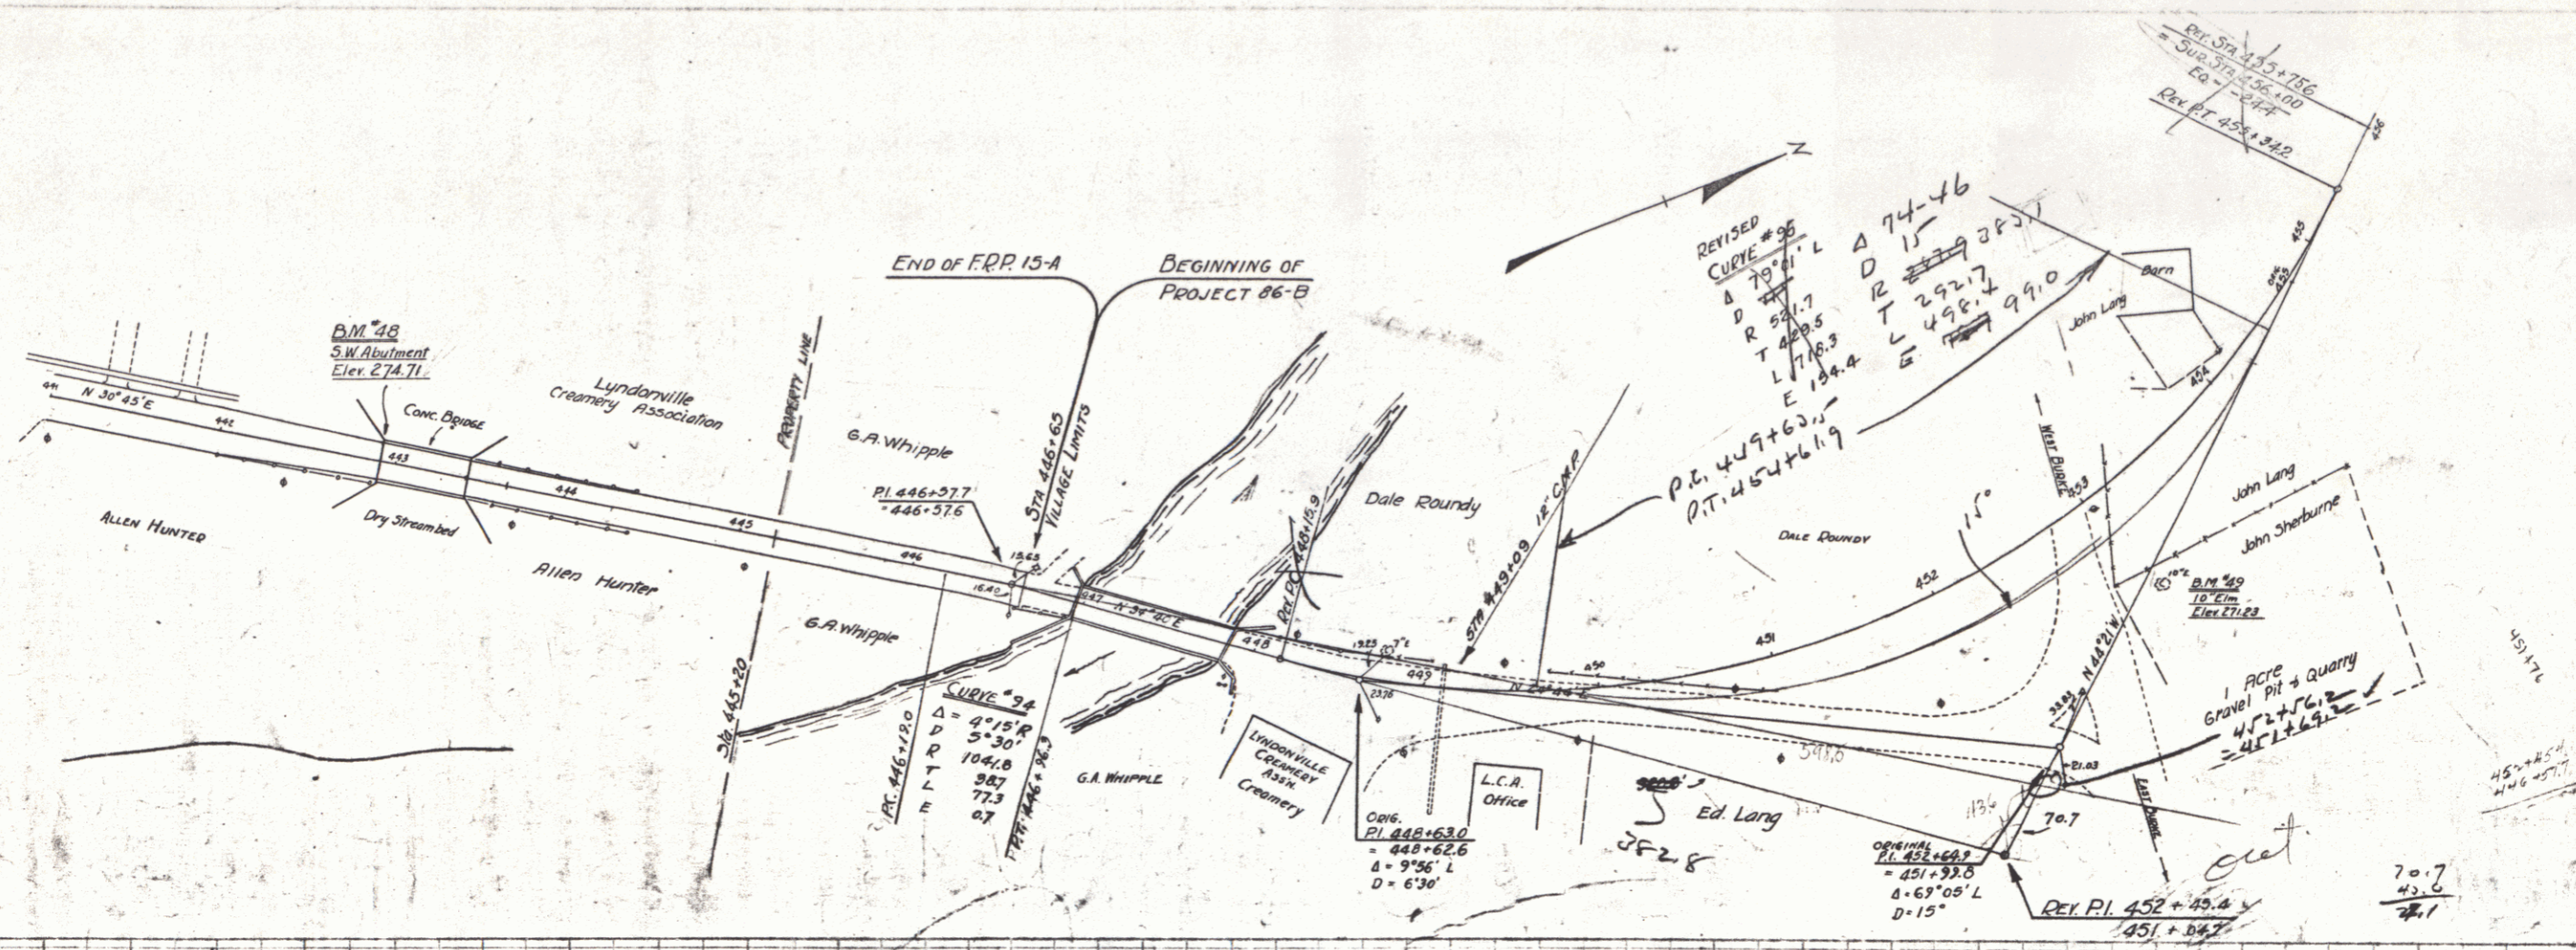

D.M. 48 SW corner bridge abutment Sta 442+92 Lt Elev 274.71
 D.M. 49 Spike in root 10' Elm Sta 453+20, 34' Rt Elev 271.23