



WOOD GUIDE POSTS REQUIRED
 Curb Sta Left Right
 519+55 2 2

NEW REIN. CONC. PIPE CULVERTS REQUIRED
 Sta. Diam. Leng. Cons. R. Steel, C.R.M.
 519+55 18" 40' 15 Cy. 157' 1.89.

NEW REIN. CONC. DRIVEWAY PILES REQUIRED
 Sta. Diam. Leng. Cem. Rub. Mas.
 520+11 L.R. 15" 40' 2.7 Cy. 2.7
 521+60 L.R. 15" 40' 2.7

DATE: 11/21/54
 SHEET: 9 OF 110

Parcel	Kind of Instrument	Date of Instrument	Grantor	Grantee	Recorded Lynden Book Page	Recorded Date	Remarks
B ¹	O.C.D.	3-15-32	EA. II. & ES. Lang	St. 477	14	275-4	6-12-32
A#8	"	4-1-32	MINF. D. Greene	"	34	153-260	6-11-32

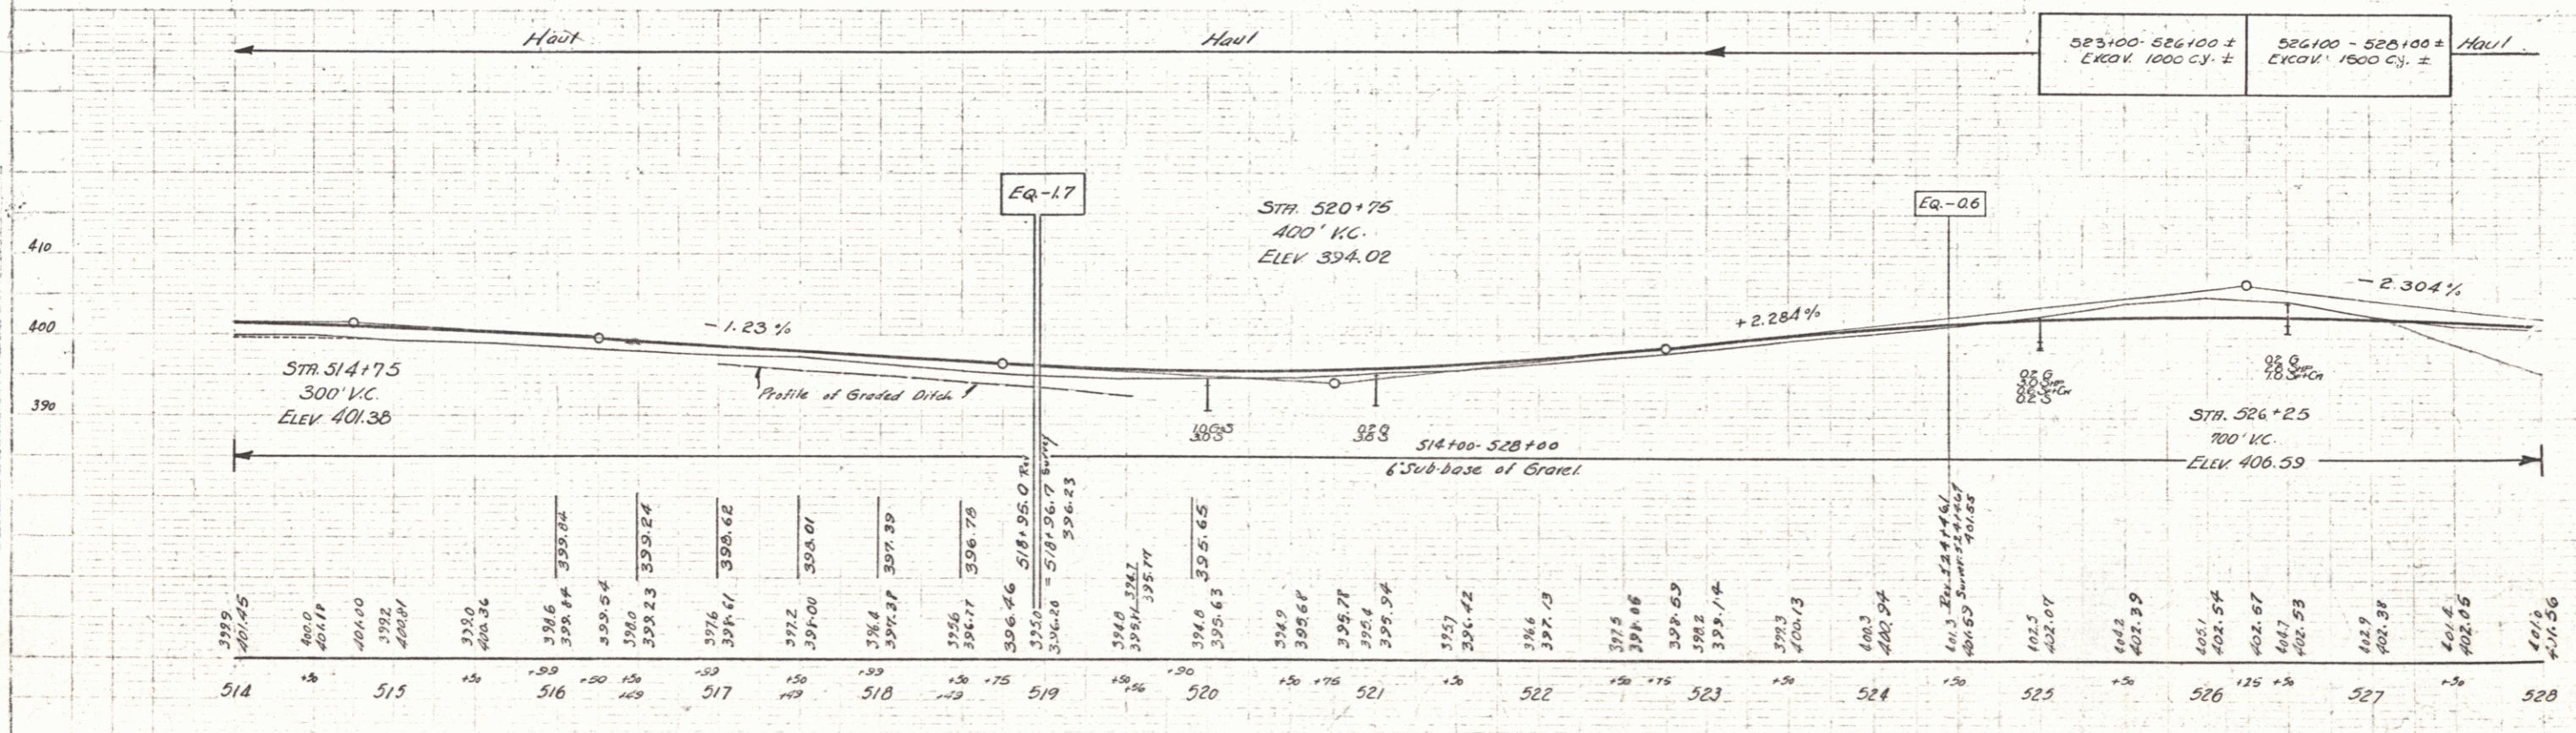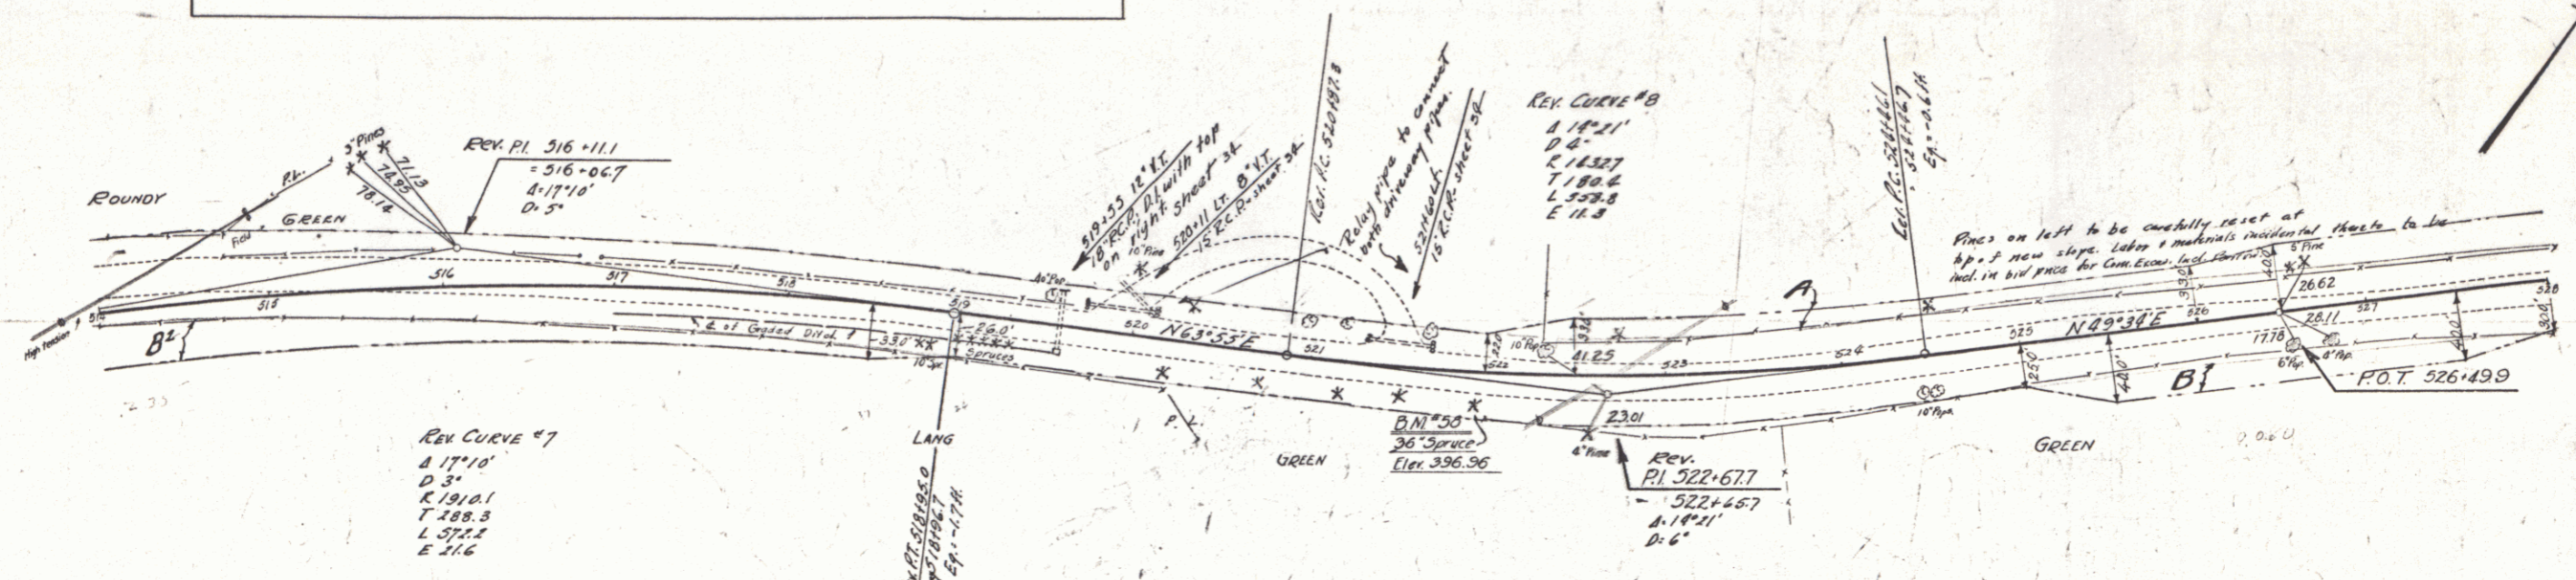

SERIES F No. 06C
 SHEET 9 OF 110