
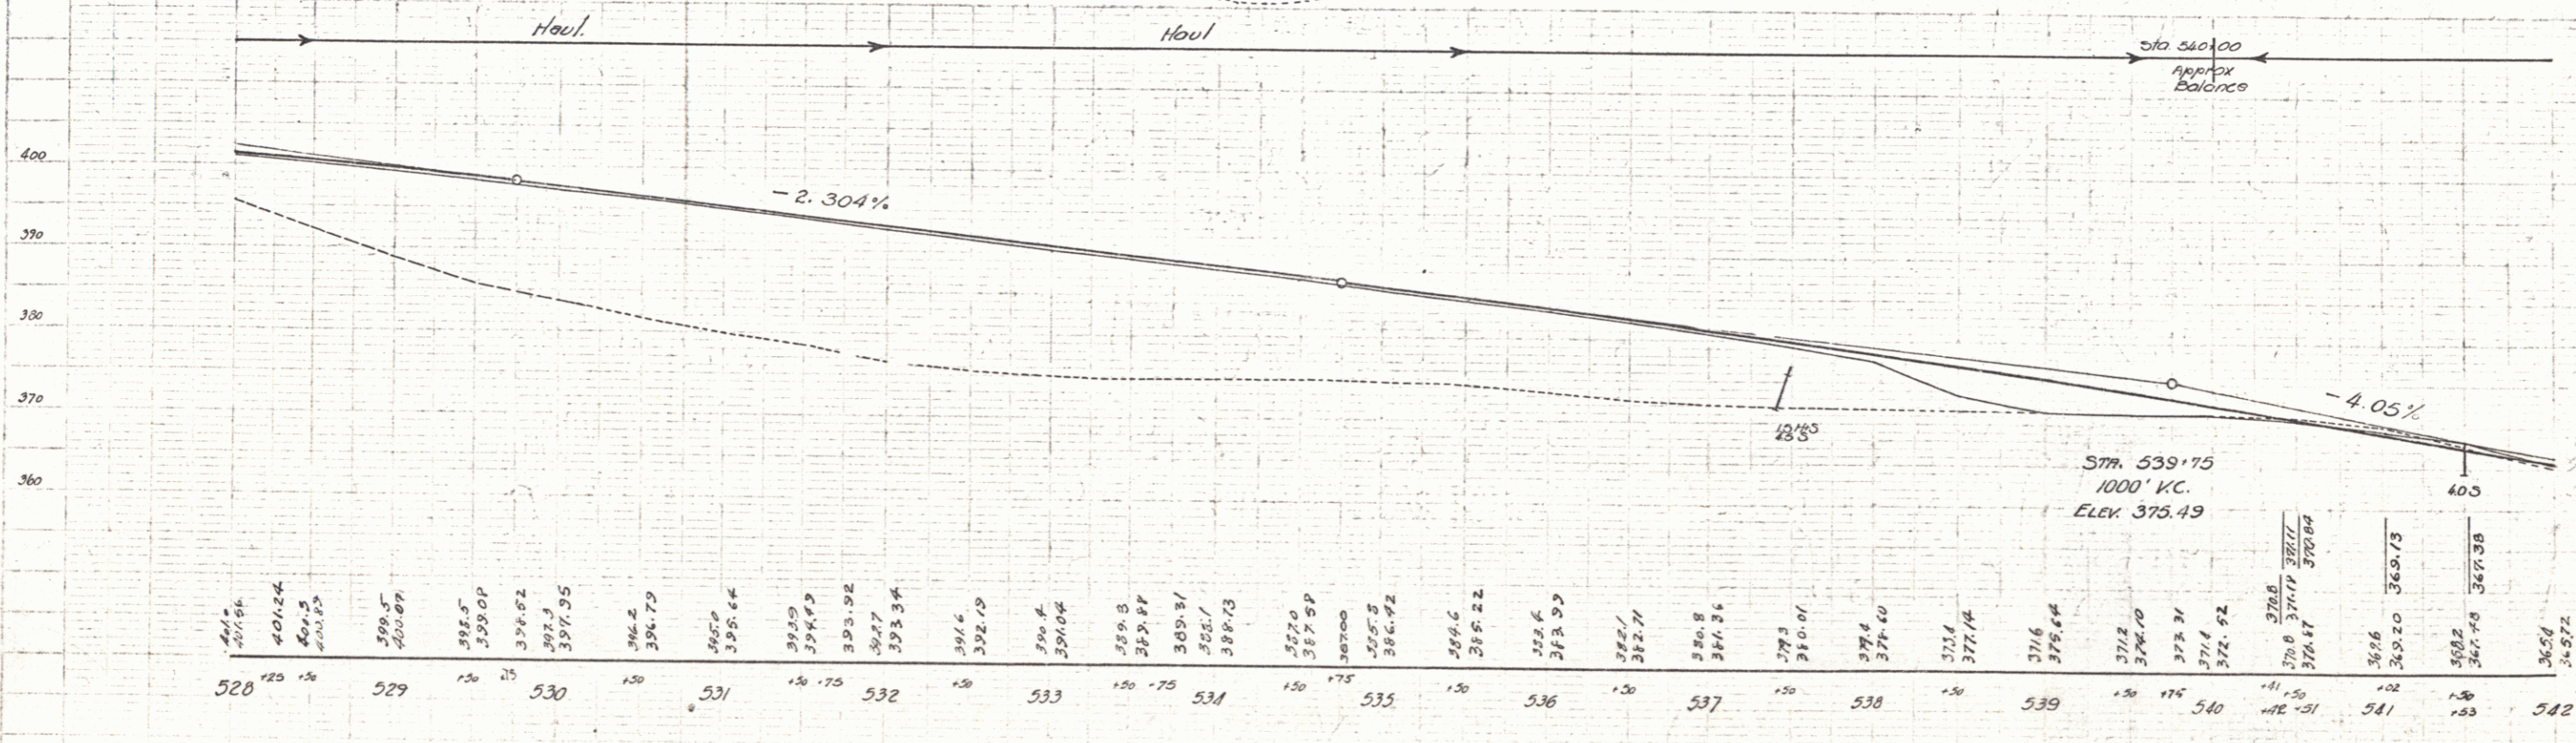


WOOD GUARD FENCE REQUIRED			CABLE GUARD RAIL REQUIRED			NEW REIN. CONC. PIPE CULVERTS REQUIRED						
Culv. Sta.	Left	Right	Stations	Length	Consp.	Ray/Length	Sta.	Diam.	Length	Consp.	Steel	C.R. M.
537+50	1	-	528+40-532+80 RL	40'	40'	45°	537+50	18"	111	1.64		
540+41	1	-	528+80-532+80 Lt	392'	40'	43°	537+50	18"	111	1.64		
			540+30-542+00 RL	170'	40'	21°	540+41					

Parcel	Kind of Instrument	Date of Instrument	Grantor	Grantee	Recorded	Remarks
A, C, D, 14, 2	G.C.D.	4-1-32	W.H. & F.D. Greene	Stoff	Book Page Date	6-11-32, Cully Sta. 531+50 to 537+50
"	"	5-15-32	Asst. In. Hubler & H. H. H. H.	"	3A 257-9	5-17-32
"	"	8-15-32	Harry Von Geer	"	3A 251	3-17-32

STATE OF ILLINOIS  
 COUNTY OF COOK  
 86 C 1931 10 16

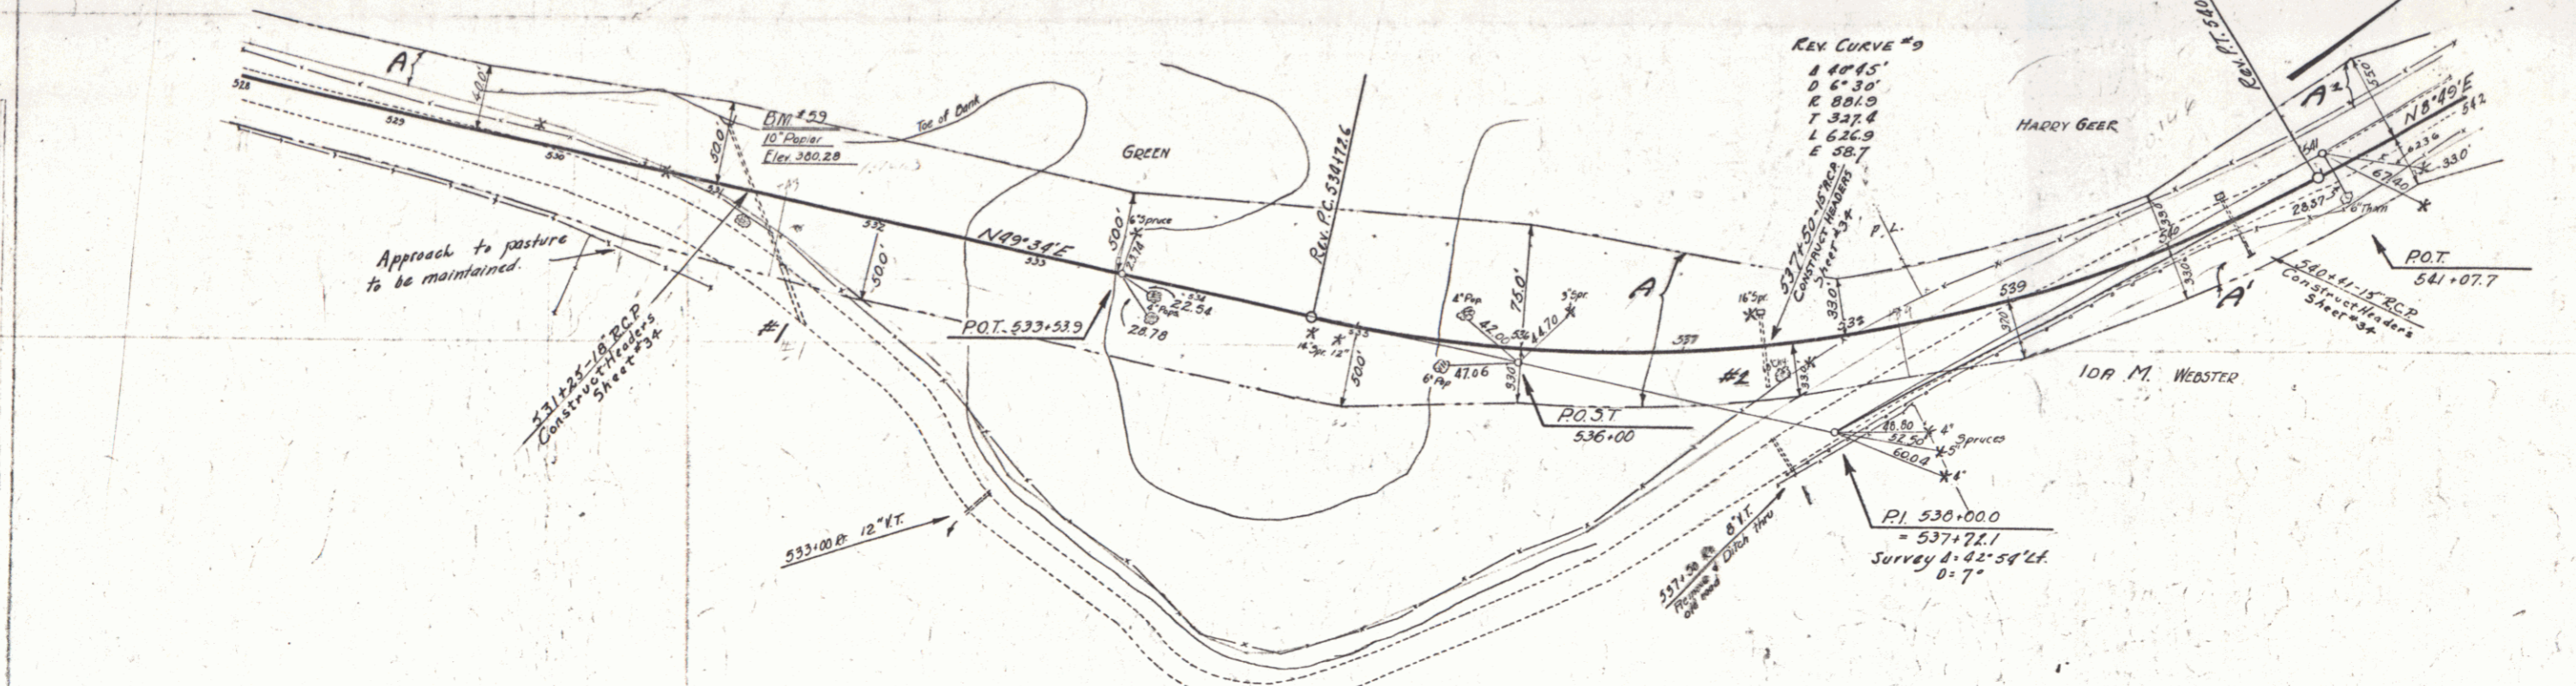

SERIES F. N° 86 C  
 SHEET 10 OF 110

10