
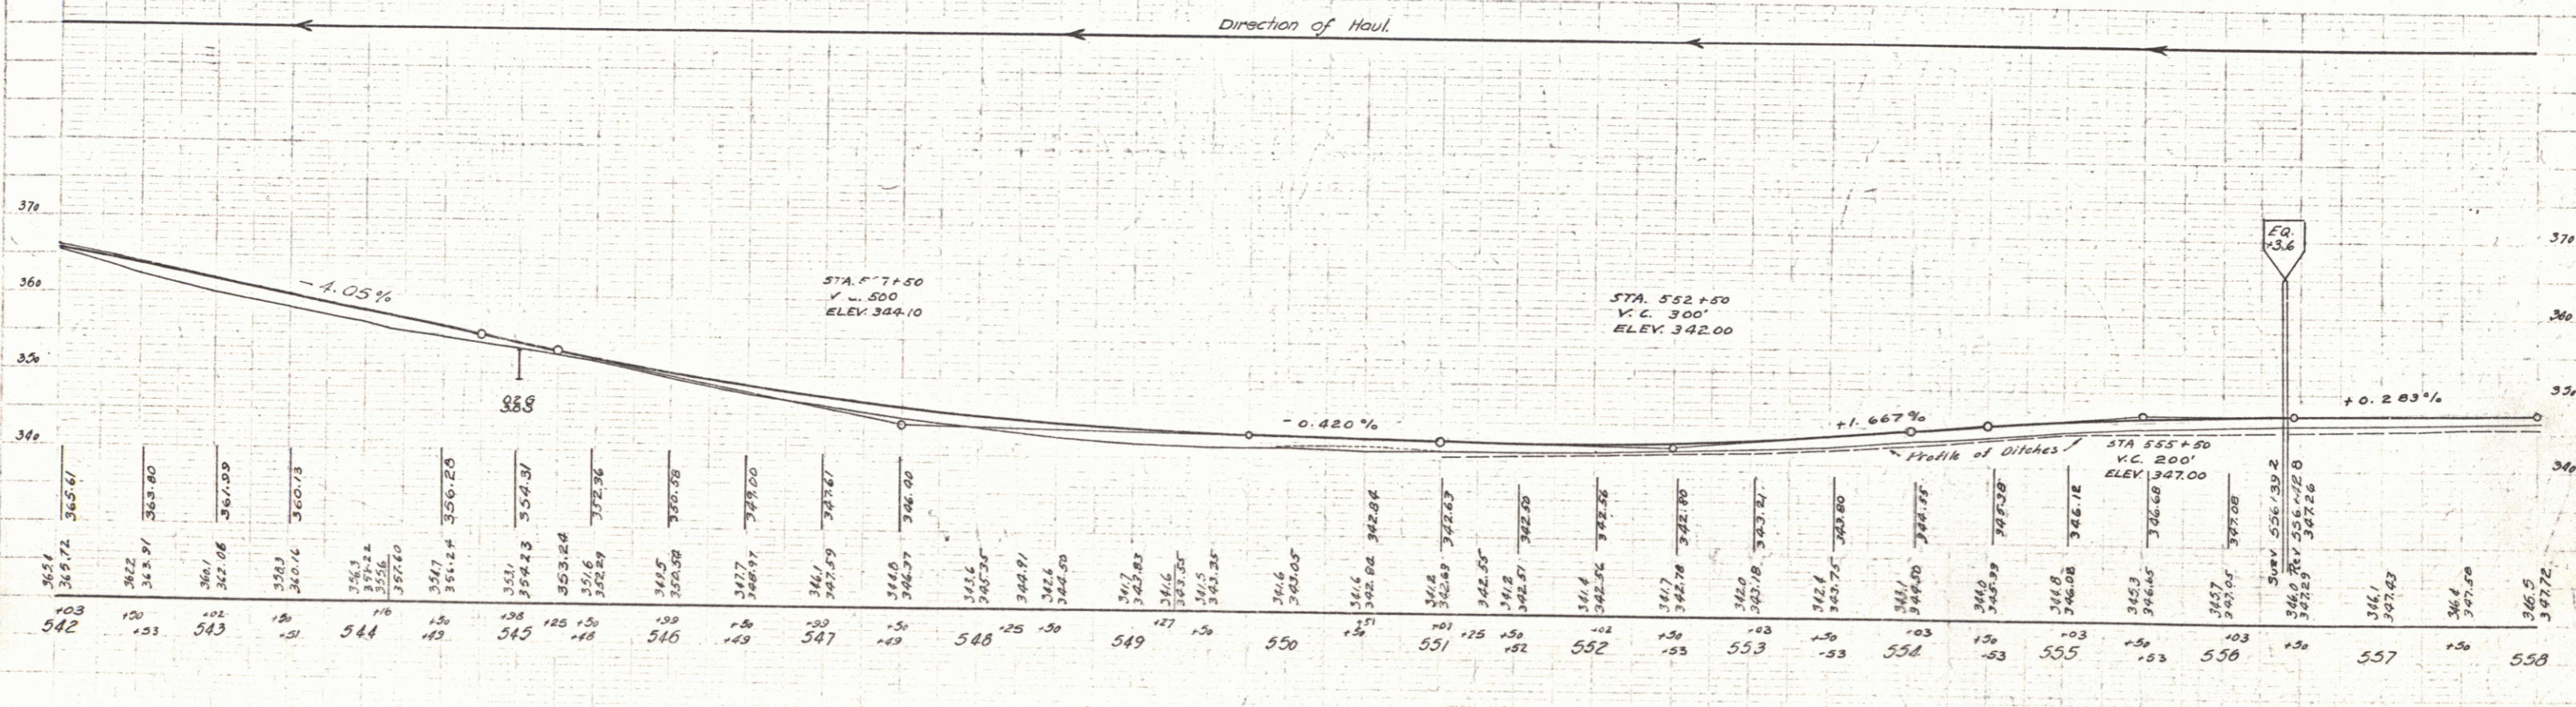


WOOD GUIDE RAIL REQUIRED		CABLE GUARD RAIL REQUIRED			NEW REIN. CONC. PIPE GUTTERS REQUIRED						
Sta	Left Right	Stations	Lang	Concl	Qty/ft	Sta	Diam	Lang	Conc	Steel	CR 171
545+27	-	544+00-544+66.83	24"	40'	286'	544+14	18"	40'	100%	44"	1.5
		544+27	76"	40'	136'	549+27	18"	40'			7.0%

WOOD GUIDE POSTS REQUIRED	
Sta	Left Right
544+16	R

GROUTED CABLE GUTTER REQUIRED					
Stations	Width	Area			
544+16 culv outlet	3'-0"	10 sq yds			

Parcel	Kind of Instrument	Date of Instrument	Grantor	Grantee	Recorded Location	Remarks
A & B	G.C.D.	3-15-32	Harry & Vera Geer	Stef A	3A 237	5-1-32
A & C	"	3-15-32	Harry & Vera Geer	Stef A	3A 237-9	5-1-32
A	"	3-15-32	A.A. Webster	"	3A 250	5-17-32

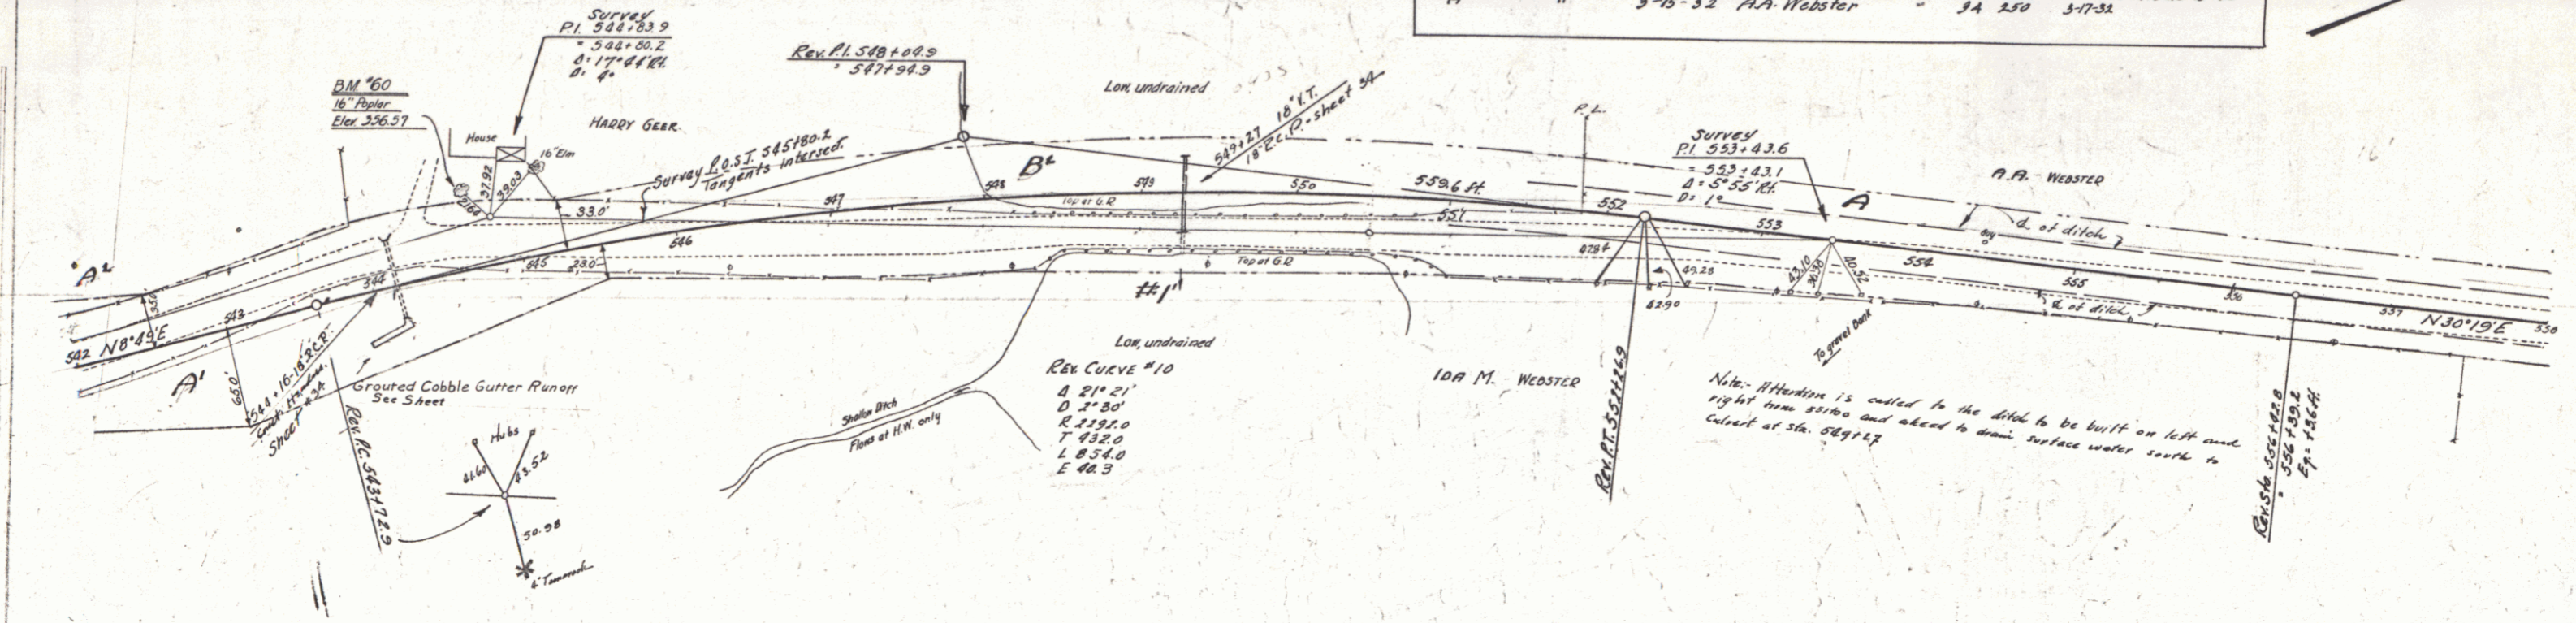

SERIES F. N° 86C
SHEET 11 OF 16