
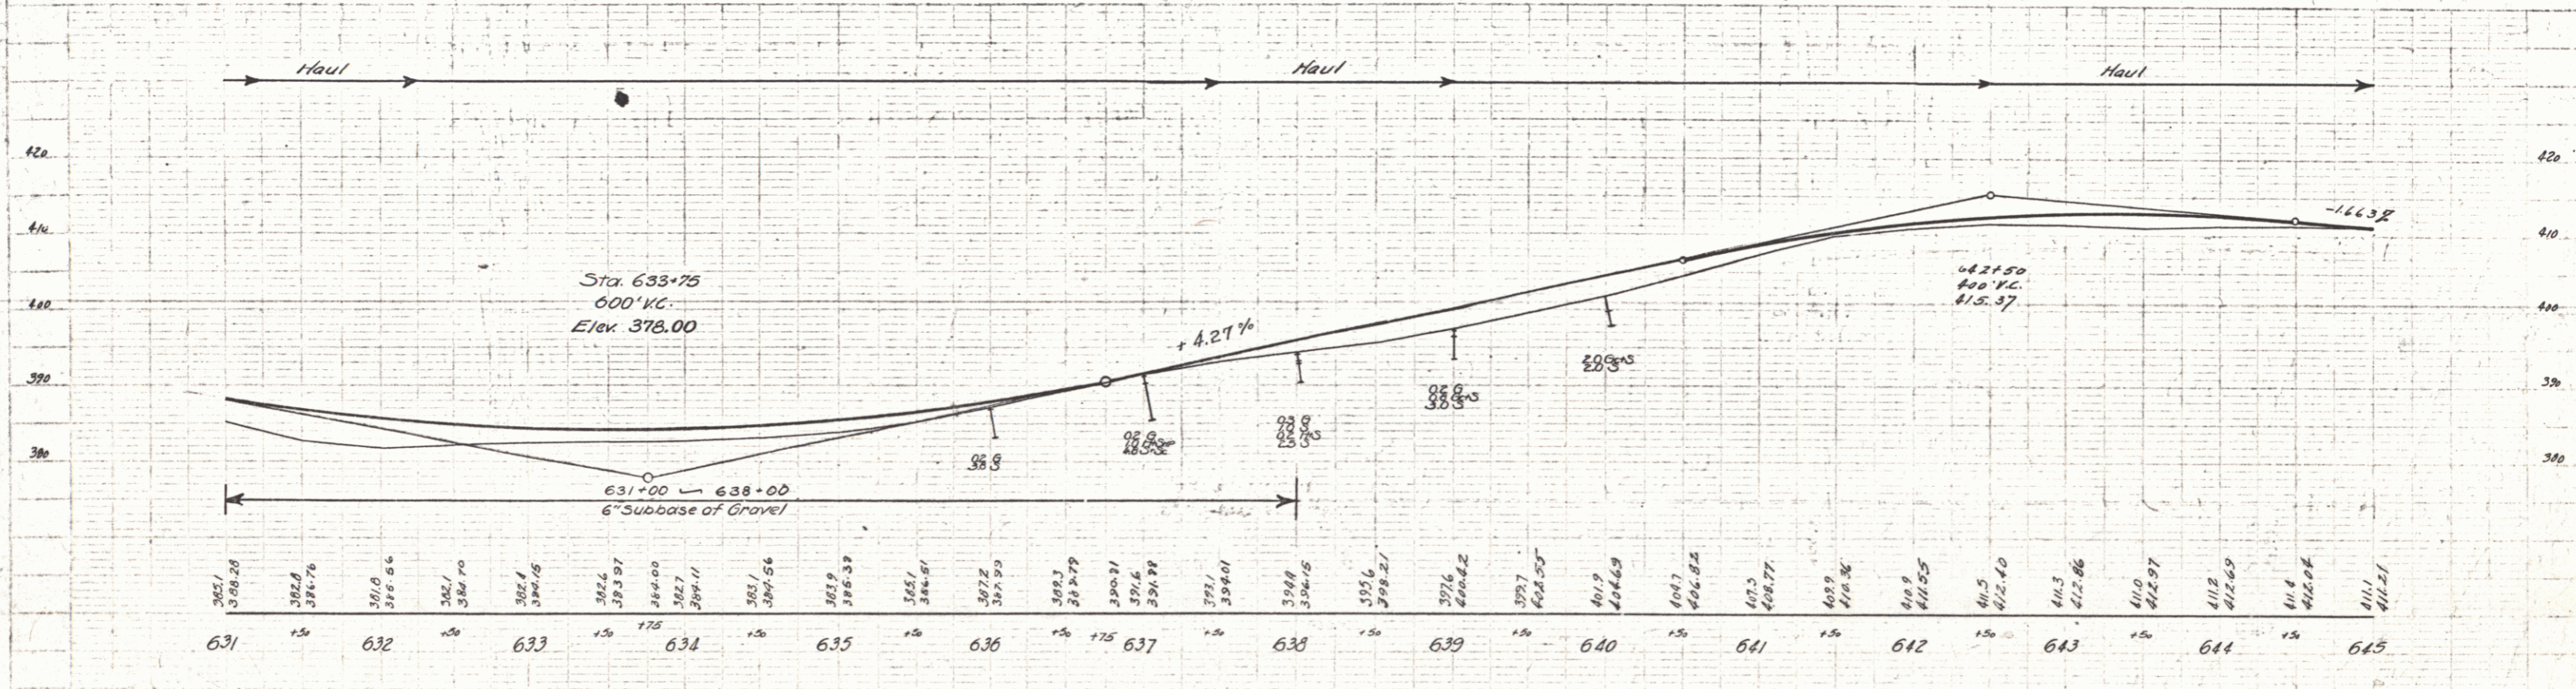


Wood Guard Rail		CABLE GUARD RAIL REQUIRED			NEW REIN. CONC. PIPE CULVERTS REQUIRED					
Culv. Sta.	Left	Right	Stations	Long. Const.	Qty. Long.	Sta.	Diam.	Length	C.E.M.	Steel
638+50	24'	24'	631+00-638+00	500	20'	320	638+50	15"	48'	1.27

Parcel	Kind of Instrument	Date of Grant	Grantor	Grantee	Recorded	Remarks
B, C, Culv. #1	G.C.D.	5-25-32	Leah, Leah Ware	St of MA	190	Book Page Date
A	"	8-19-32	C.N. Darling	"	154	8-31-32

STATE	PLANS	DATE	SCALE
VT	86 C	1931	1" = 100'

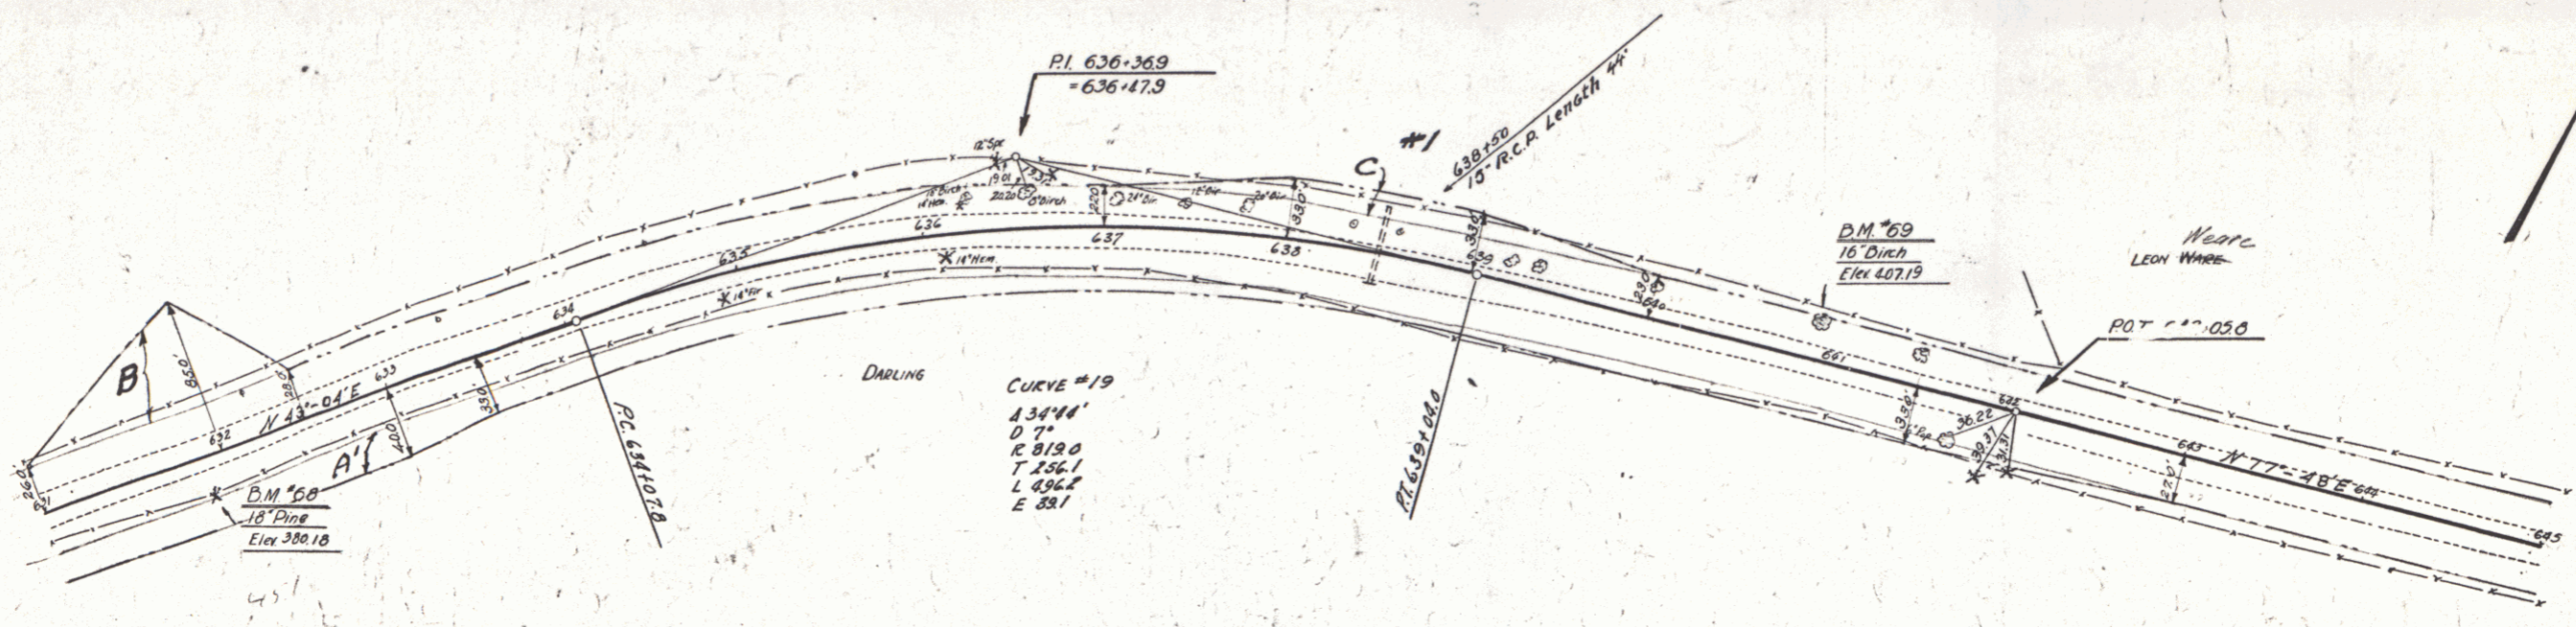

Sta.	Elev.	Sta.	Elev.	Sta.	Elev.	Sta.	Elev.	Sta.	Elev.	Sta.	Elev.
631	385.1	632	386.56	633	387.15	634	388.11	635	389.33	636	390.79
637	390.31	638	391.6	639	392.42	640	393.7	641	395.07	642	396.49
643	400.82	644	402.7	645	404.3						

SERIES F N° 86 C
SHEET 17 OF 110