
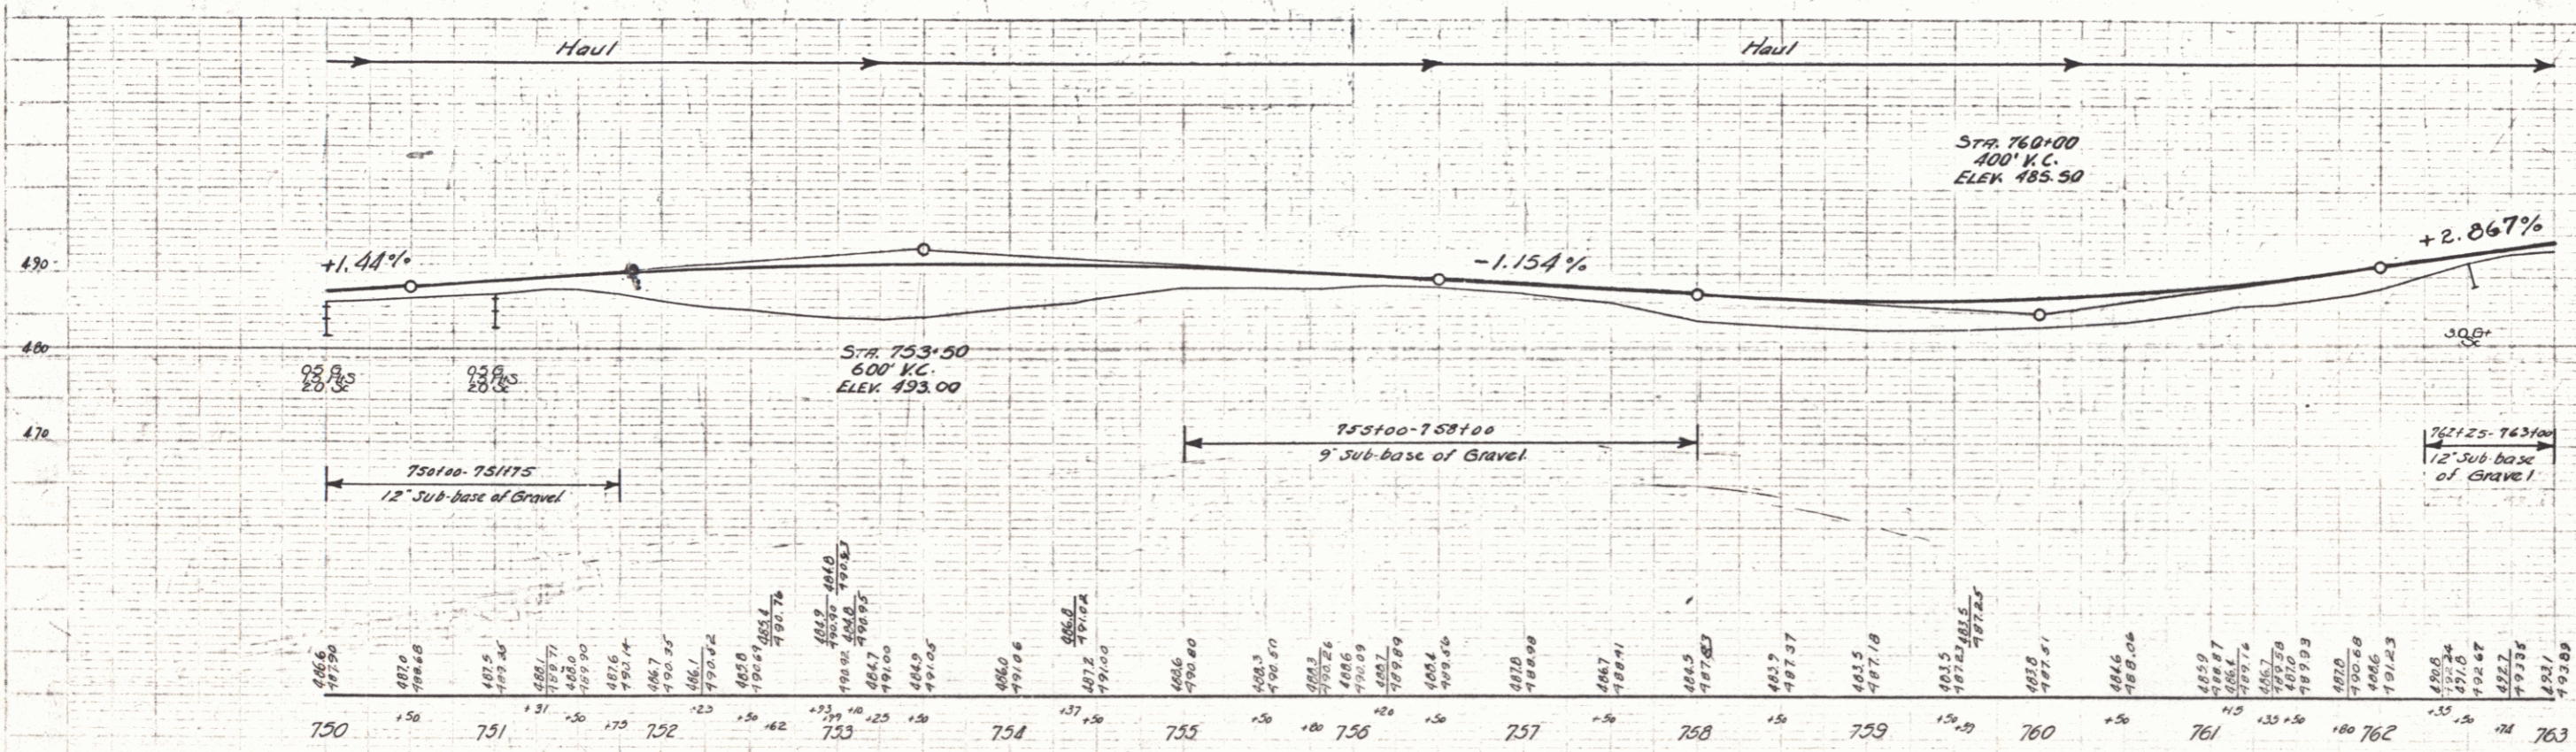


WOOD GUARD RAIL REQUIRED		CRACK GUARD RAIL REQUIRED		NEW BENT CONC. PIPE CULVERTS REQUIRED			RAINING CONC. BOX CULVERTS REQUIRED			
Cul. Sta	Left	Right	Stations	Long	Const.	By/long.	Station	Size	Conc.	R. Steel
7591.59	24'	24'	7521.93 RL	48'	40'	88'	7511.15	18"	44"	3.0 c.y.
			7521.93 RL	48'	40'	88'				
			7521.93 RL	48'	40'	88'				

Parcel	Kind of Instrument	Date of Instrument	Grantor	Grantee	Recorded Book Page	Date	Remarks
A.B. & C. #2	O.C.D.	5-27-32	H.J. & Mauda	Road St of W.	130	180	8-11-33 Cul. Sta. 7521.93
A. & C. #1	"	5-25-32	C.O. & Edna Bull	"	130	111	5-30-32 " 7591.59

FED. ROAD DIST. NO.	STATE	PROJECT NO.	SHEET NO.	TOTAL SHEETS
9	VI.	86 C	1931	25

WOOD GUARD POSTS REQUIRED		
Sta	Left	Right
7611.15	1	2

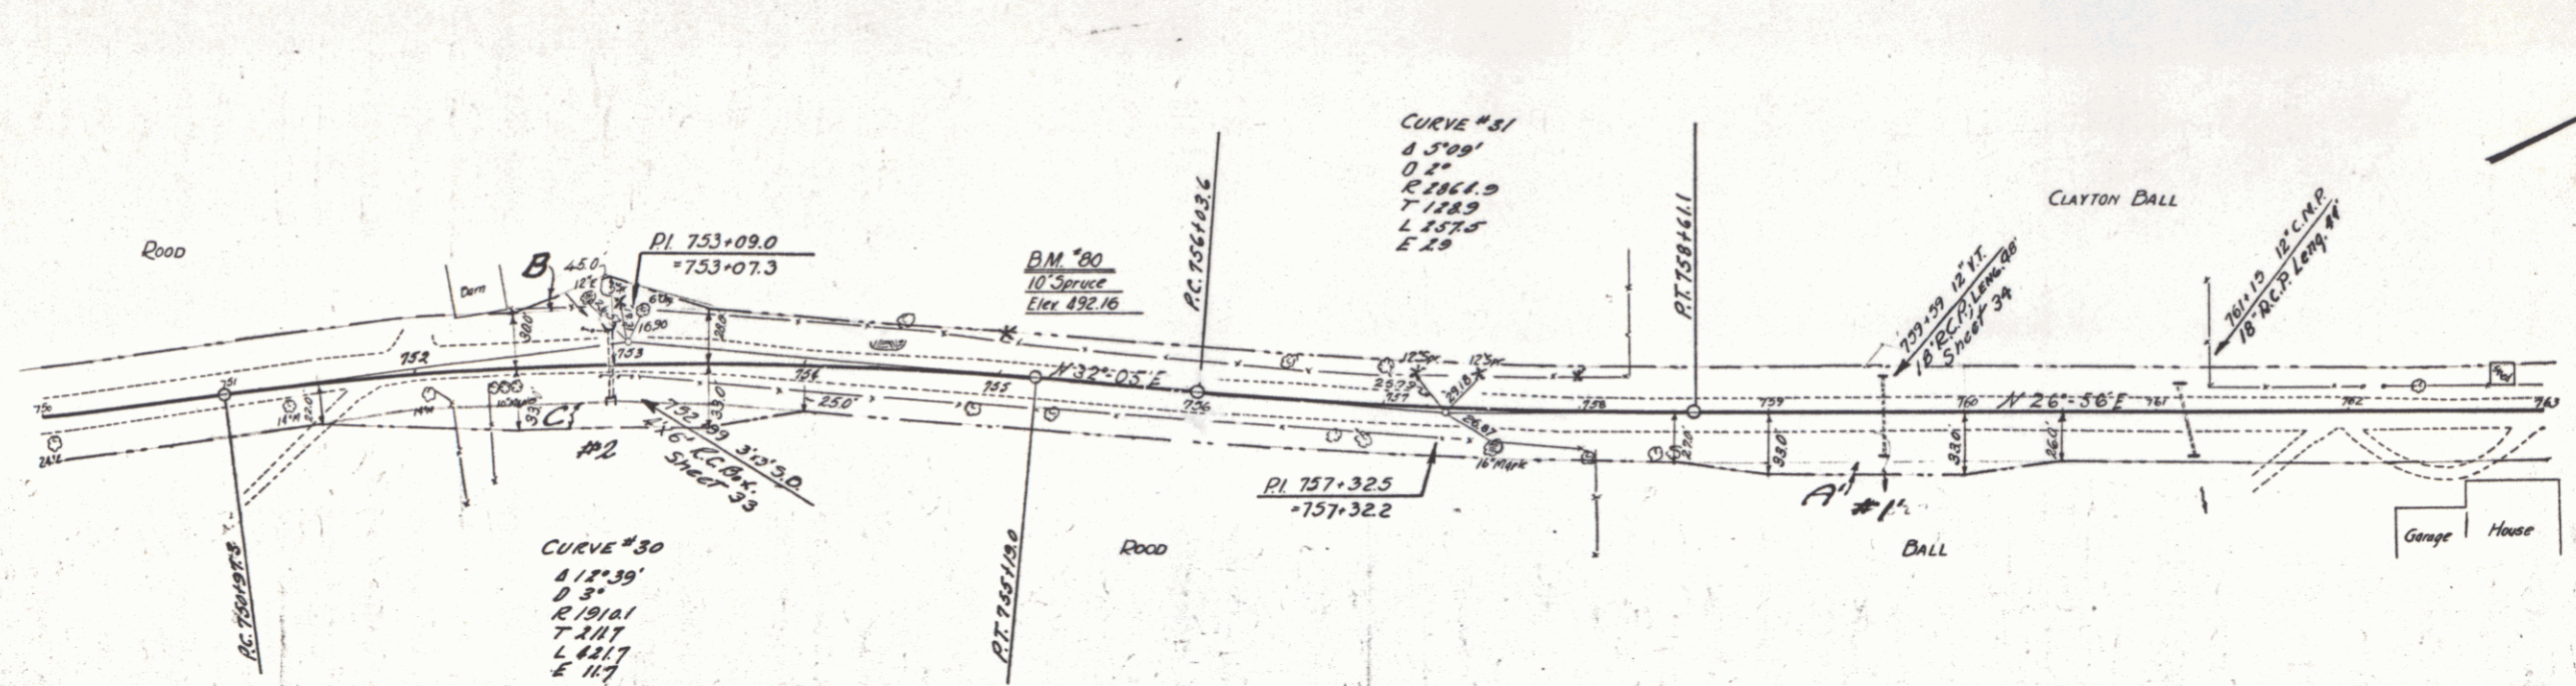

SERIES F N° 86C  
SHEET 25 OF 110

26