

WOOD GUARD RAIL REQUIRED

Qty	Left	Right
765+91	1	2
776+82		

WOOD GUIDE POSTS REQUIRED



Sta	Left	Right
765+91	1	2
774+87	2	2

NEW REINF. CONC. PIPE CULVERTS REQUIRED

Station	Diam	Len	Conc.	C.R.P.	Stee
765+91	15"	40'	1.5cy	1.5cy	17#
774+87	15"	40'	1.4cy		11#

Parcel	Kind of Instrument	Dates of Instrument	Grantor	Grantee	Recorded Book	Recorded Page	Date	Remarks
B'	G.C.D.	5-25-32	Co. & Edw. Ball	Stofft, P.C. III	111	530-32		

86C 1931 26 11a

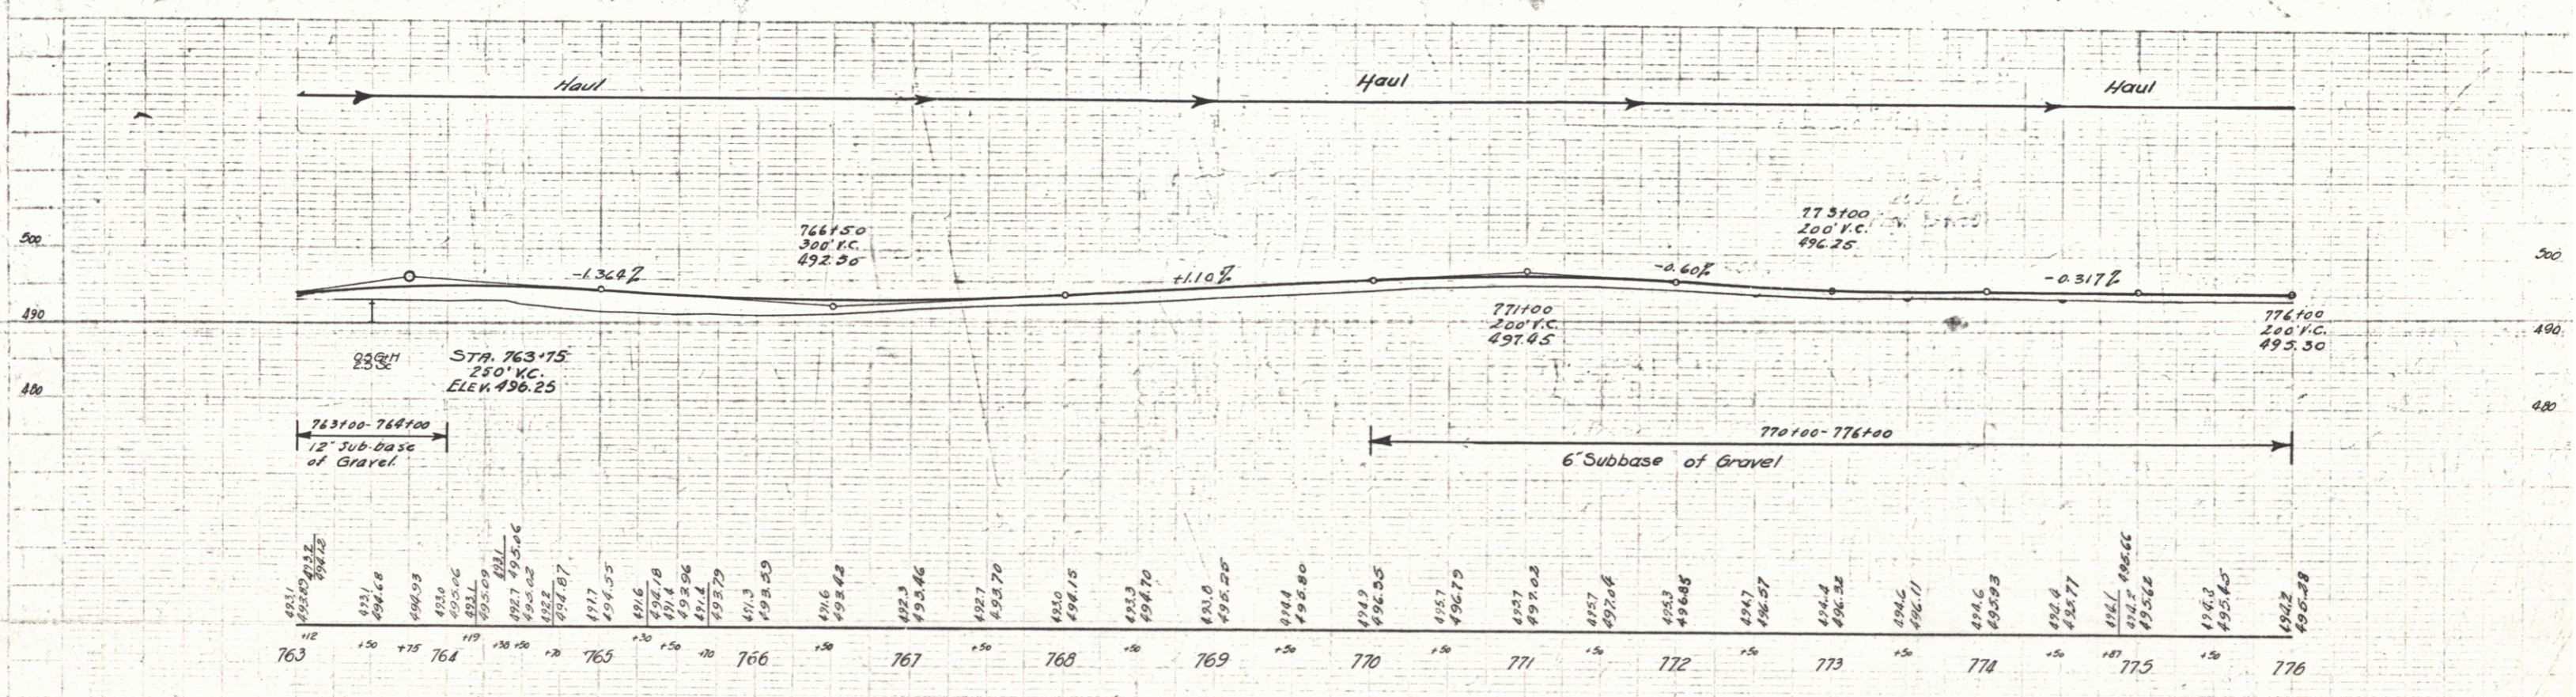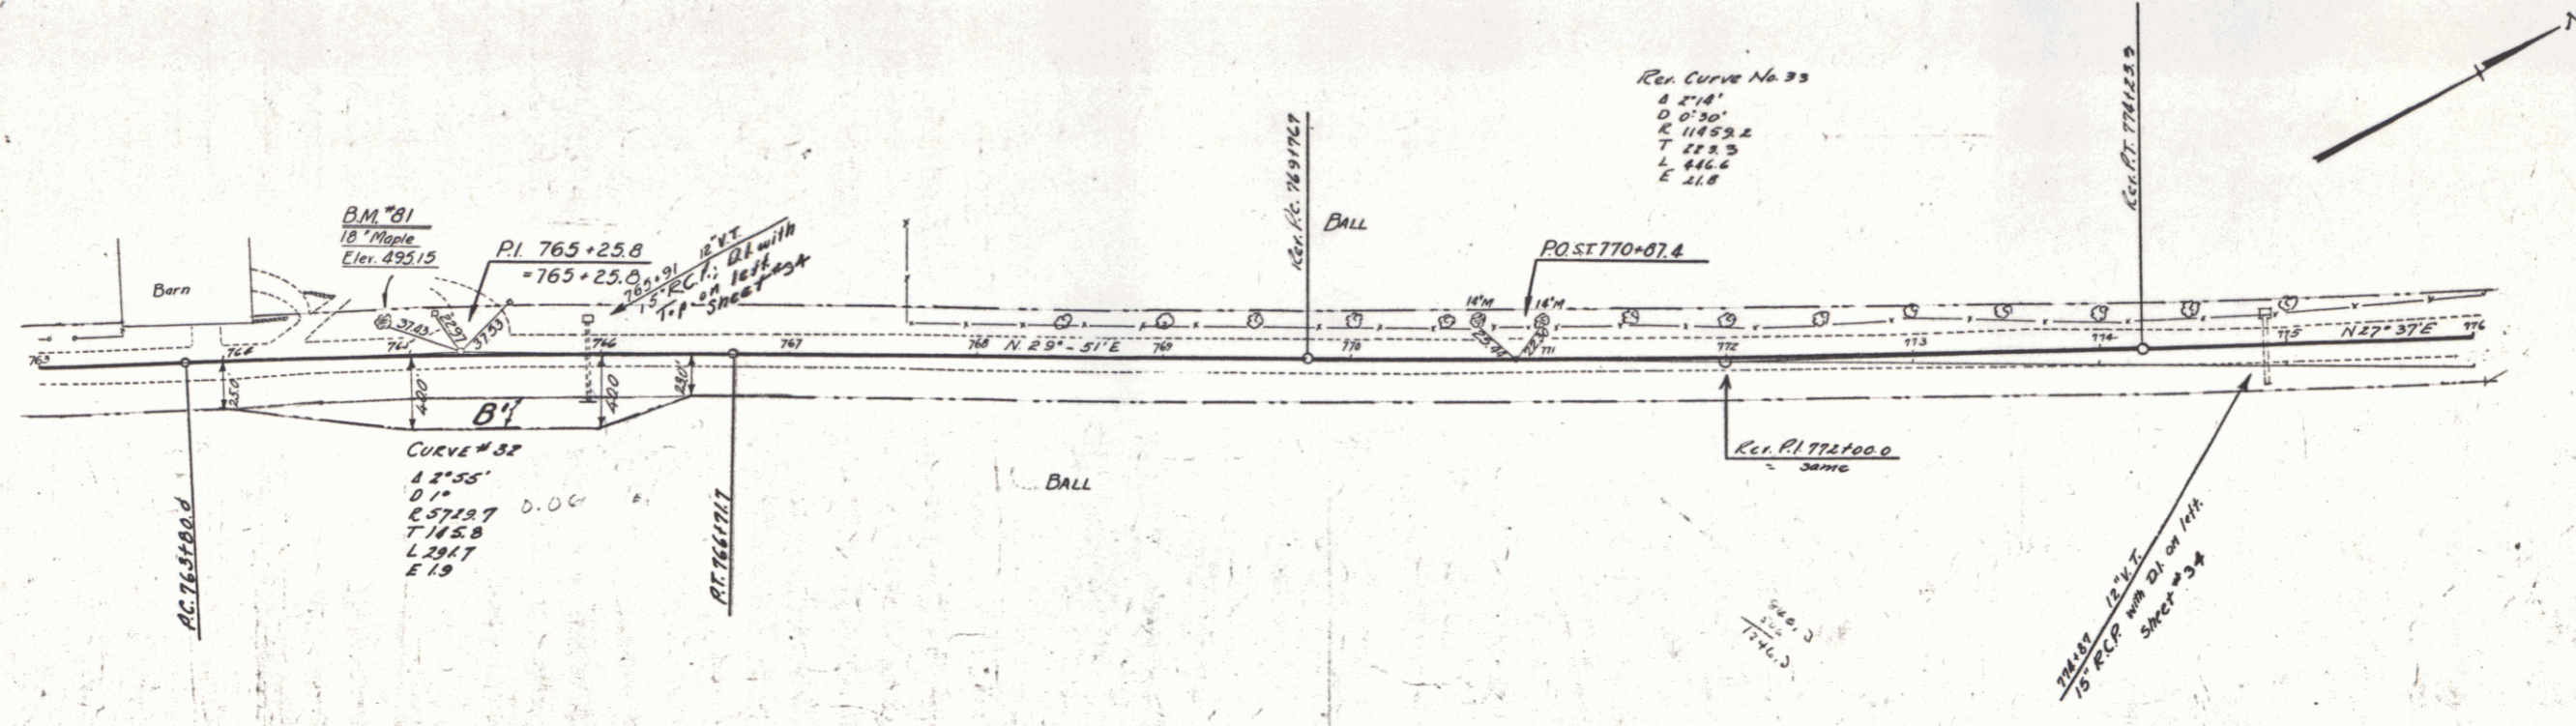

Sta	Elev	Sta	Elev	Sta	Elev	Sta	Elev	Sta	Elev	Sta	Elev	Sta	Elev	Sta	Elev	Sta	Elev	Sta	Elev								
763	492.1	764	493.5	765	494.5	766	495.5	767	496.5	768	497.5	769	498.5	770	499.5	771	500.5	772	501.5	773	502.5	774	503.5	775	504.5	776	505.5

SERIES F. N° 06C
SHEET 26 OF 110

27