

WOOD GUARD RAIL REQUIRED

Sta.	Left	Right
469100		2'

CABLE GUARD RAIL REQUIRED

Stations	Long	Short	Radius
471.72-479.20 R.	48'	30'	12.5'
471.72-482.100 R.	29'	40'	16.4'
481.64-482.100 R.	36'	20'	56'

NEW POINT CONC. PIPE CULVERTS REQUIRED

Sta.	Width	Length	Curve R.	Curve S.	Dist.
470.00	18"	48'	1.50%	137'	
470.30	18"	60'			737'

GRAVEL COBBLE GUTTER REQUIRED

Station	Width	Area
475+50	3'-0"	28 sq. ft.



WOOD GUIDE POSTS REQUIRED

Sta.	Left	Right
469100		2'

3.5 c.y.

Parcel	Kind of Instrument	Date of Instrument	Grantor	Grantee	Recorded Lydon	Remarks
C.P. 471.72	G.C.D.	1-3-32	DL LG & DN Rundy St. of Ft.	St. of Ft.	3A 246 248	3-17-32 Cul. Sta. + 781.30
A		1-4-32	R.M. Frost		3A 248	3-17-32

86C 1931 6 110

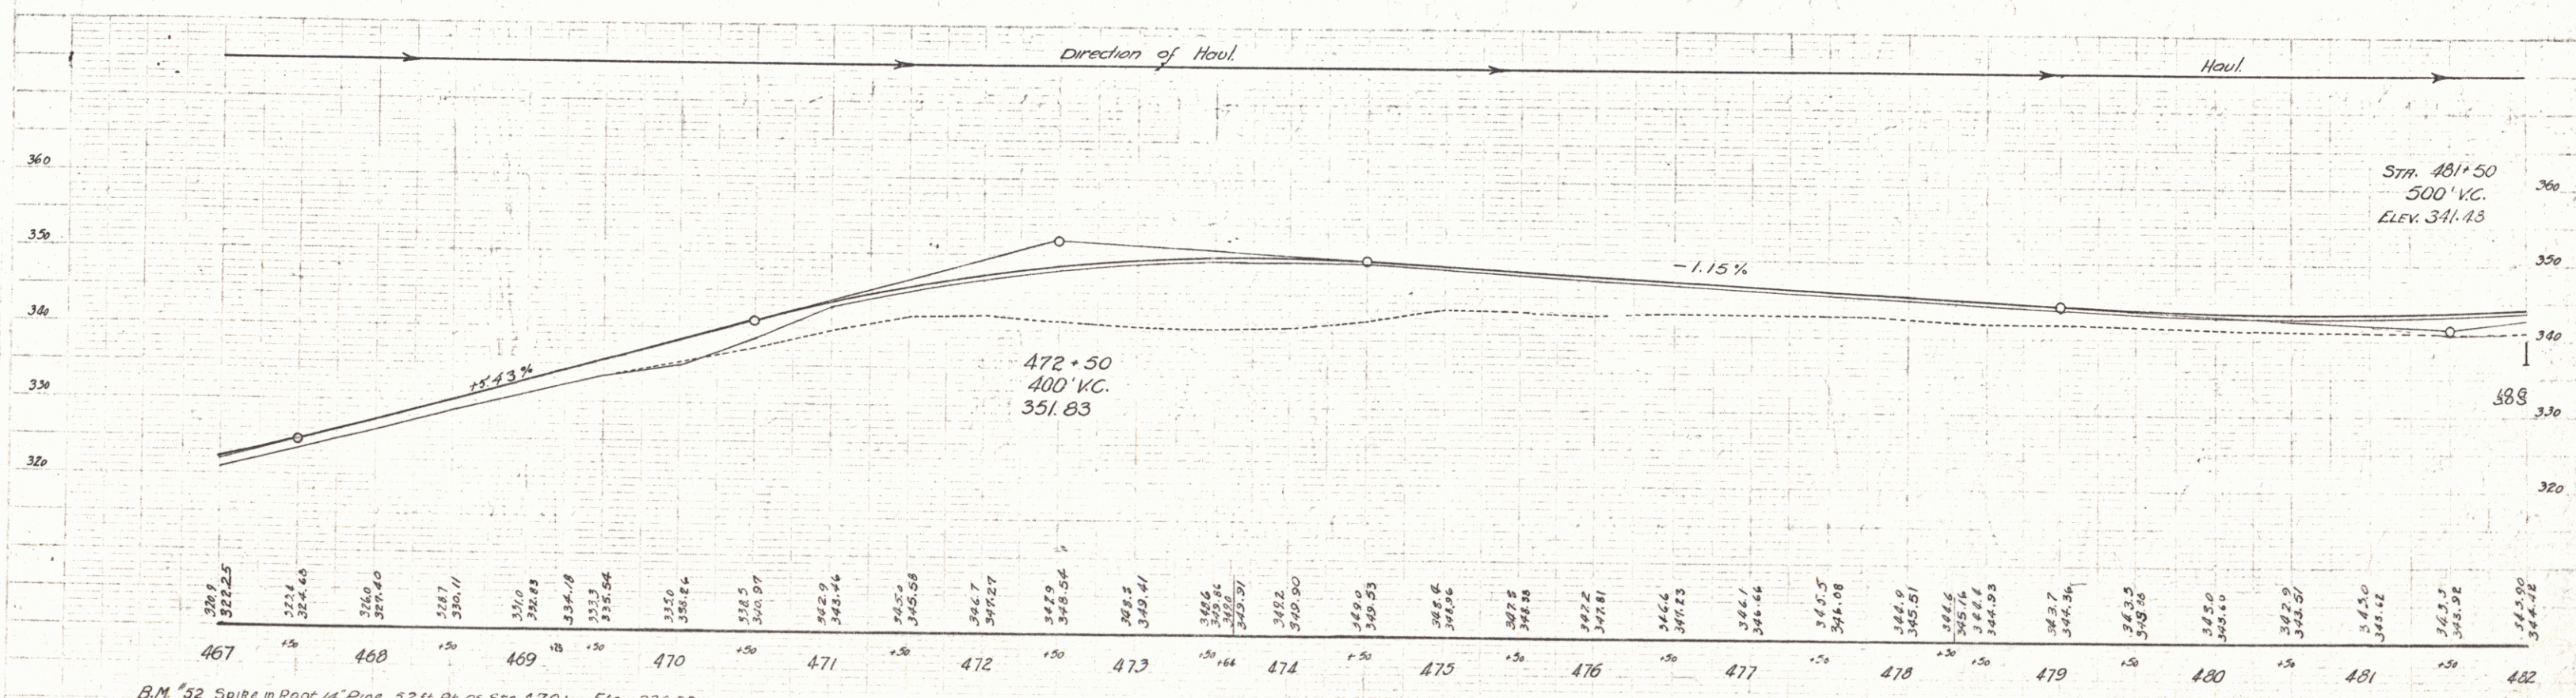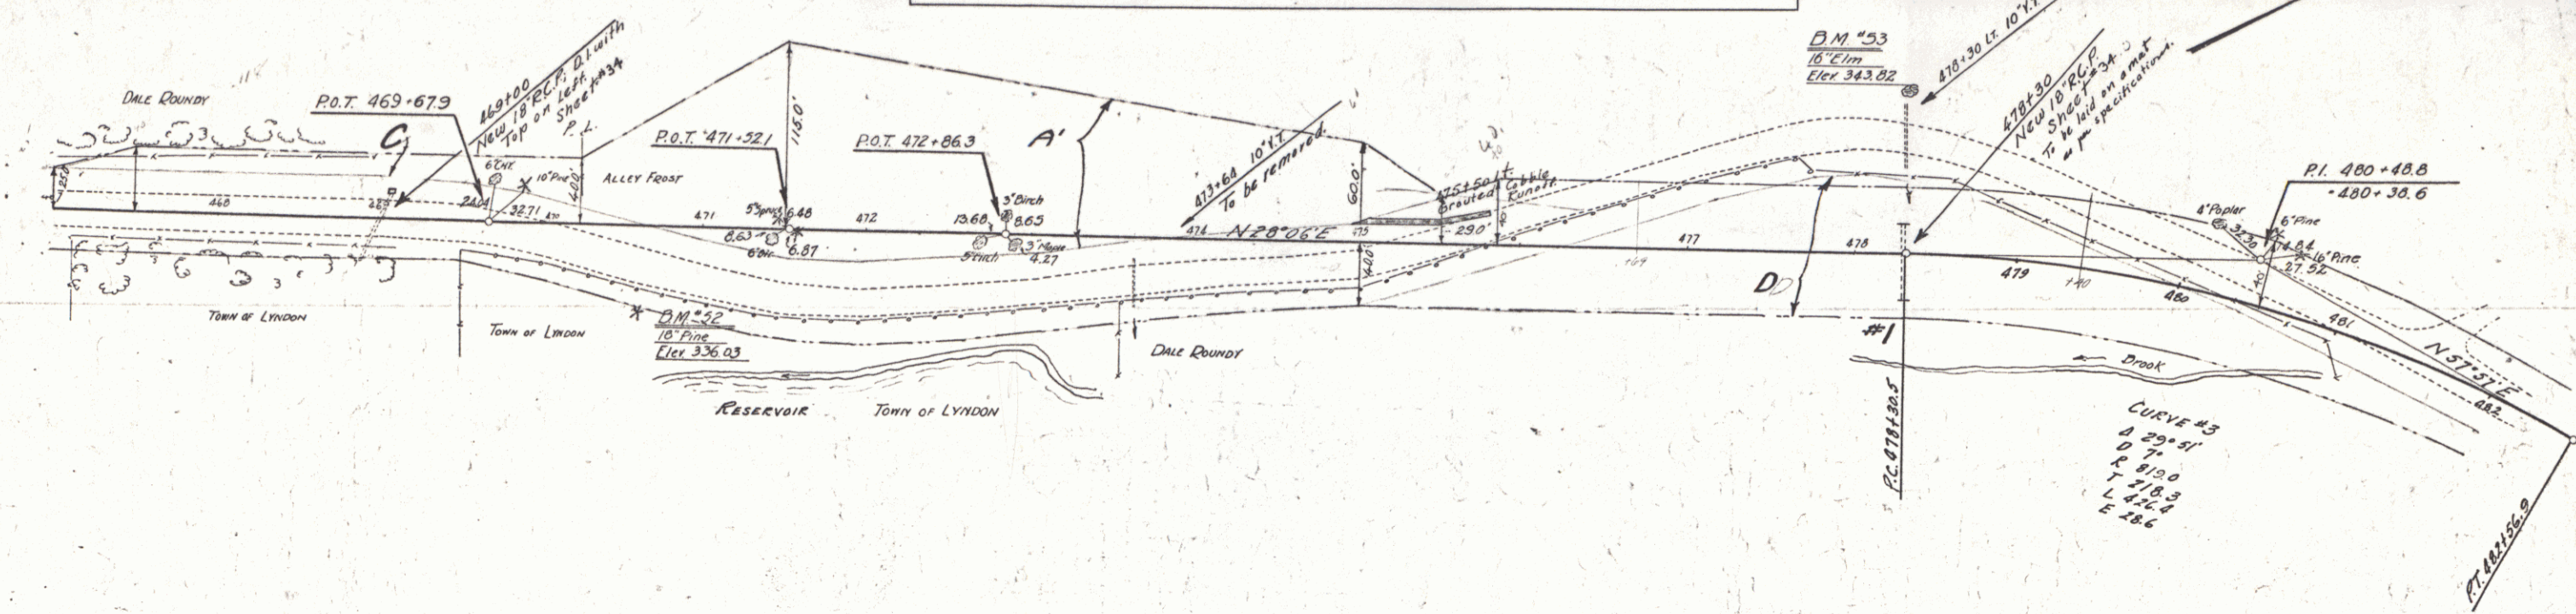

B.M. 52 Spire in Roof of Pine 52 ft. Ht. of Sta. 470. Elev. 336.03
 B.M. 53

SERIES F 86C
 SHEET 6 of 110

6