



WOOD GUIDE POSTS REQUIRED  
 Curb Sta Left Right  
 519+55 2 2

NEW REIN. CONC. PIPE CULVERTS REQUIRED  
 Sta. 519+55 18" 40' 15 CY 157' 1.89'

NEW REIN. CONC. DRIVEWAY PILES REQUIRED  
 Sta. 520+11 L.R. 15' 40' 2.7 CY. Mas.  
 521+60 L.R. 15' 40' 2.7

DATE: 1931.9.110

Parcel	Kind of Instrument	Date of Instrument	Grantor	Grantee	Recorded Book Page	Recorded Date	Remarks
B <sup>1</sup>	O.C.D.	5-15-32	EA. II. & ES. Lang	St. of H. 14	273-4	6-12-32	
A & B	"	4-1-32	W.H.F. D. Greene	" "	34 133-360	6-11-32	

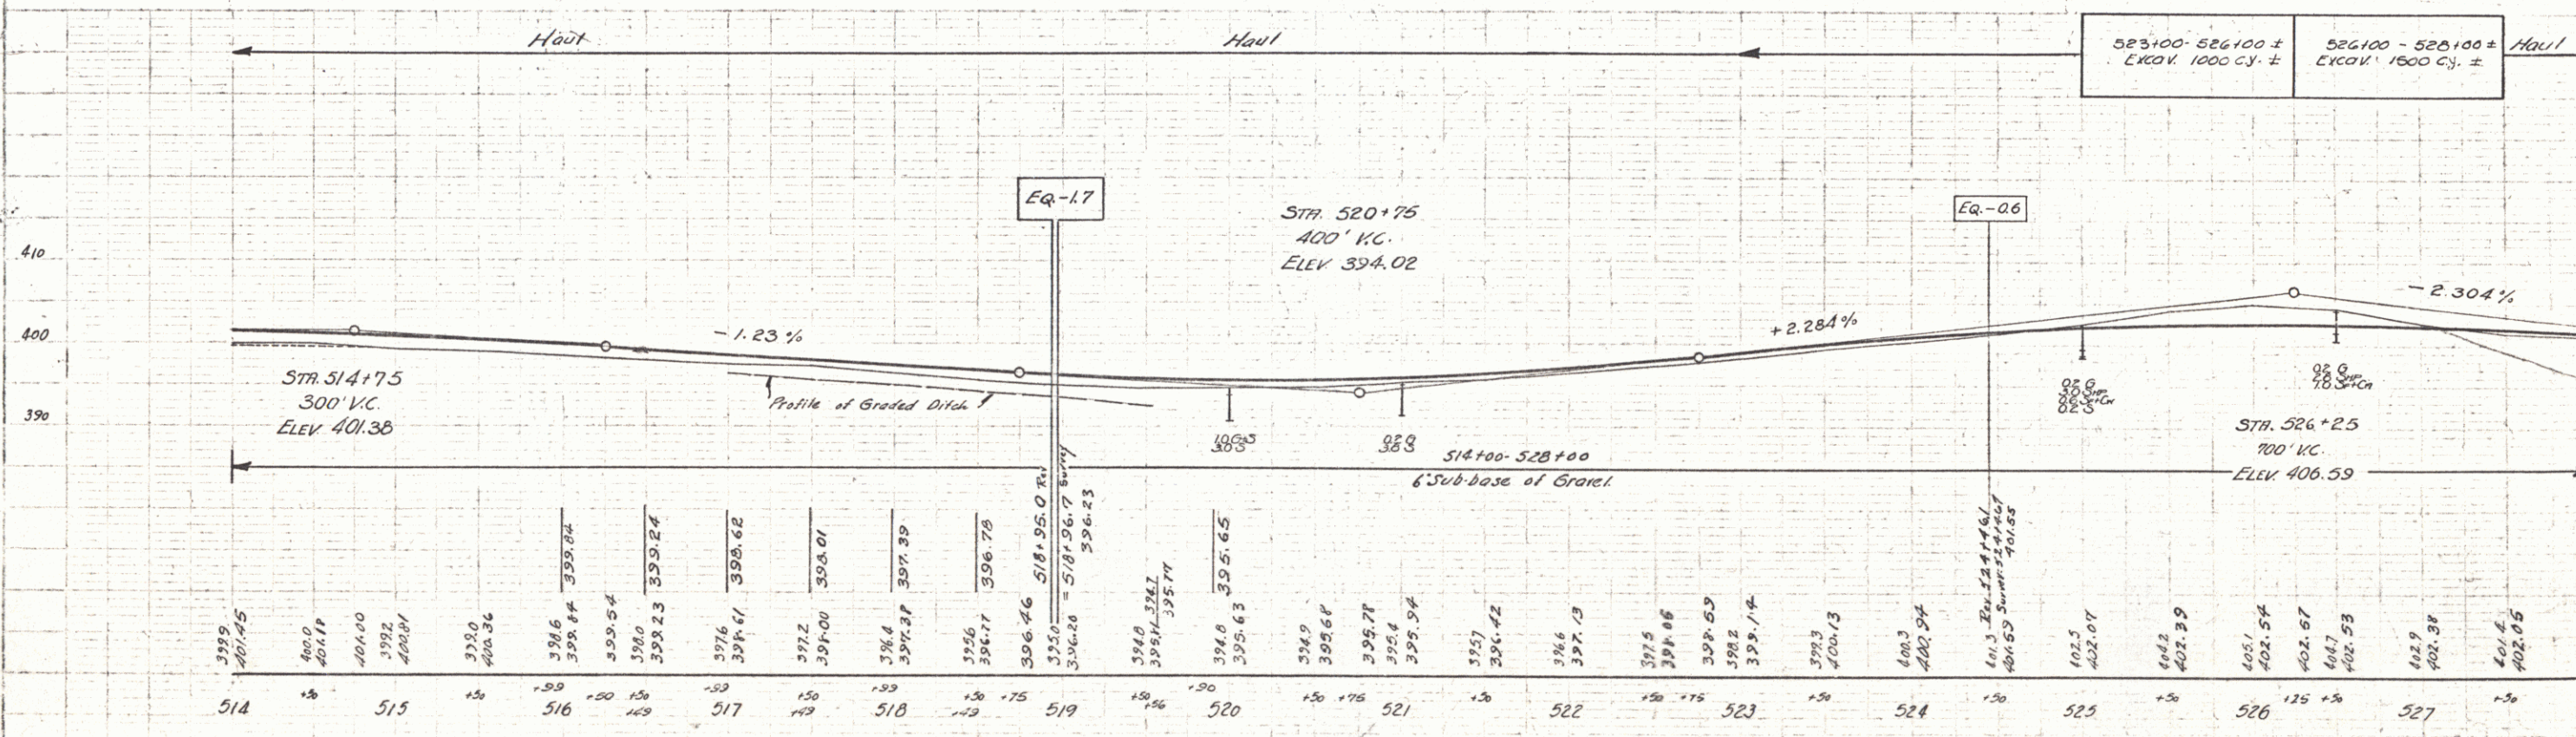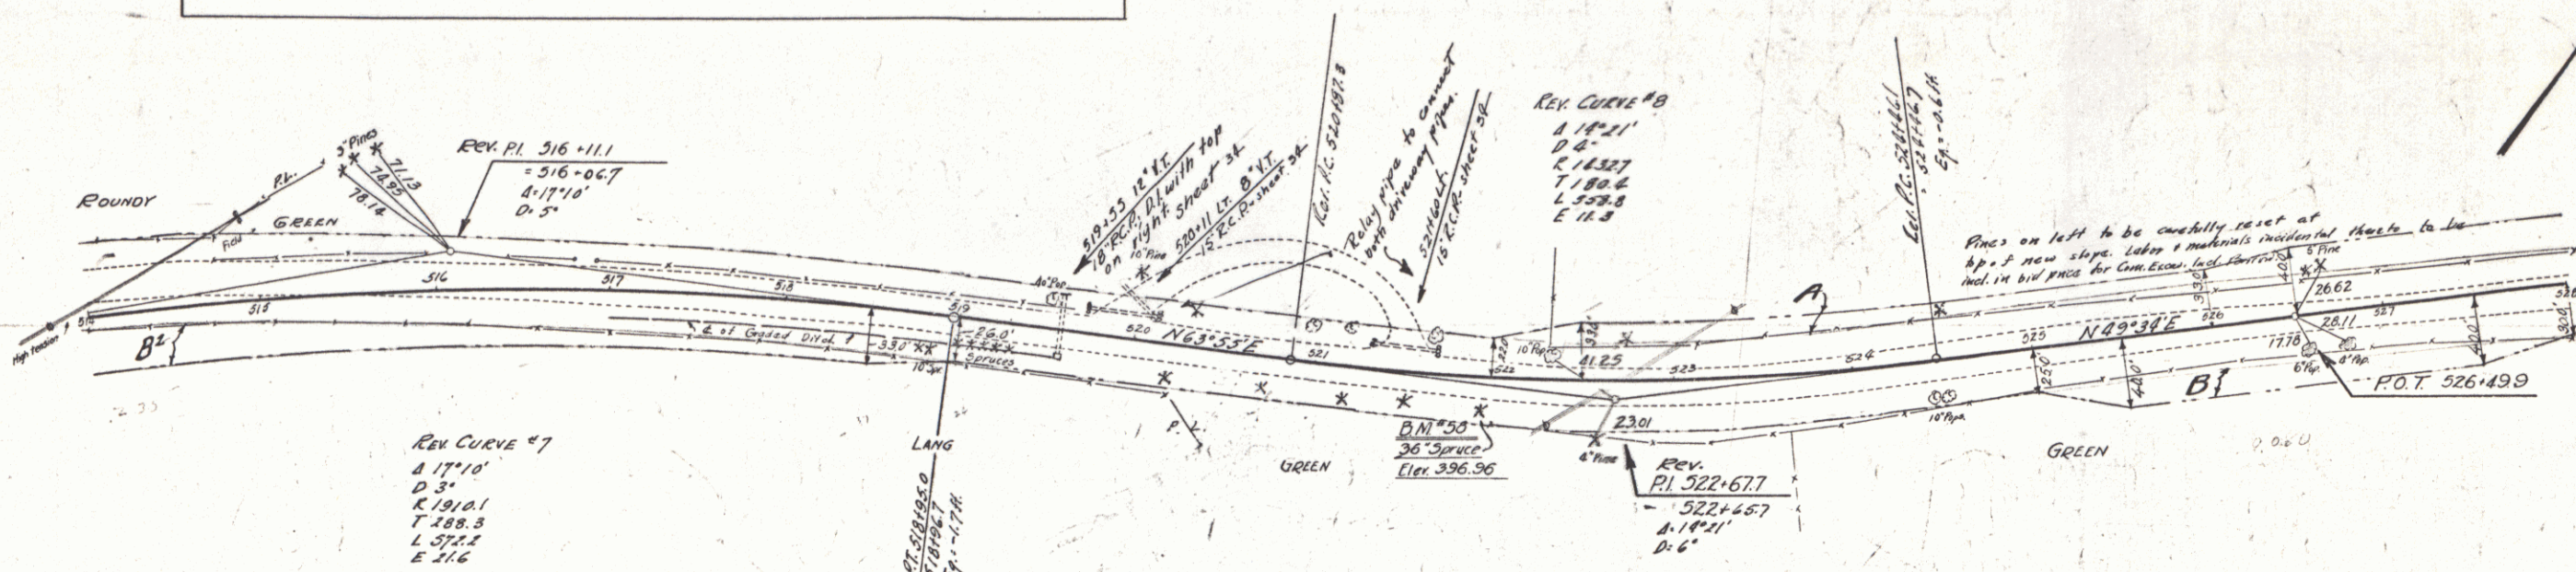

SERIES F No. 06C  
 SHEET 9 OF 110