
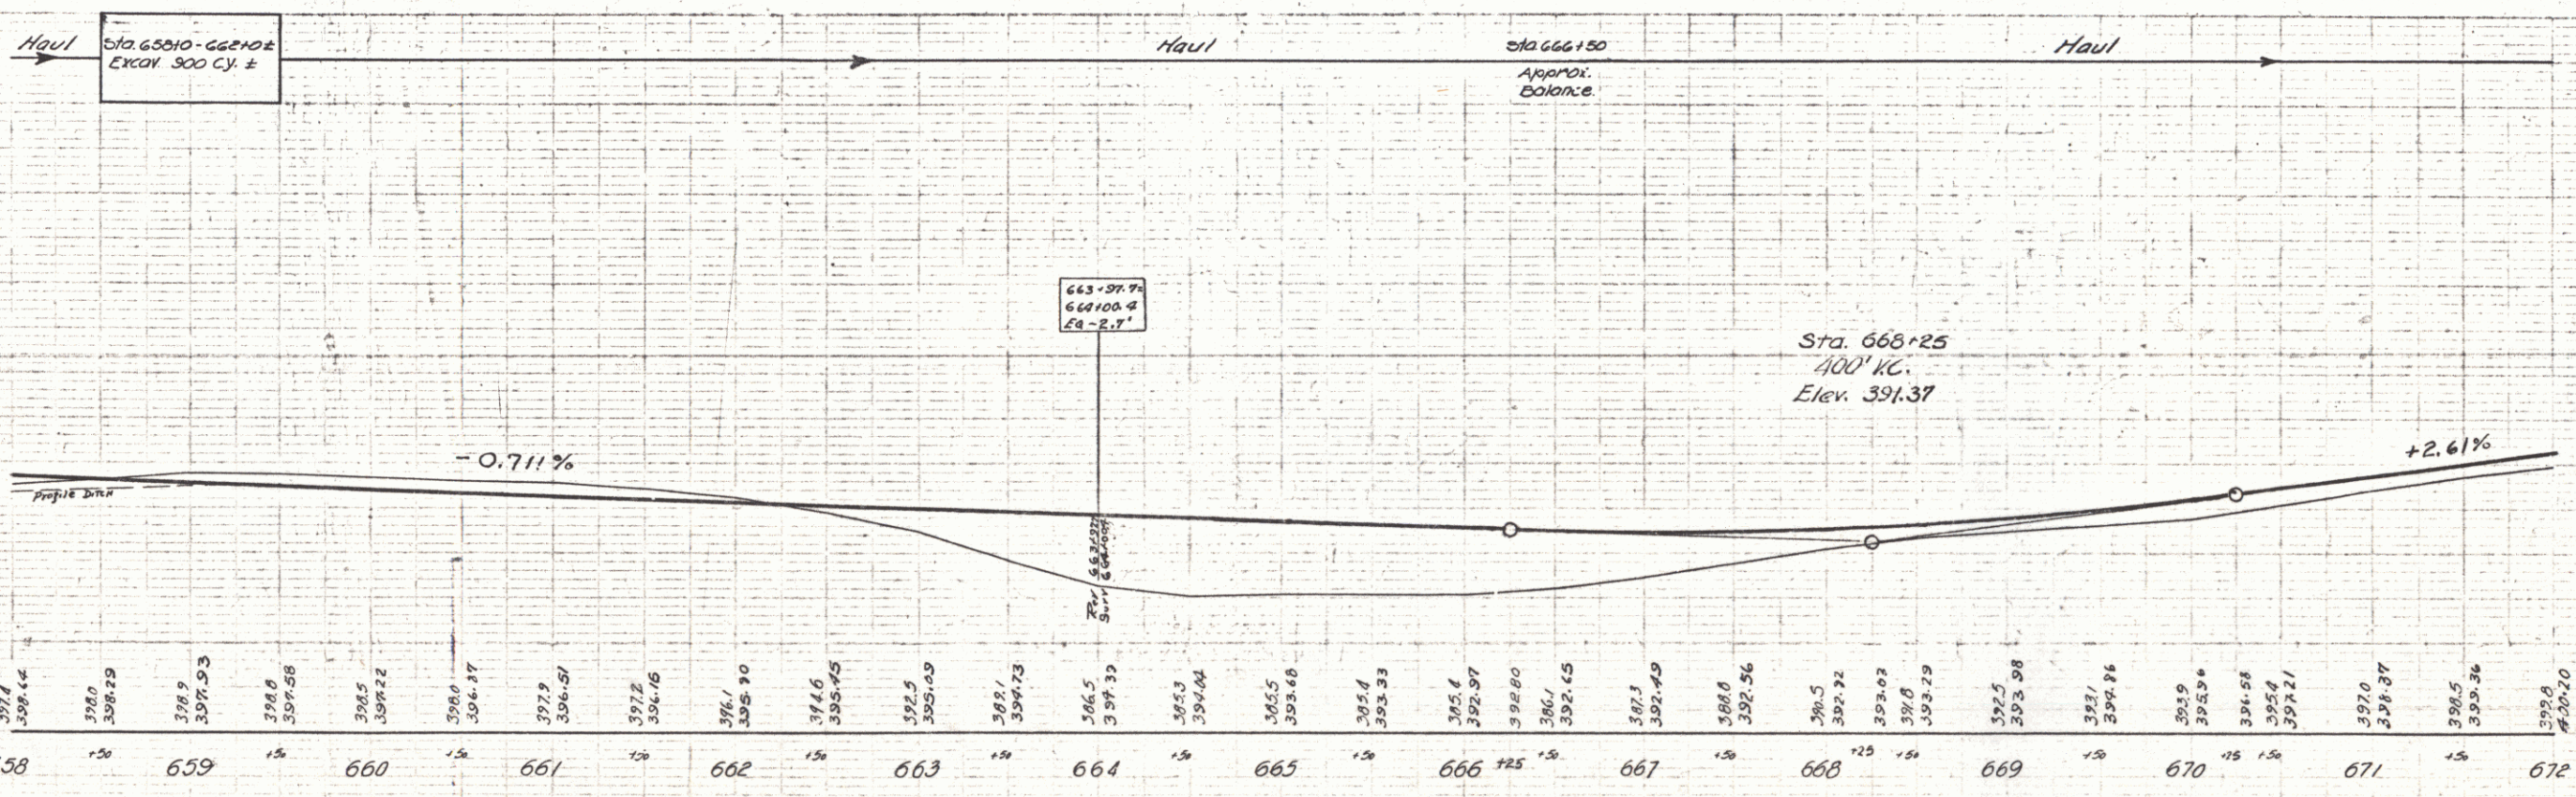


CABLE GUARD RAIL REQUIRED
 Stations: 664+80-668+40 L₁ 360' 40' 400'
 663+00-669+44 R₁ 144' 40' 184'

Parcel	Kind of Instrument	Date of Instrument	Grantor	Grantee	Recorded Book	Page	Date	Remarks
B&C	C.C.D.	1-A-32	C.M. J. Batchelder	St. of W.	18	384	3-17-32	
"	"	8-9-32	C.M. Darling	"	19	154	8-31-32	

STATE OF MASSACHUSETTS
 DISTRICT OF WORCESTER
 66C 1937 19 110

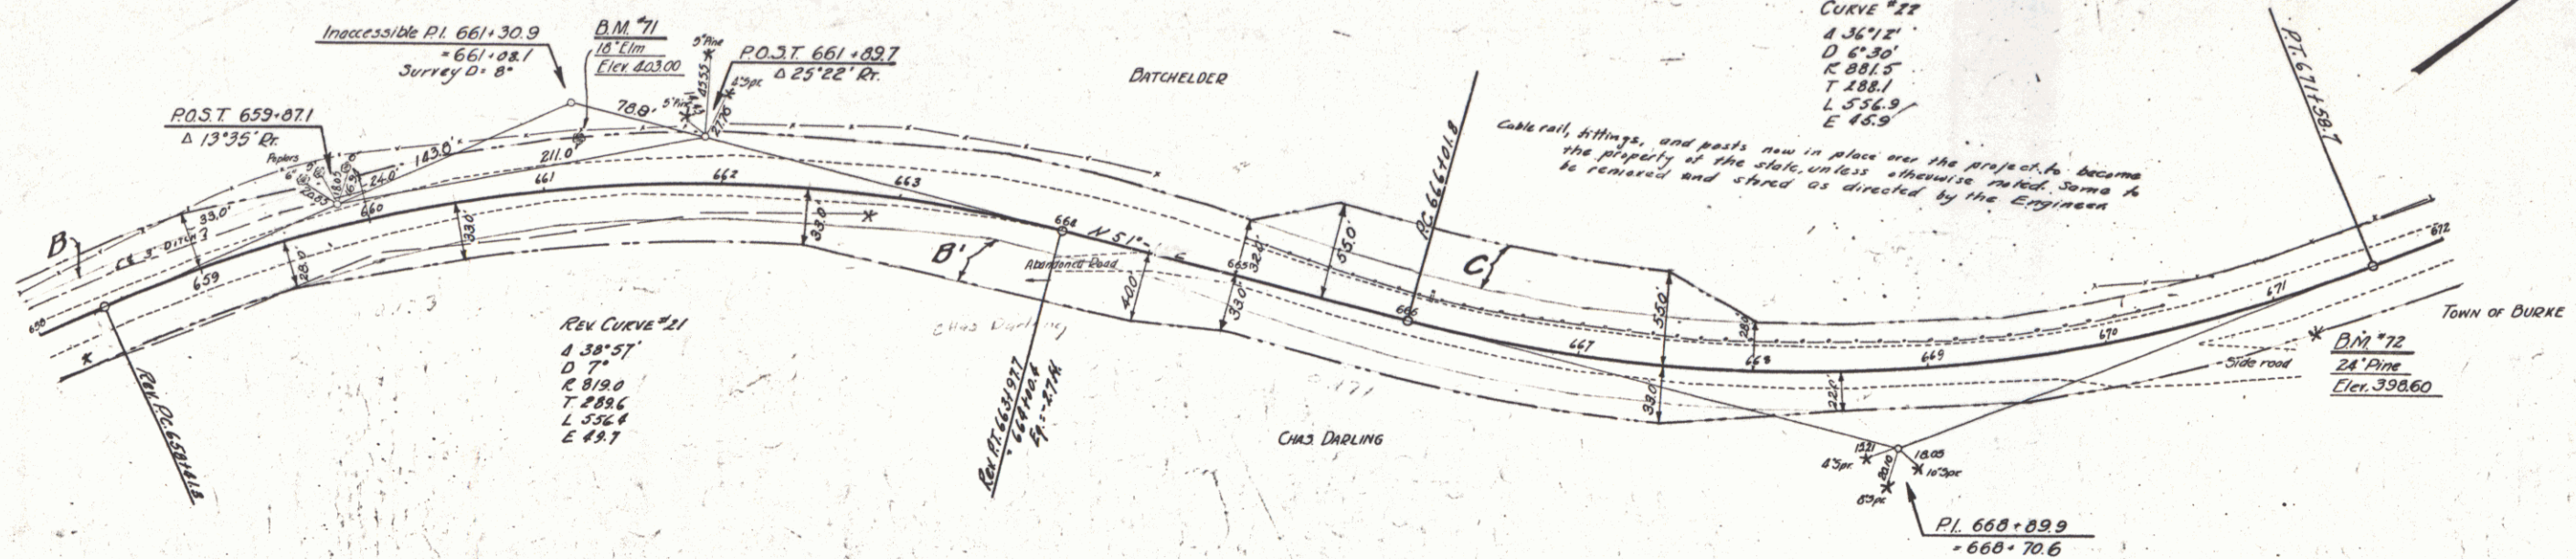

SERIES F N° 66C
 SHEET 19 OF 110