
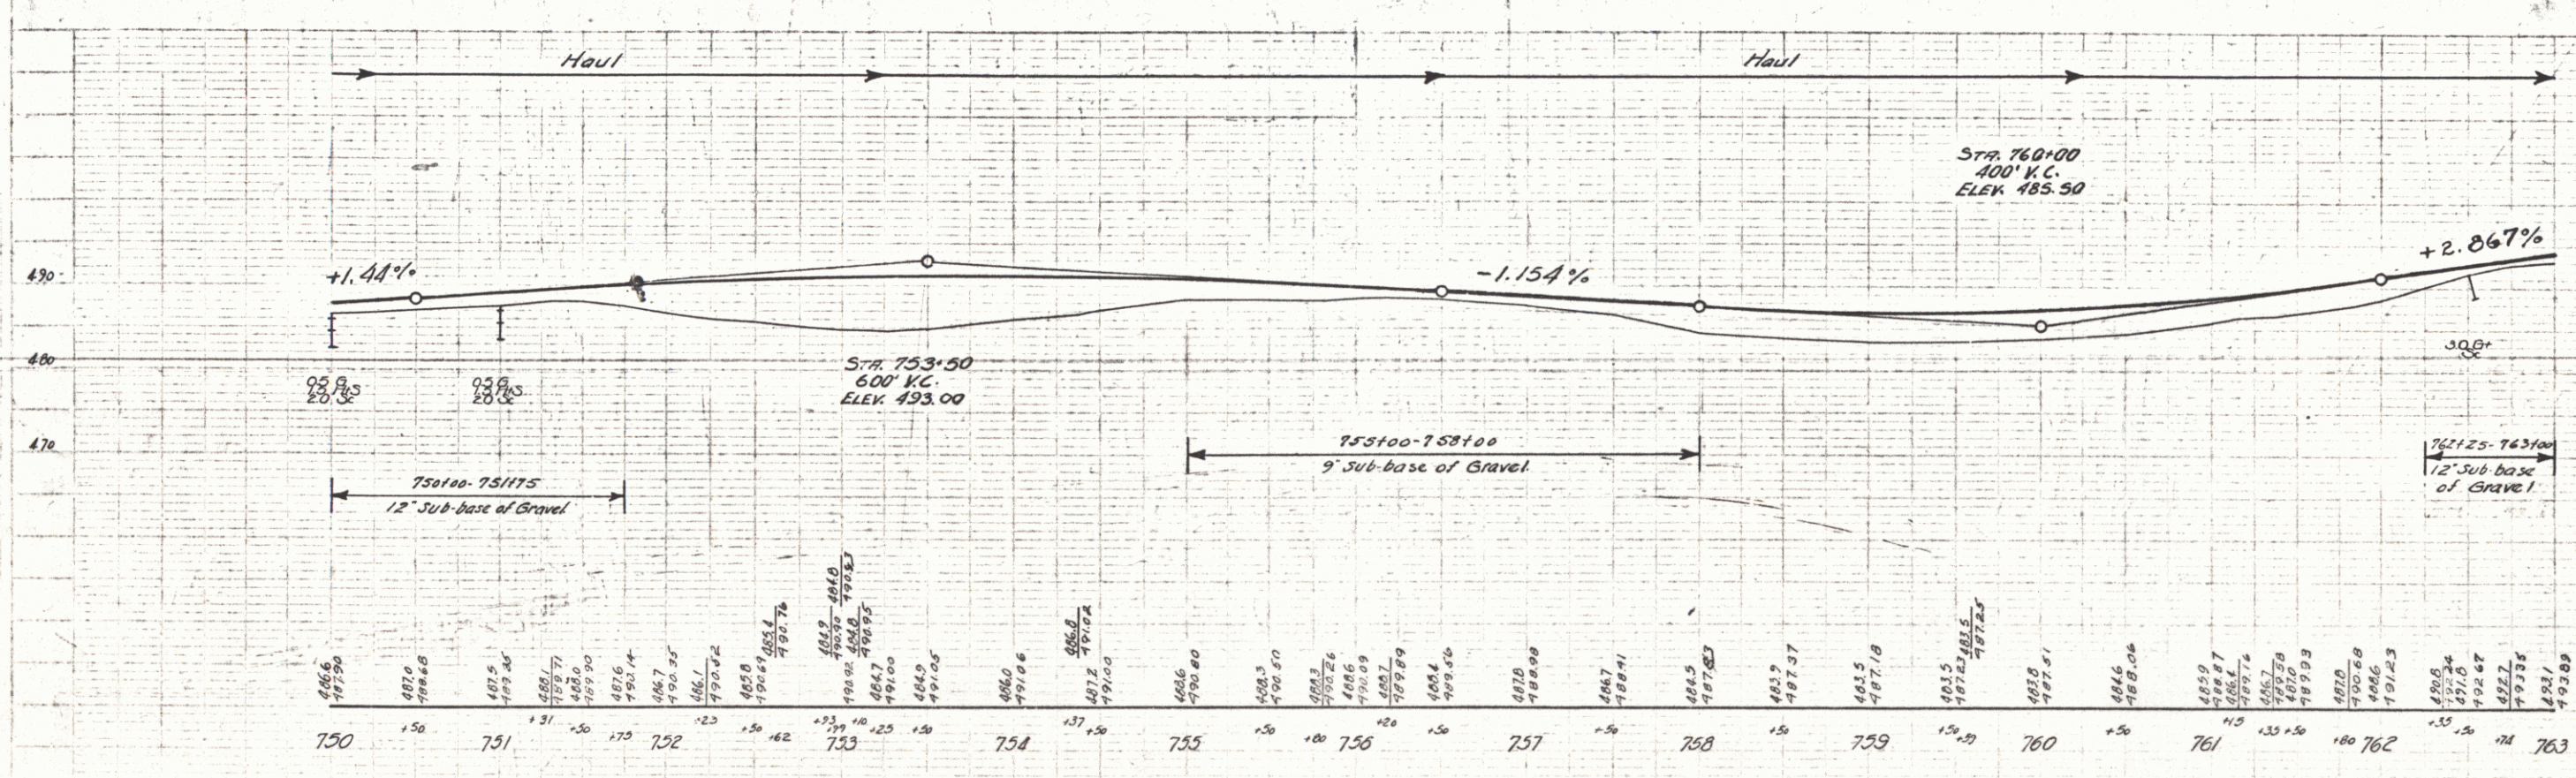


WOOD GUARD RAIL REQUIRED			CHAIN GUARD RAIL REQUIRED			NEW BIRM CON. PIPE CULVERTS REQUIRED			REIN. CONC. BOX CULVERTS REQUIRED			
Culv. Sta.	Left	Right	Stations	Long. Const.	Hy. Long.	Station	Diam	Length	S.R.M.	Station	Size	Conc. R. Steel
7591.59	24'	24'	7521.93 LK	148'	40'	7591.59	18"	44'	3.0 c.y.	7521.99	4'x6'	33.37, 2.67'
			7621.93 RK	148'	40'	7611.15	18"	44'	3.0 c.y.			

WOOD GUIDE POSTS REQUIRED		
Sta	Left	Right
7611.15	1'	2'

Parcel	Kind of Instrument	Date of Instrument	Grantor	Grantee	Recorded Book Page	Date	Remarks
A.B. & C. #2	O.C.D.	5-27-32	H.J. & Mauda	Road St of W.	130	180	5-11-33 Culv. Sta. 7521.99
A. & C. #1	"	5-25-32	C.O. & Edna Bull	"	130	111	5-30-32 " 7591.59

FED. ROAD DIST. NO.	STATE	PROJECT NO.	SHEET NO.	TOTAL SHEETS
9	VI.	86 C	1931	25

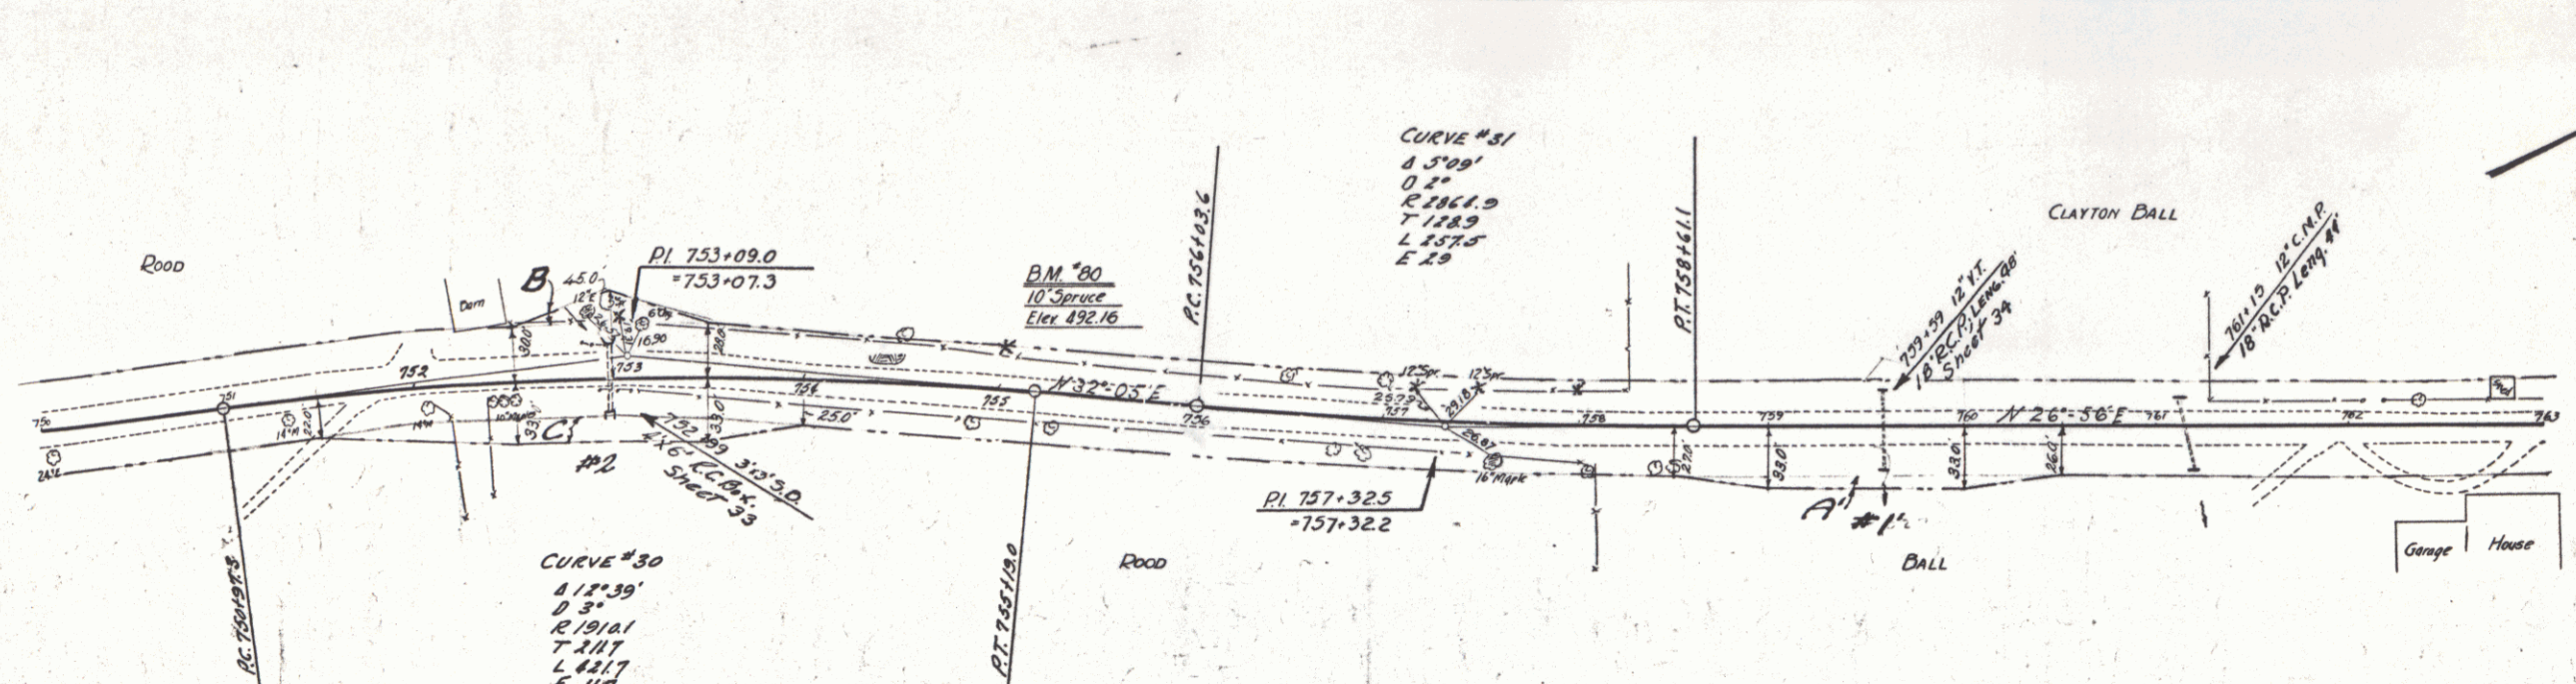

SERIES F N° 86C
SHEET 25 OF 110

26