
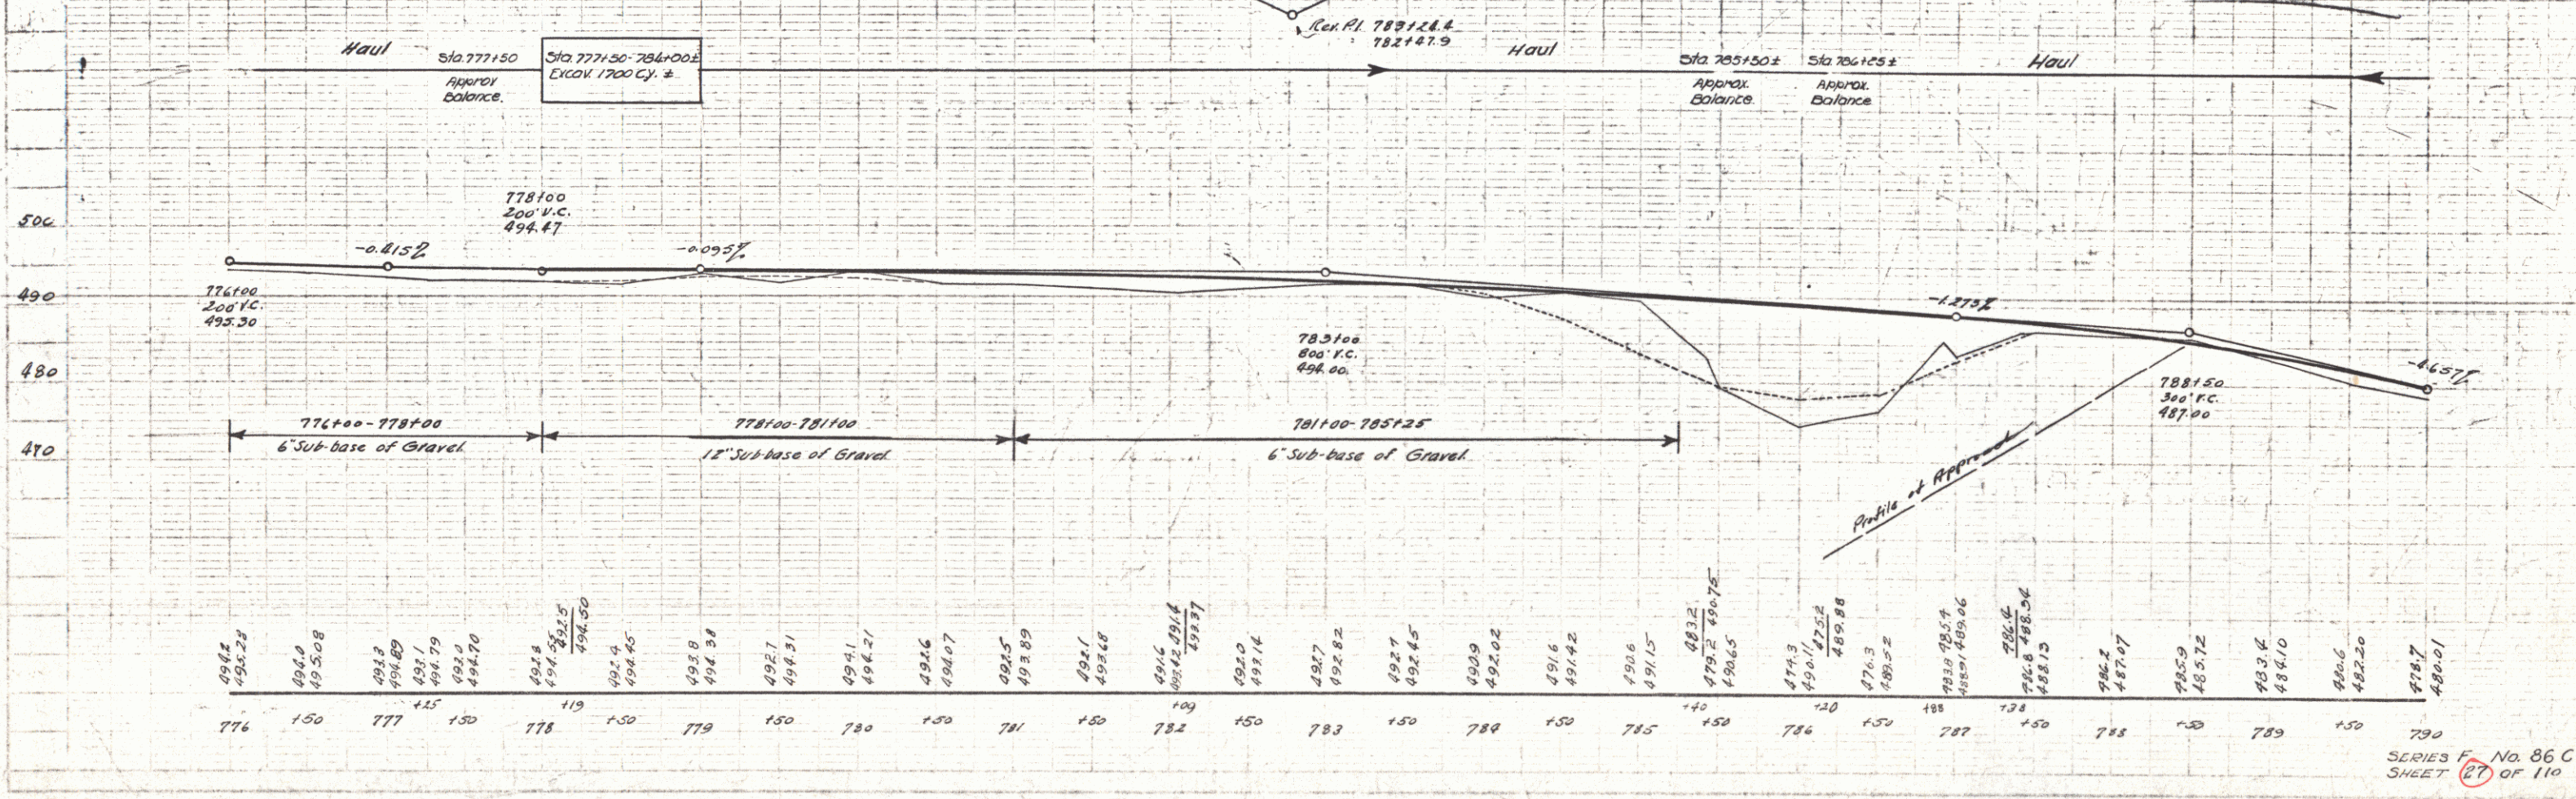


WOOD GUARD RAIL REQUIRED			CASTLE GUARD RAIL REQUIRED			NEW DEINF. CONC. PIPE CULVERTS REQUIRED						
Cul. Sta.	Left	Right	Stations	Length	Const.	Any/Length	Station	Diam	Length	Const.	S. P.M.	Steel
778+00	2'		785+00-786+80 R.P. 180'	40'	220'		778+00	18"	40'			12 cy.
781+86	2'		785+00-786+80 Ch. 180'	40'	220'		781+86	15"	44'			12 cy.
							785+38	36"	128'			40 cy.
							786+00	15"	60'			12 cy.

Sta.	Left	Right
778+00	2	-
781+86	2	-

Parcel	Kind of Instrument	Date of Instrument	Grantor	Grantee	Recorded	Remarks
C' Cul. #2	Q.C.D.	5-25-32	CO. & Edna Bell	Stef. H.	Book Page Date	232 11 6-29-32
A&B	"	5-25-32	W.D. & Gladys Wilkie	"	190 87	6-29-32
A1, B, C, etc.	"	5-27-32	D.C. Cheney	"	190 95	6-29-32

FIELD BOOK STATE OF ILLINOIS  
 No. 86-C 1932 27 110

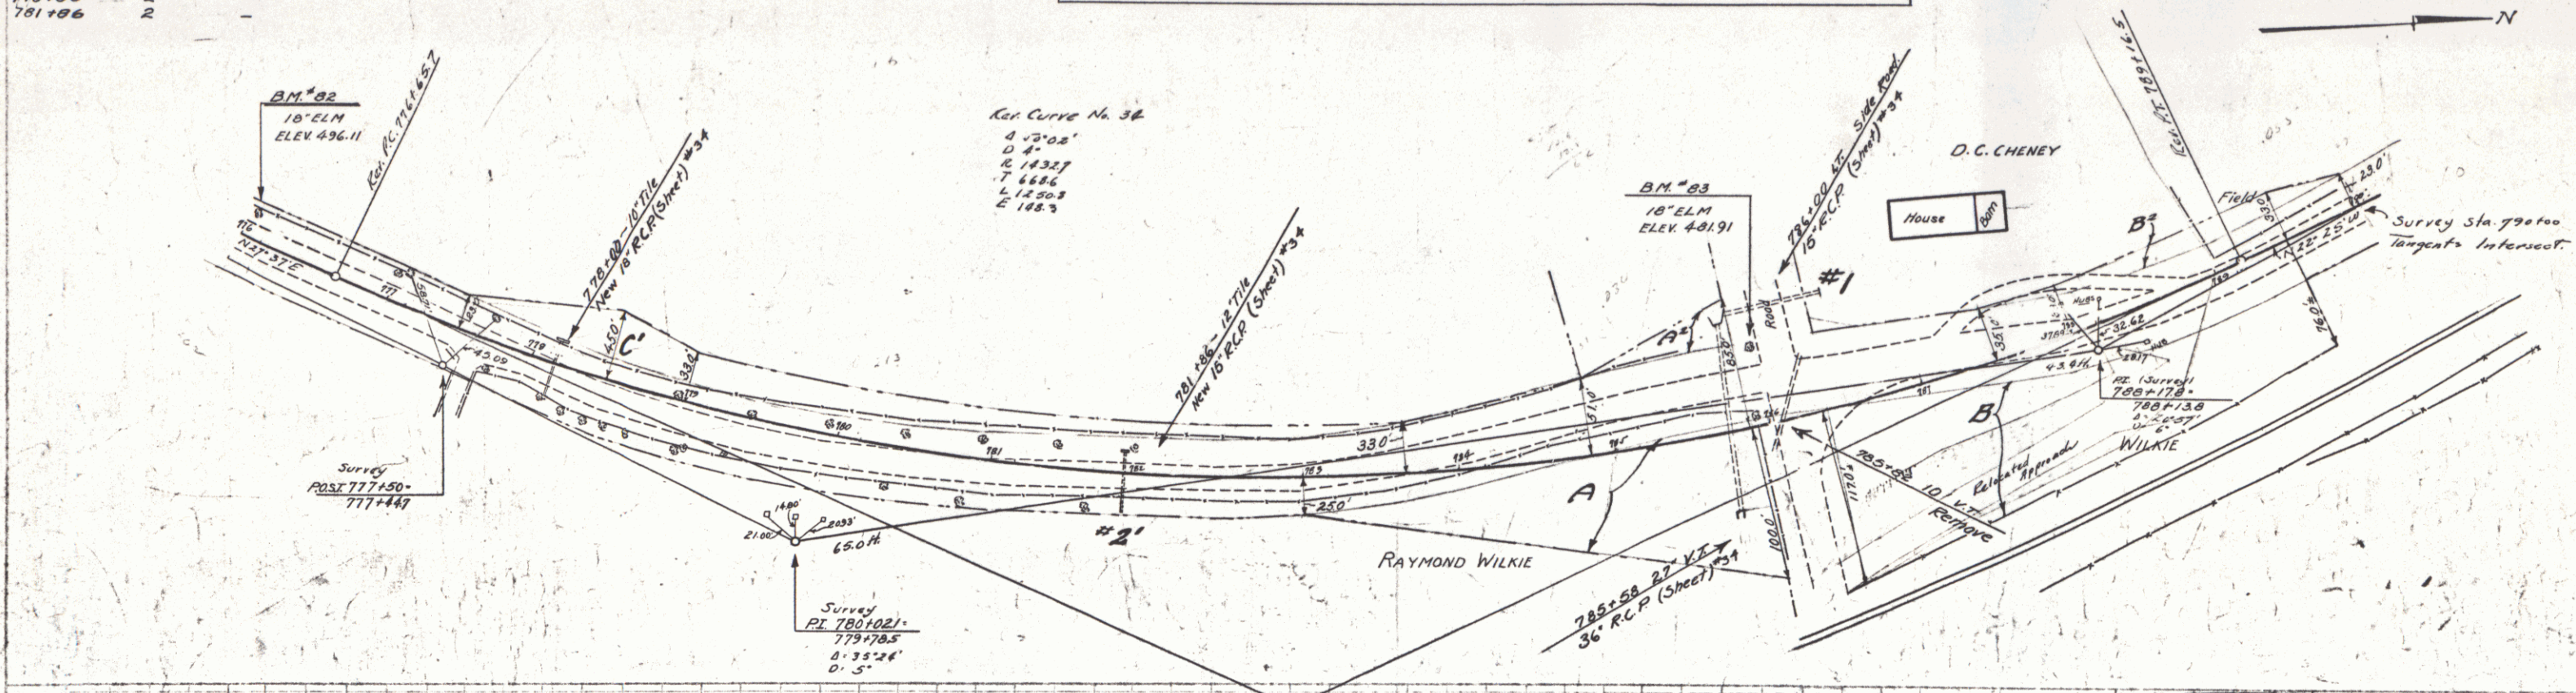

SERIES F No. 86 C  
 SHEET 27 OF 110