



PLAN  
 MIDDLEBURY STATION  
 3-30

PROFILE  
 MIDDLEBURY STATION  
 3-30

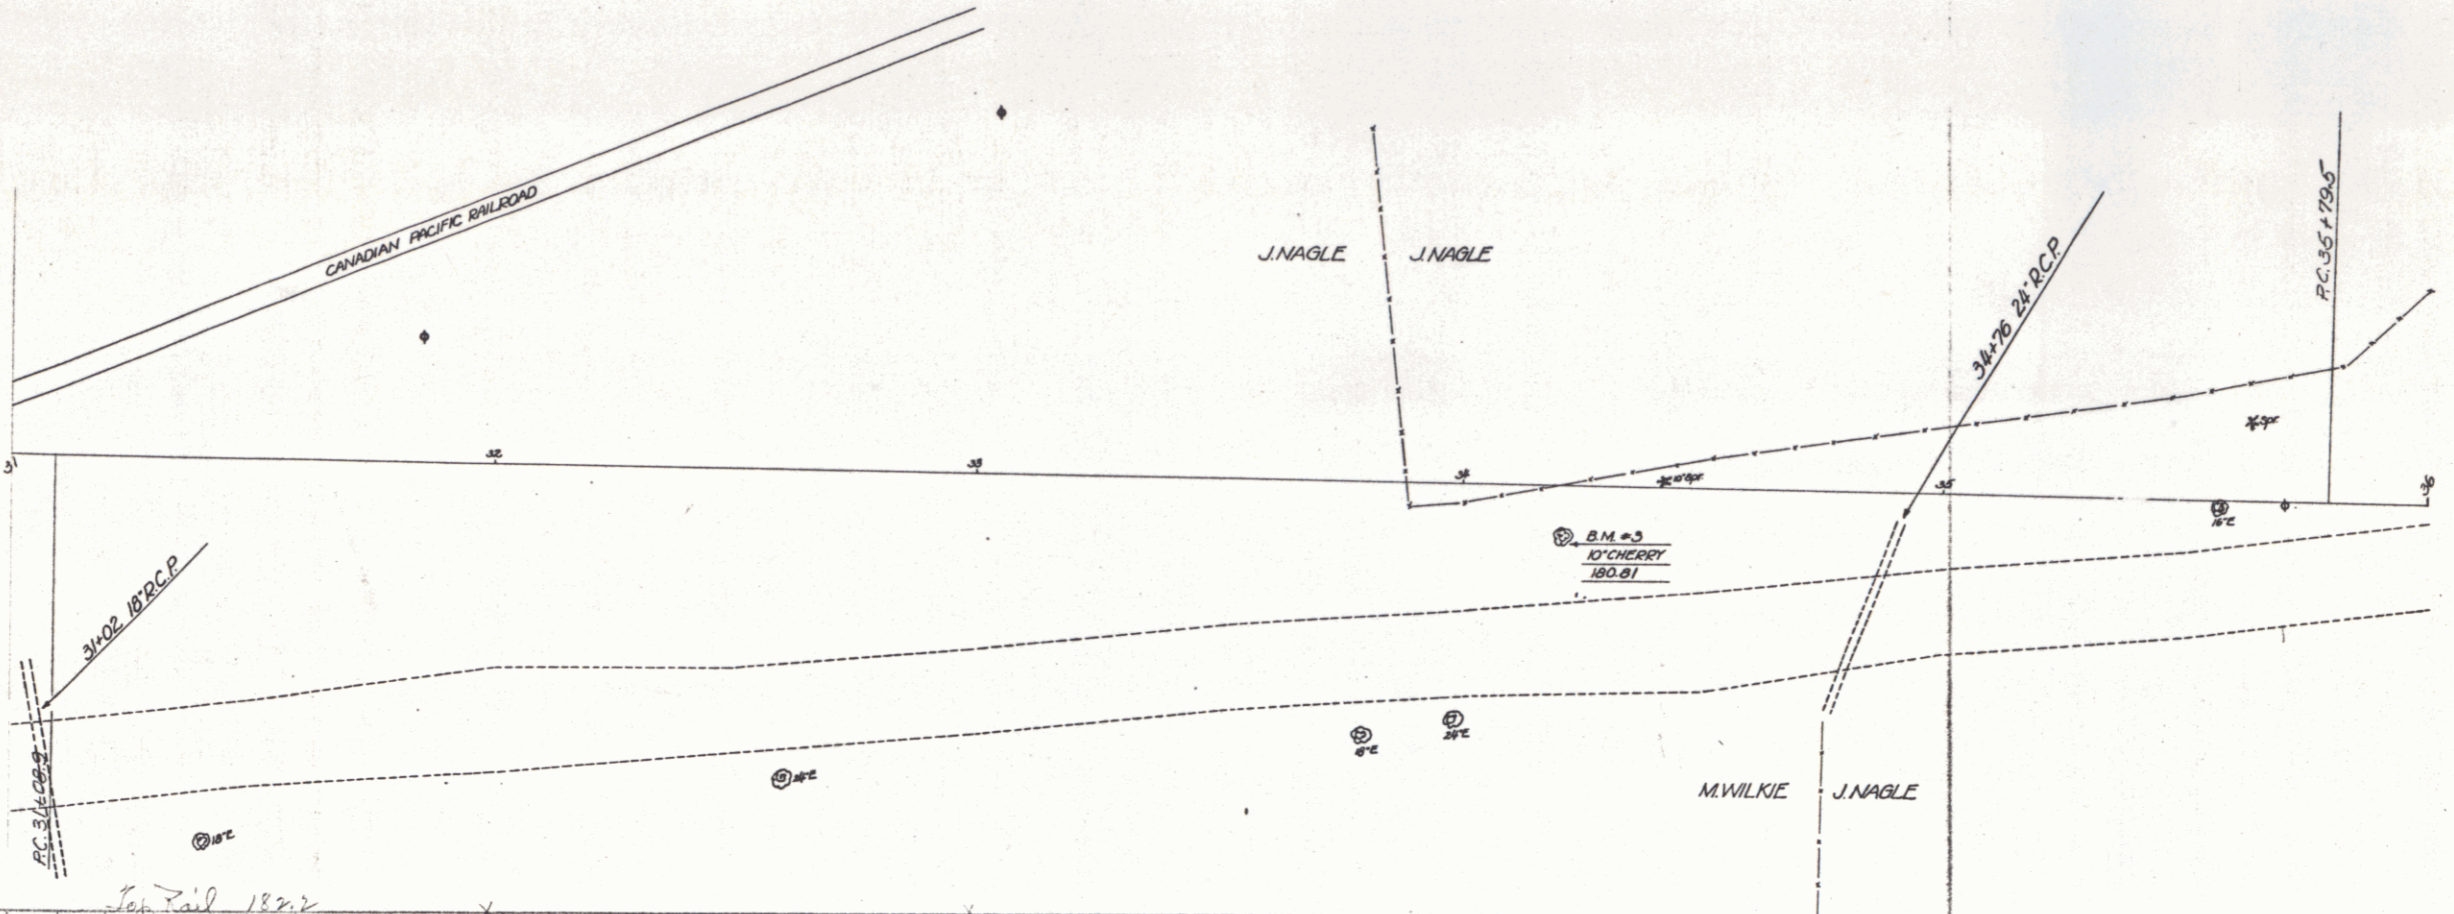

Top Rail 182.2  
 181.3  
 181.2  
 181.7  
 181.0

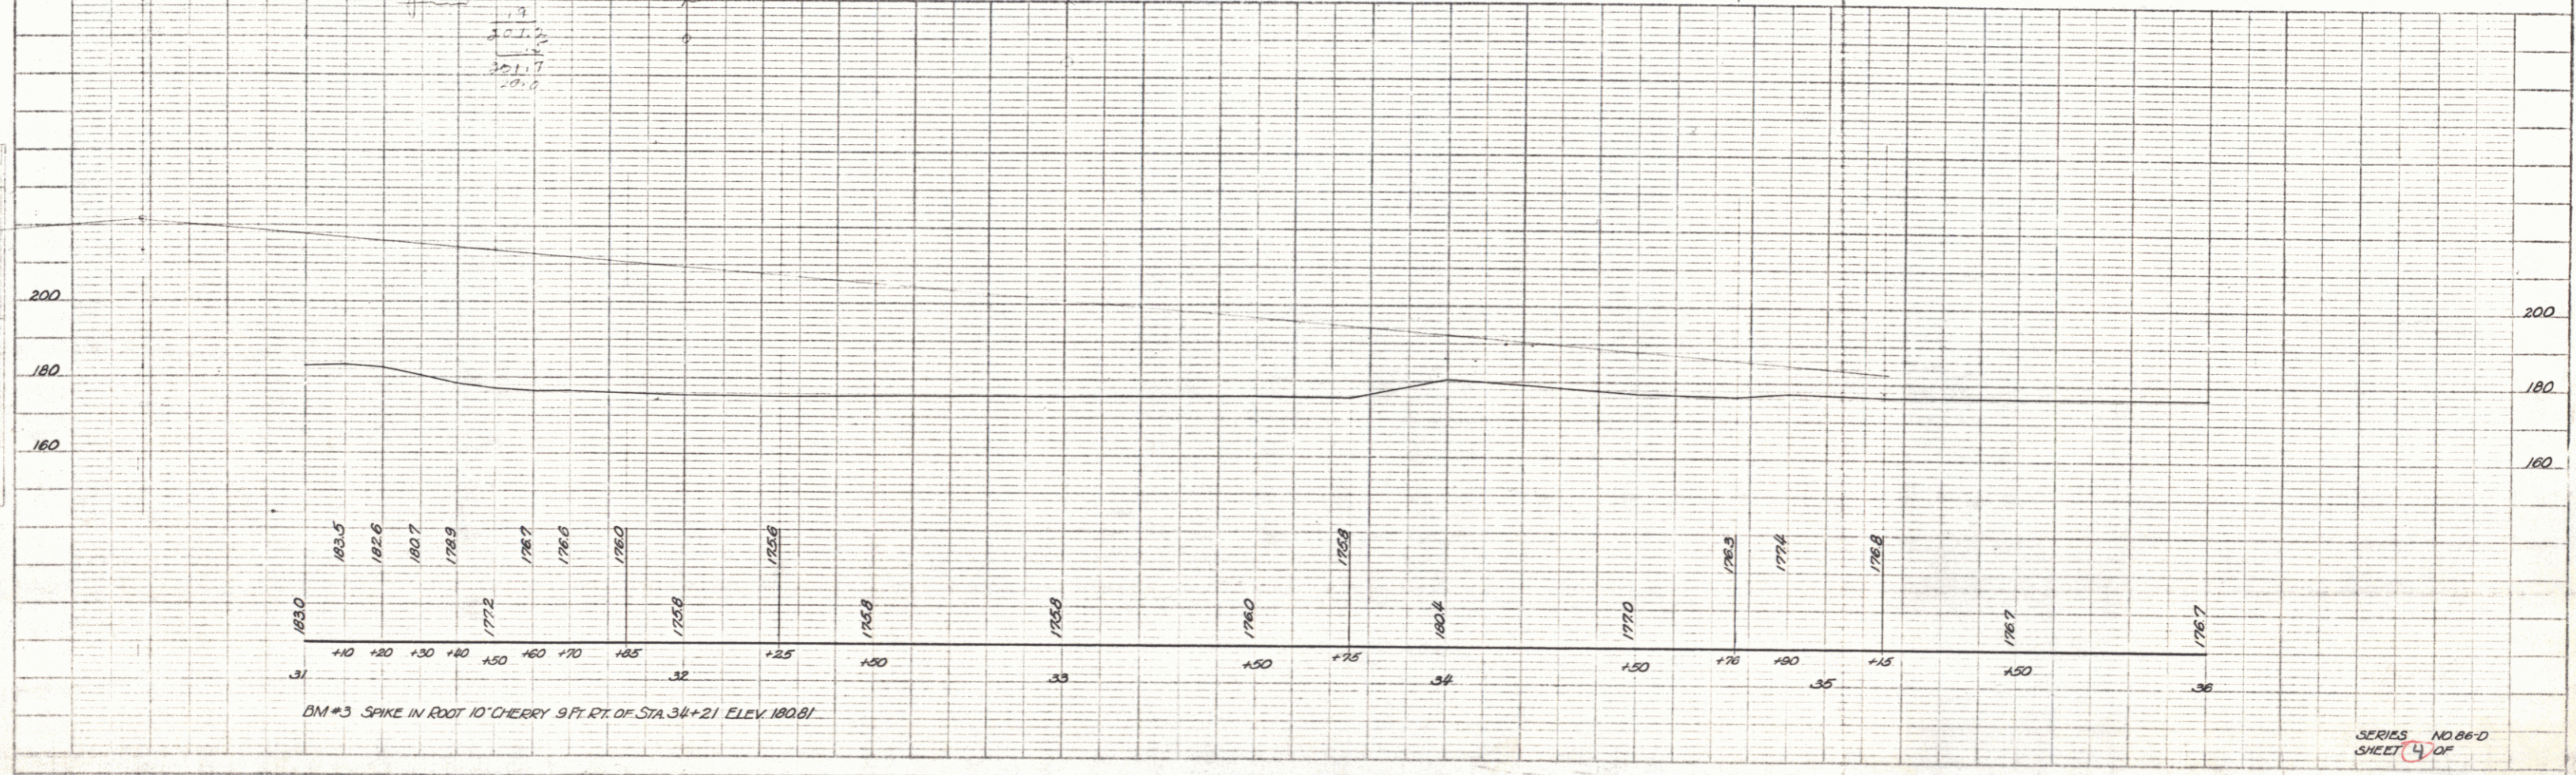

B.M. #3 SPIKE IN ROOT 10' CHERRY 9 FT. RT. OF STA. 34+21 ELEV. 180.81

SERIES NO. 86-0  
SHEET 4 OF 4

PLATE 2-PLAN PROFILE S. S. & S. COMPANY  
 NEWTON, MASS. U.S.A.

4