

REVISED CURVE No. 2
 Δ - $23^{\circ}-1'$ RT
 D - 4°
 R - 1432.63
 T - 291.48
 L - 575.42
 E - 29.40


REVISED CURVE No. 3
 Δ - $30^{\circ}-1'$ LT
 D - 4°
 R - 1432.63
 T - 112.95
 L - 225.42
 E - 4.45

Handwritten initials

JIM NAAGLE



PLAN	DATE	BY
NOTED	DATE	BY
REVISIONS	DATE	BY
1		
2		
3		

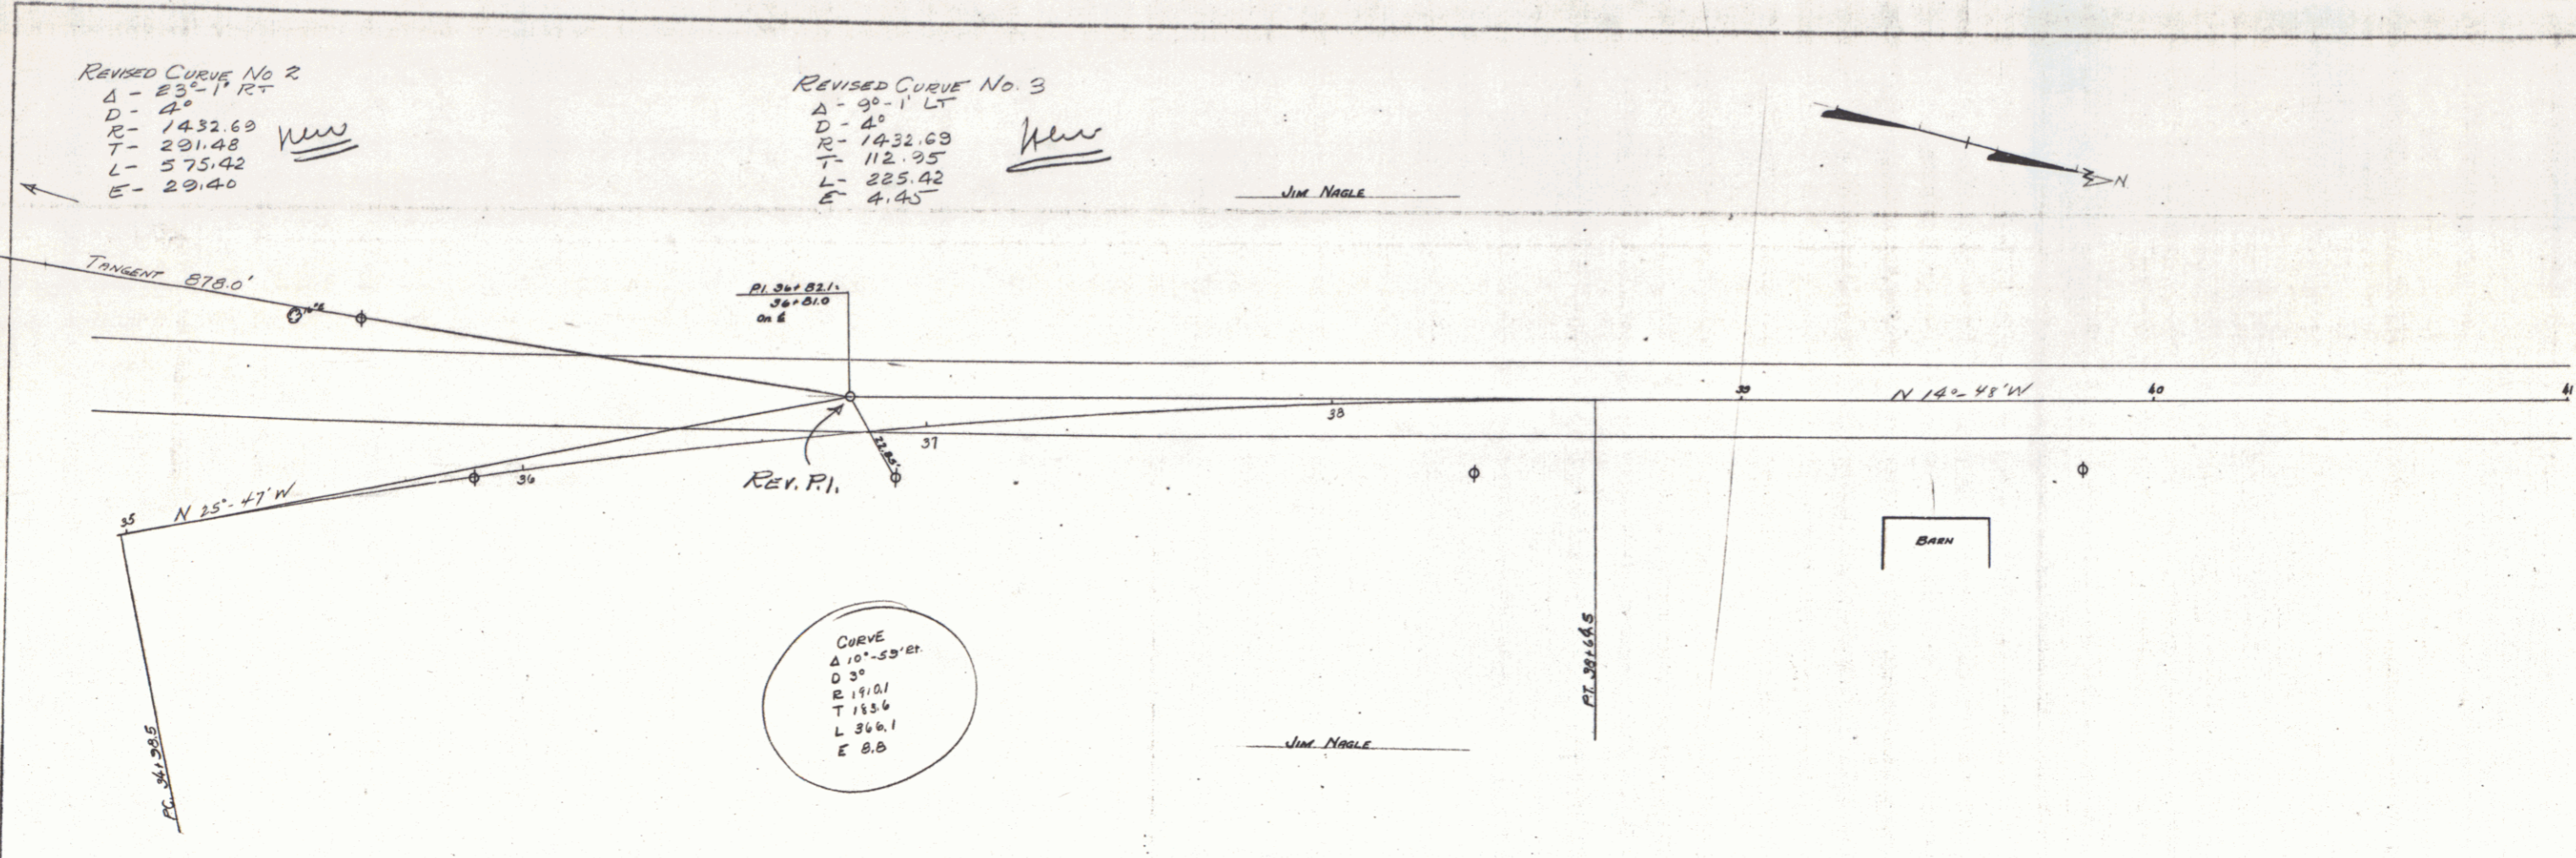

CURVE
 Δ $10^{\circ}-53'$ RT
 D $3'$
 R 191.01
 T 153.6
 L 366.1
 E 8.8

JIM NAAGLE

PROFILE	DATE	BY
NOTED	DATE	BY
REVISIONS	DATE	BY
1		
2		
3		

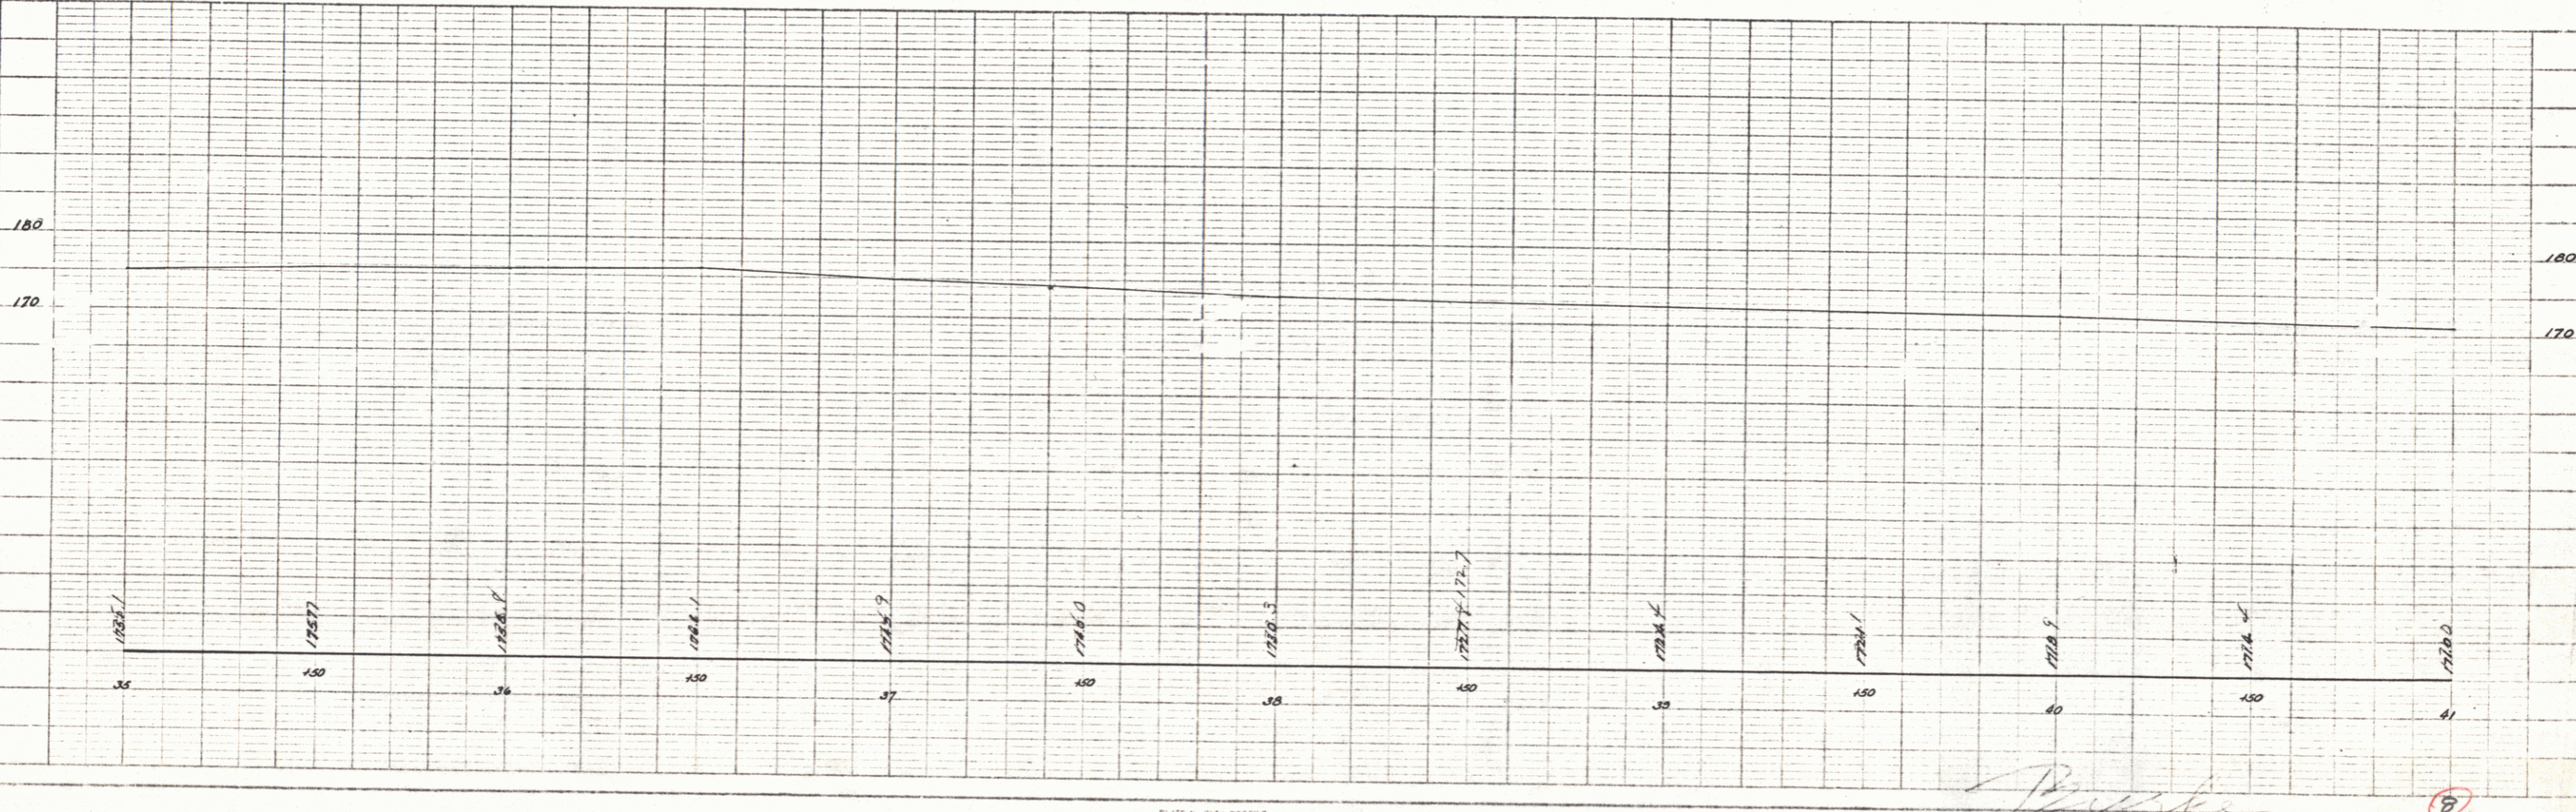


PLATE 1-PLAN-PROFILE IN P.S.A.C. STANDARD
 © 1970 BY THE ASSOCIATION OF PROFESSIONAL ENGINEERS

Handwritten signature

8