

PLAN
 DATE BOOK
 NO. SHEET
 NO. SHEETS
 PROJECT
 DRAWN BY
 CHECKED BY

PROF. PLAN
 DATE BOOK
 NO. SHEET
 NO. SHEETS
 PROJECT
 DRAWN BY
 CHECKED BY

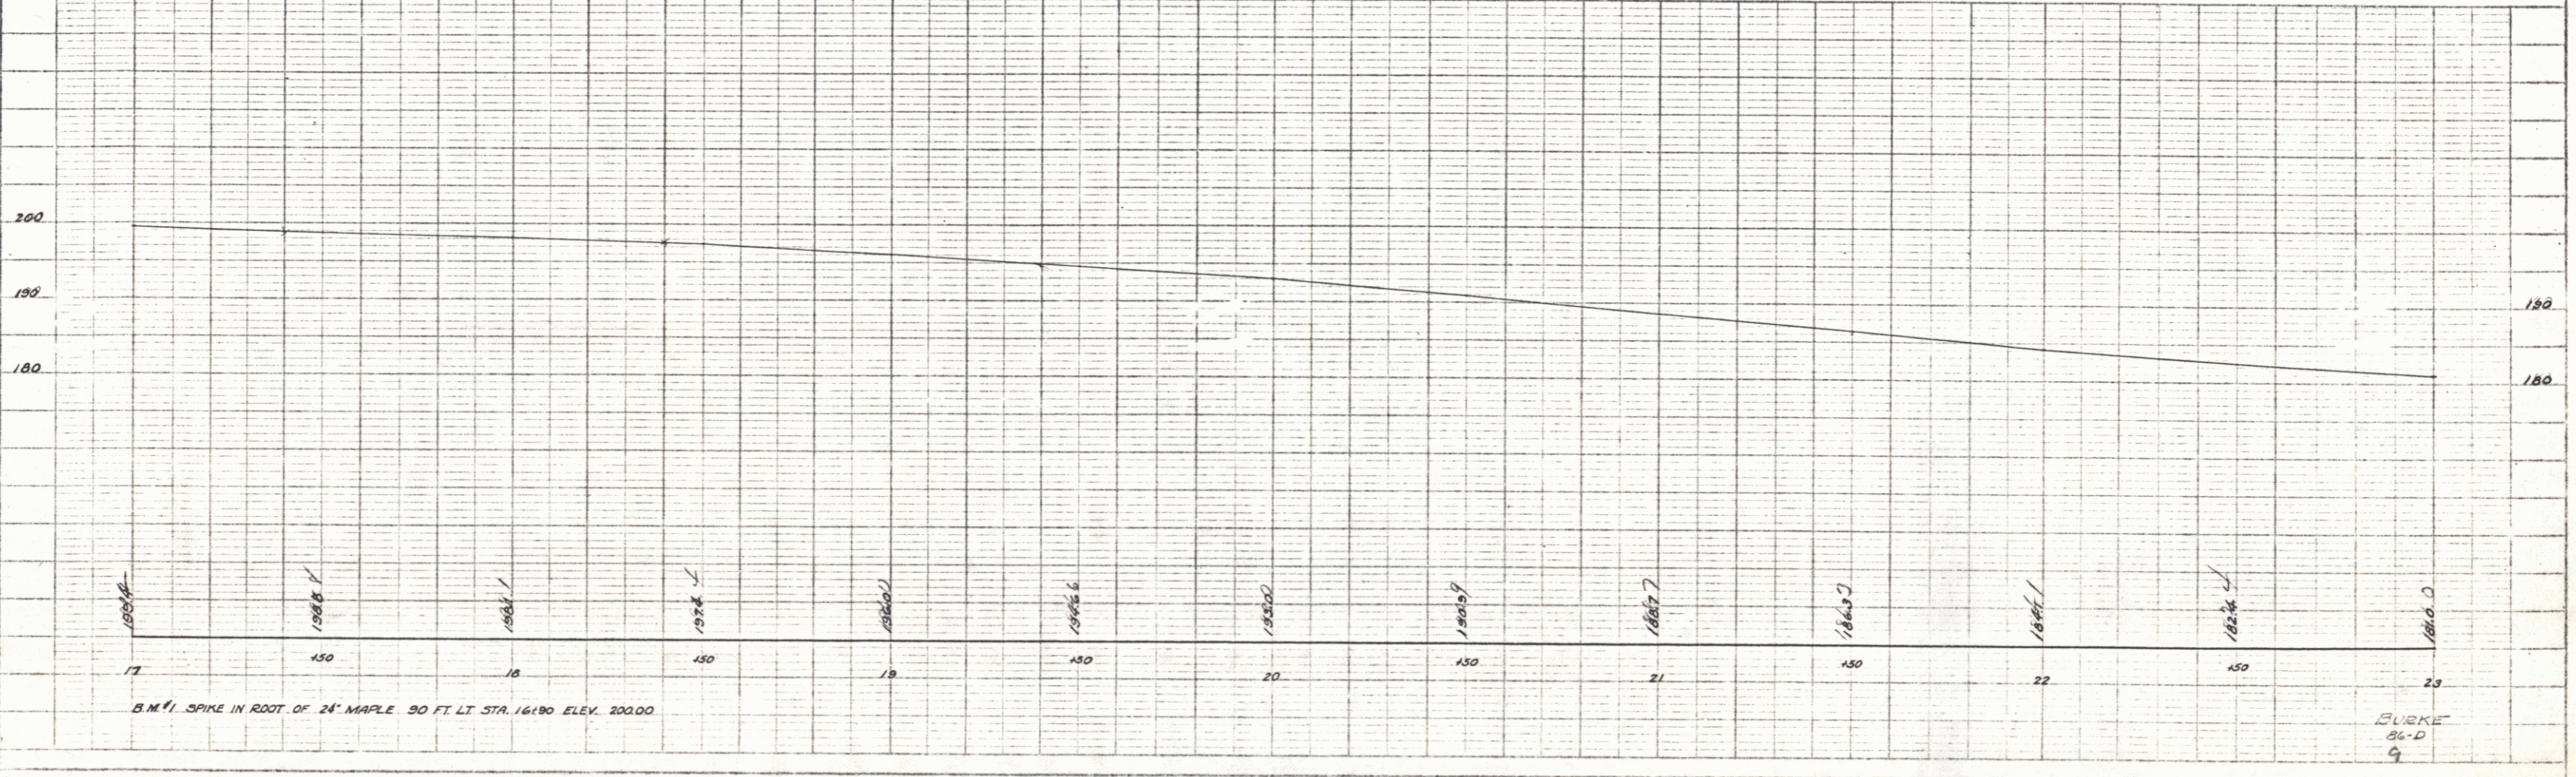
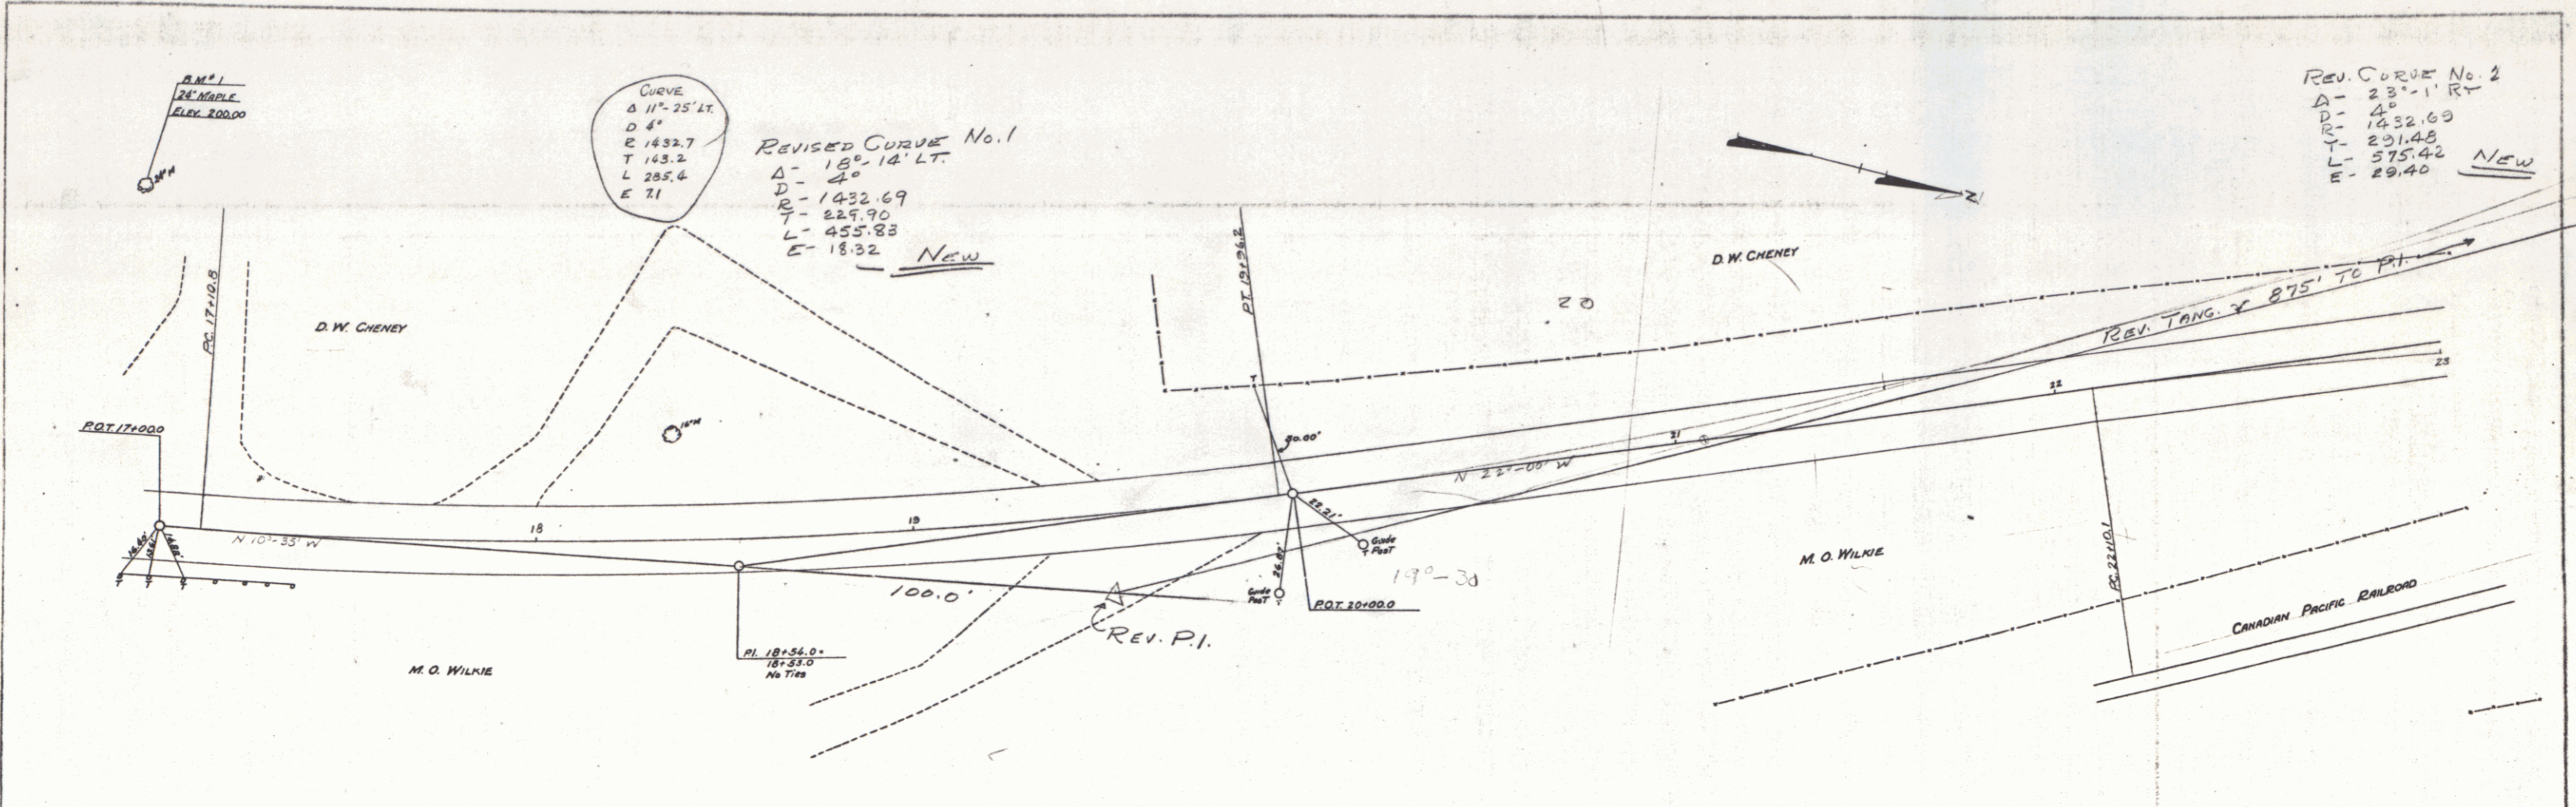


PLATE I - PLAN AND PROFILE OF ROAD AND CURVES
 DRAWN BY: [Name]
 CHECKED BY: [Name]