


PARCEL	KIND OF INSTRUMENT	DATE	GRANTOR	GRANTEE	RECORDED	REMARKS
A	Q.C.D.	3-9-33	BARTLETT ESTATE	J.P. OF Vt.	Z 784-7	3-30-33
CUL. #1	Q.C.D.	2-15-33	MRS. A.O. LEFARR	"	Z 471-9	3-17-33 805+05
A	Q.C.D.	5-27-33	MARY F. SMITH	"	Z 422	4-2-33

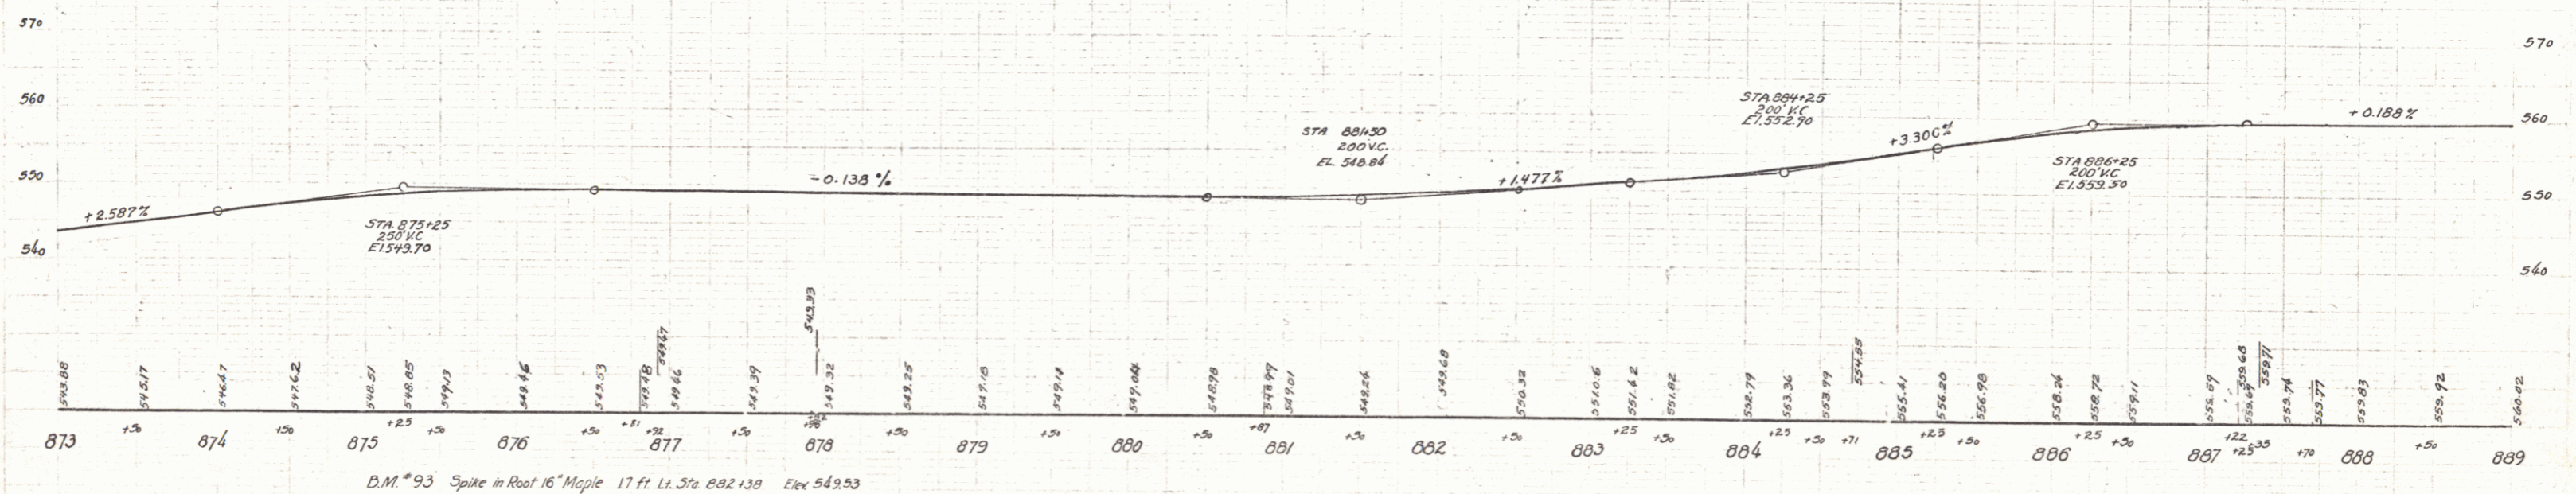

4