


PARCE INSTRUMENT DATE GRANTEE GRANTEE RECORDED REMARKS  
 A-B Q.C.O. 2-15-32 A.D. FOGG 570' N. 2 4/8 - 9 2-17-32

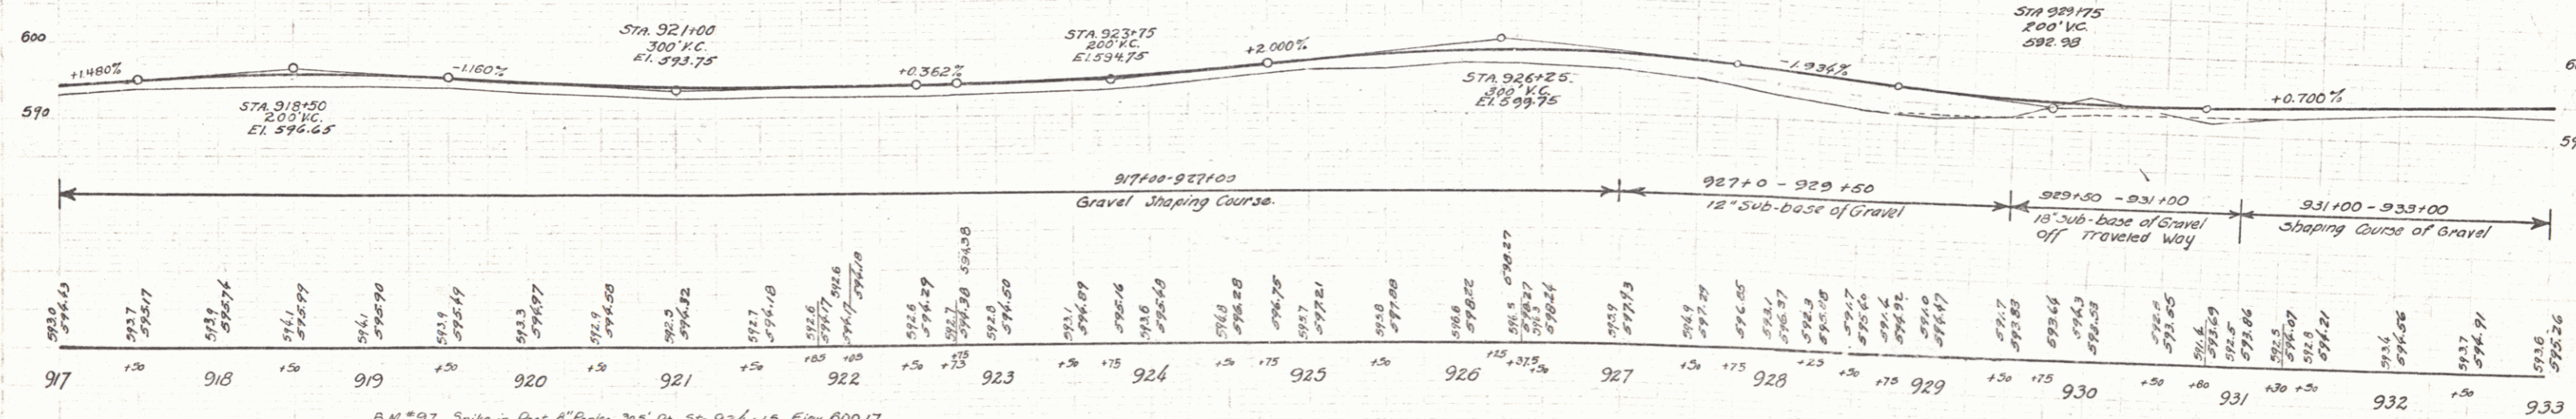

B.M. #97 Spike in Root 6" Poplar 305' Rt. Sta 926+15 Elev 600.17  
 B.M. #98 Spike in Root 6" Spruce 10' Rt. Sta 932+25 Elev 596.38