


PARCEL AND OF DATE OF GRANTER RECORDED DEEDS
 (W.F. HOLTAM) SUTTON
 ACRES C.C.D. 1-19-33 W.F. & E.A. HOLTAM STORV. E 45-8 1-21-33
 1/3 C.C.D. 2-13-33 CARROLL B. SWITZER " 27 48-2 2-17-33

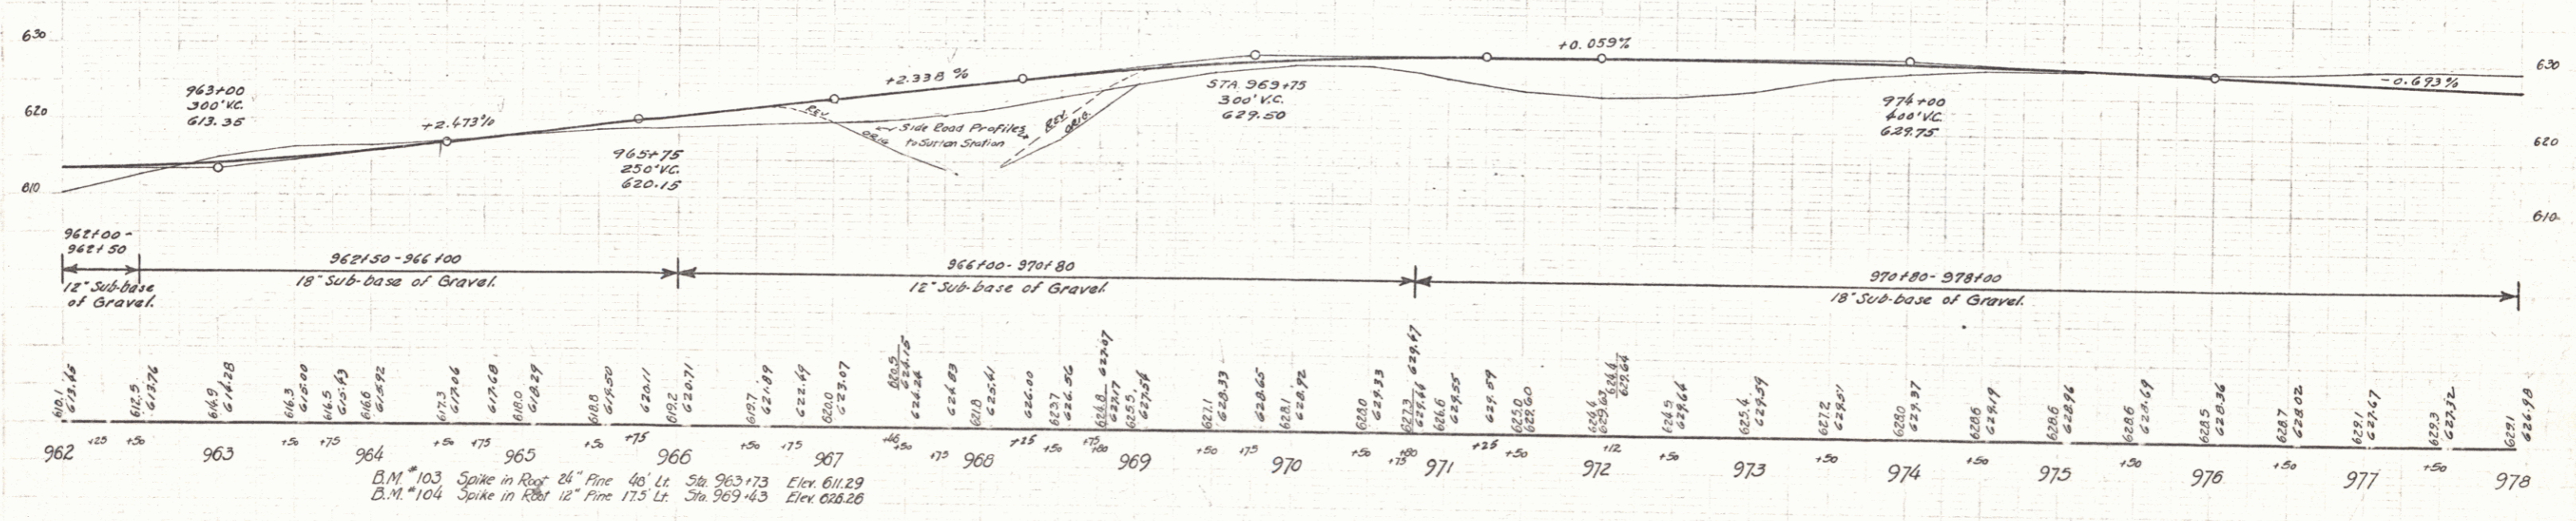

B.M. #103 Spike in Root 24" Pine 40' Lt. Sta. 963+73 Elev. 611.29
 B.M. #104 Spike in Root 12" Pine 17.5' Lt. Sta. 969+43 Elev. 628.26