
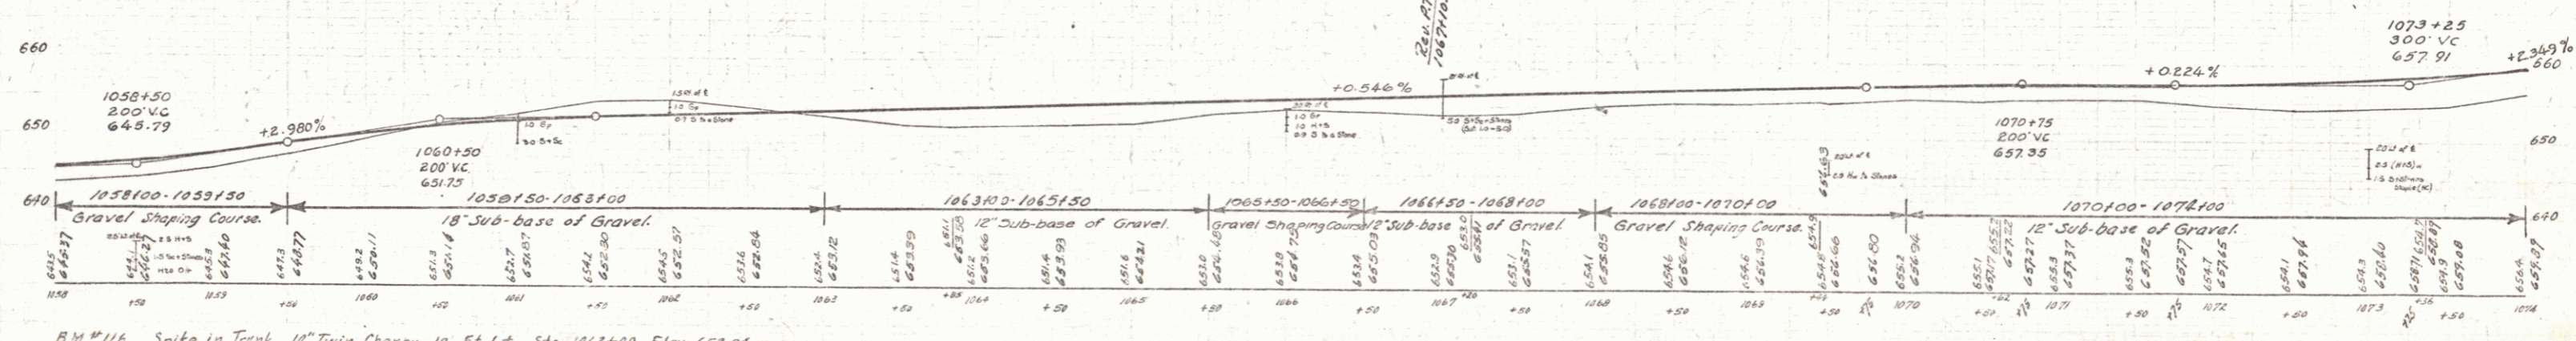


B.M.	Point	Kind of Date or Instrument	GRANTOR	GRANTEE	RECORDED	REMARKS
B.M. #114	Point Spot on Conc. Bridge Rail 10 Ft. Sta. 1046+30	Elev. 643.82				
B.M. #115	Spike in Flat 12" Spruce 23 Ft. L.T. Sta. 1056+33	Elev. 643.04				
A-B-C-D	Q.C.D. 6-19-33	WILL LAFOE		BOOK 2170N DATE CUS STA 12-5		
A-B	W.D. 6-20-33	SIMON W. CORLISS		STORY 27 312 8-7-33 1052+100		
A-B-C	Q.C.D. 6-22-33	F.S. WHITCHER		" 2 188 8-7-33 104+100		
A-B-C	Q.C.D. 6-19-33	OLIN ALLARD		" 27 315 8-7-33 CUL 125		
				" 27 314 8-7-33		

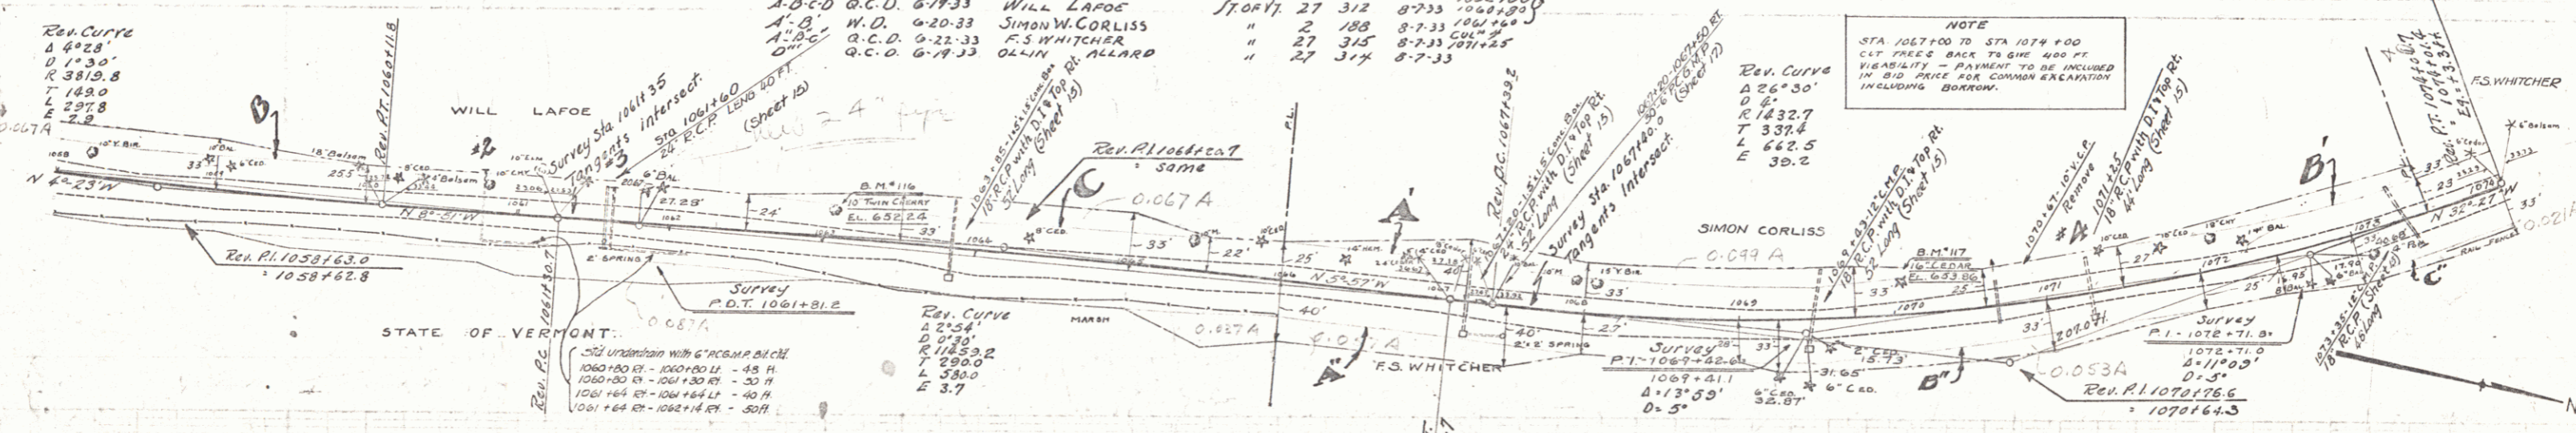

B.M.	Point	Kind of Date or Instrument	GRANTOR	GRANTEE	RECORDED	REMARKS
B.M. #116	Spike in Trunk 10" Twin Cherry 10 Ft. L.T. Sta. 1063+09	Elev. 652.24				
B.M. #117	Spike in Trunk 16" Cedar 16 Ft. L.T. Sta. 1072+04	Elev. 653.06				