

INDEX OF SHEETS

SHEET NO	TITLE PAGE
2	TYPICAL CROSS-SECTION OF IMPROVEMENT
3	PLAN AND PROFILE STA. 0+00 TO STA. 13+00
4	" " " 13+00 " " 27+00
5	" " " 27+00 " " 40+00
6	" " " 40+00 " " 53+00
7	" " " 53+00 " " 66+78.7
8-17	CROSS SECTIONS

FED. ROAD DIST. NO.	STATE	FED. AID PROJ. NO.	FISCAL YEAR	SHEET NO.	TOTAL SHEETS
9	VT.	55A	1953	1	7

STATE OF VERMONT
STATE HIGHWAY DEPARTMENT

PLAN AND PROFILE OF PROPOSED
STATE HIGHWAY
FEDERAL AID PROJECT


TOWN OF SUTTON
CRYSTAL LAKE ROAD
FROM UNDERPASS EAST TO CROSSING

Pin # 998226
Route: US 5
Project: FAP 55A

SCALE: PLAN: 1 INCH = 50 FEET
PROFILE: HORIZONTAL 1 IN. = 50 FT. VERT. 1 IN. = 10 FT.
CROSS SECTIONS: 1 INCH = 5 FEET



(To Be Returned to R.O.W. Division)
US
PERMIT
EIGHT-O'-WAY DIVISION

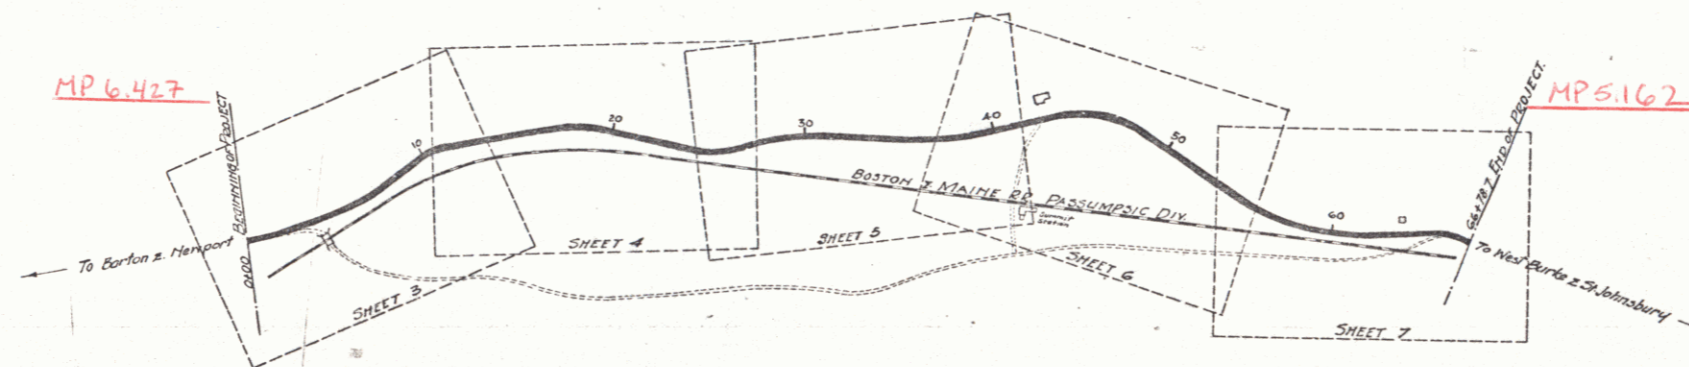

CONVENTIONAL SIGNS

- COUNTY LINE
- TOWN LINE
- FENCE LINE
- STONE WALL
- UNFENCED PROPERTY
- GUARD RAIL
- TRAVELED WAY
- RAILROAD
- RETAINING WALL
- CENTER & SURVEY LINE
- CULVERT
- DROP INLET
- TROLLEY POLE
- POWER POLE
- TELEPHONE POLE
- TREES
- HEDGE

- GROUND ELEVATION
- GRADE ELEVATION
- CURVE DATA
- DEFLECTION ANGLE Δ
- DEGREE OF CURVE D.
- RADIUS OF CURVE R.
- TANGENT DISTANCE T.
- LENGTH OF CURVE L.
- EXTERNAL DISTANCE E.
- POINT OF INTERSECTION P.I.
- POINT OF CURVE P.C.
- POINT OF TANGENT P.T.

LAYOUT
SCALE: 1 IN. = 500 FT.

SUBMITTED BY ORDER OF THE STATE HIGHWAY BOARD
CHIEF ENGINEER DEPARTMENT OF HIGHWAYS
RECOMMENDED
DISTRICT ENGINEER BUREAU OF PUBLIC ROADS
RECOMMENDED FOR APPROVAL
CHIEF ENGINEER BUREAU OF PUBLIC ROADS
APPROVED
DIRECTOR BUREAU OF PUBLIC ROADS

111123

DIST. # 7 PLANS