

DIST. ROAD	STATE	FED. AID	FISCAL	DATE	TOTAL
001	2	0000	0000	00	00

PLAN
 DATE: 11/11/58
 DRAWN BY: [Signature]
 CHECKED BY: [Signature]

PROFILE
 DATE: 11/11/58
 DRAWN BY: [Signature]
 CHECKED BY: [Signature]

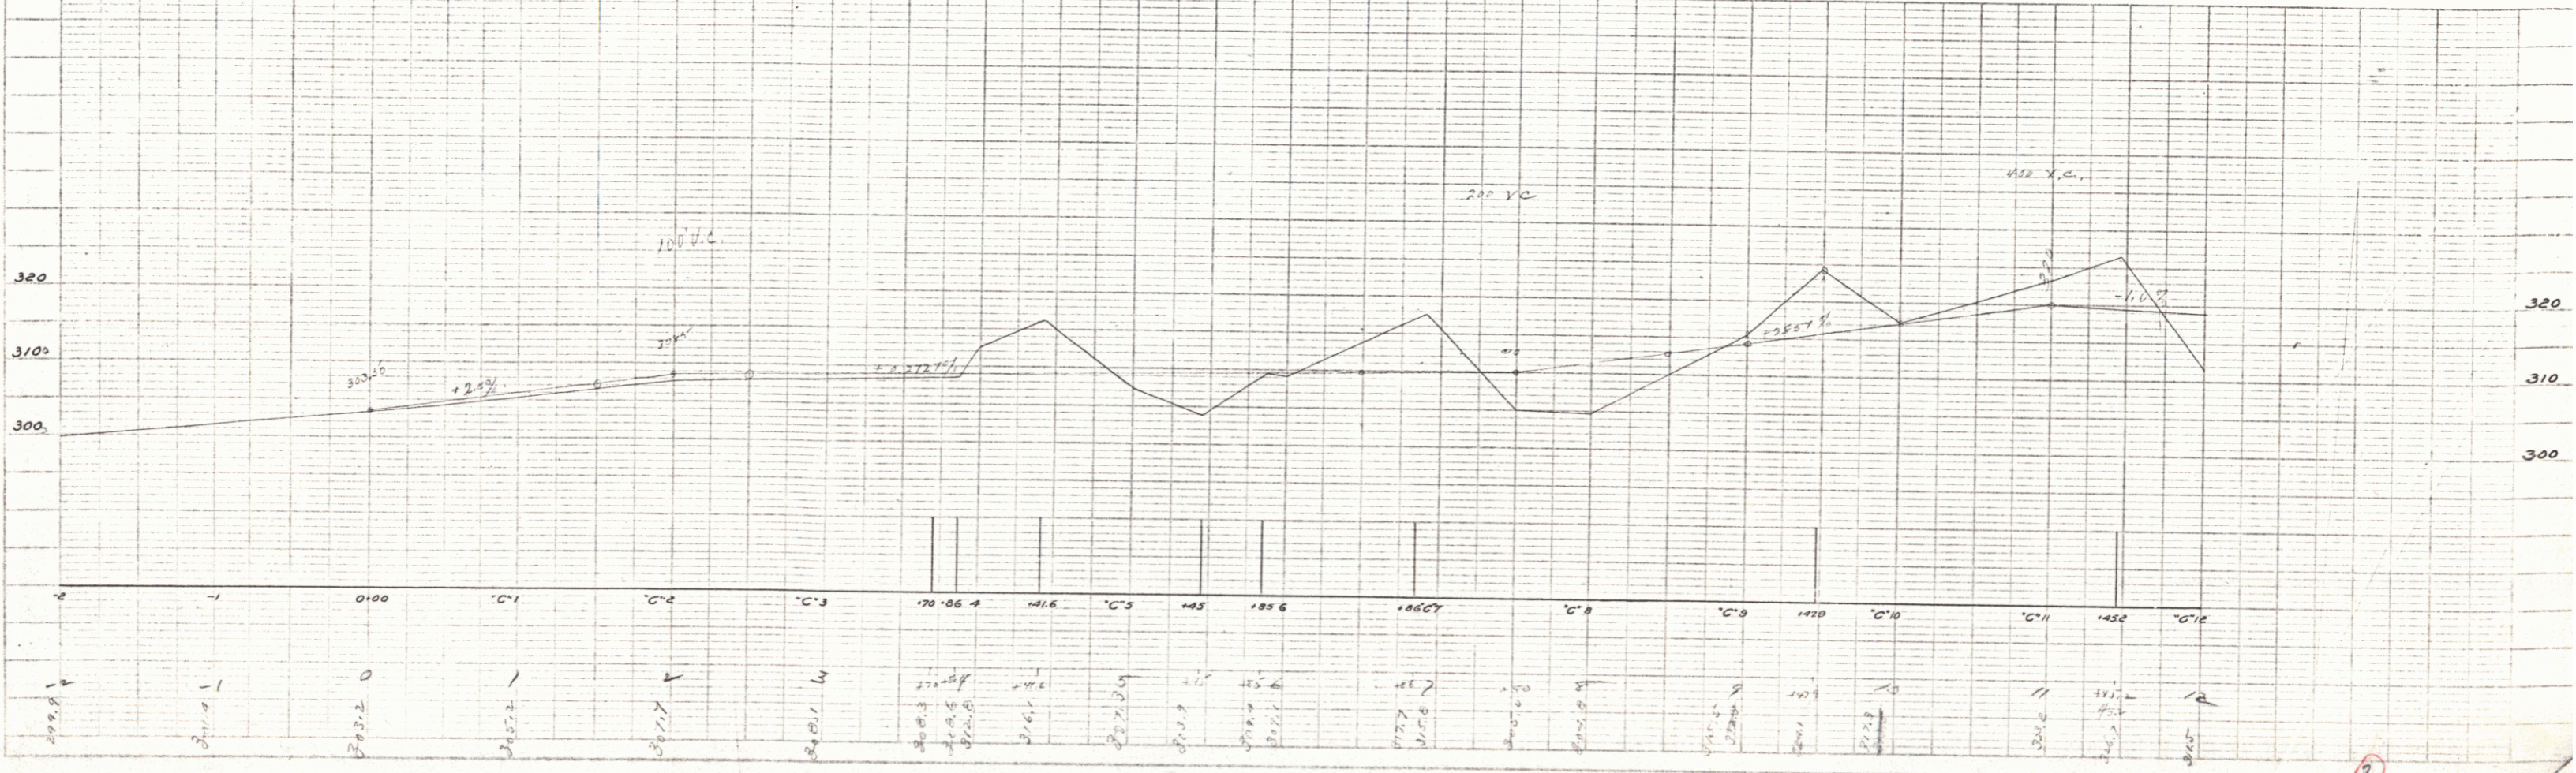
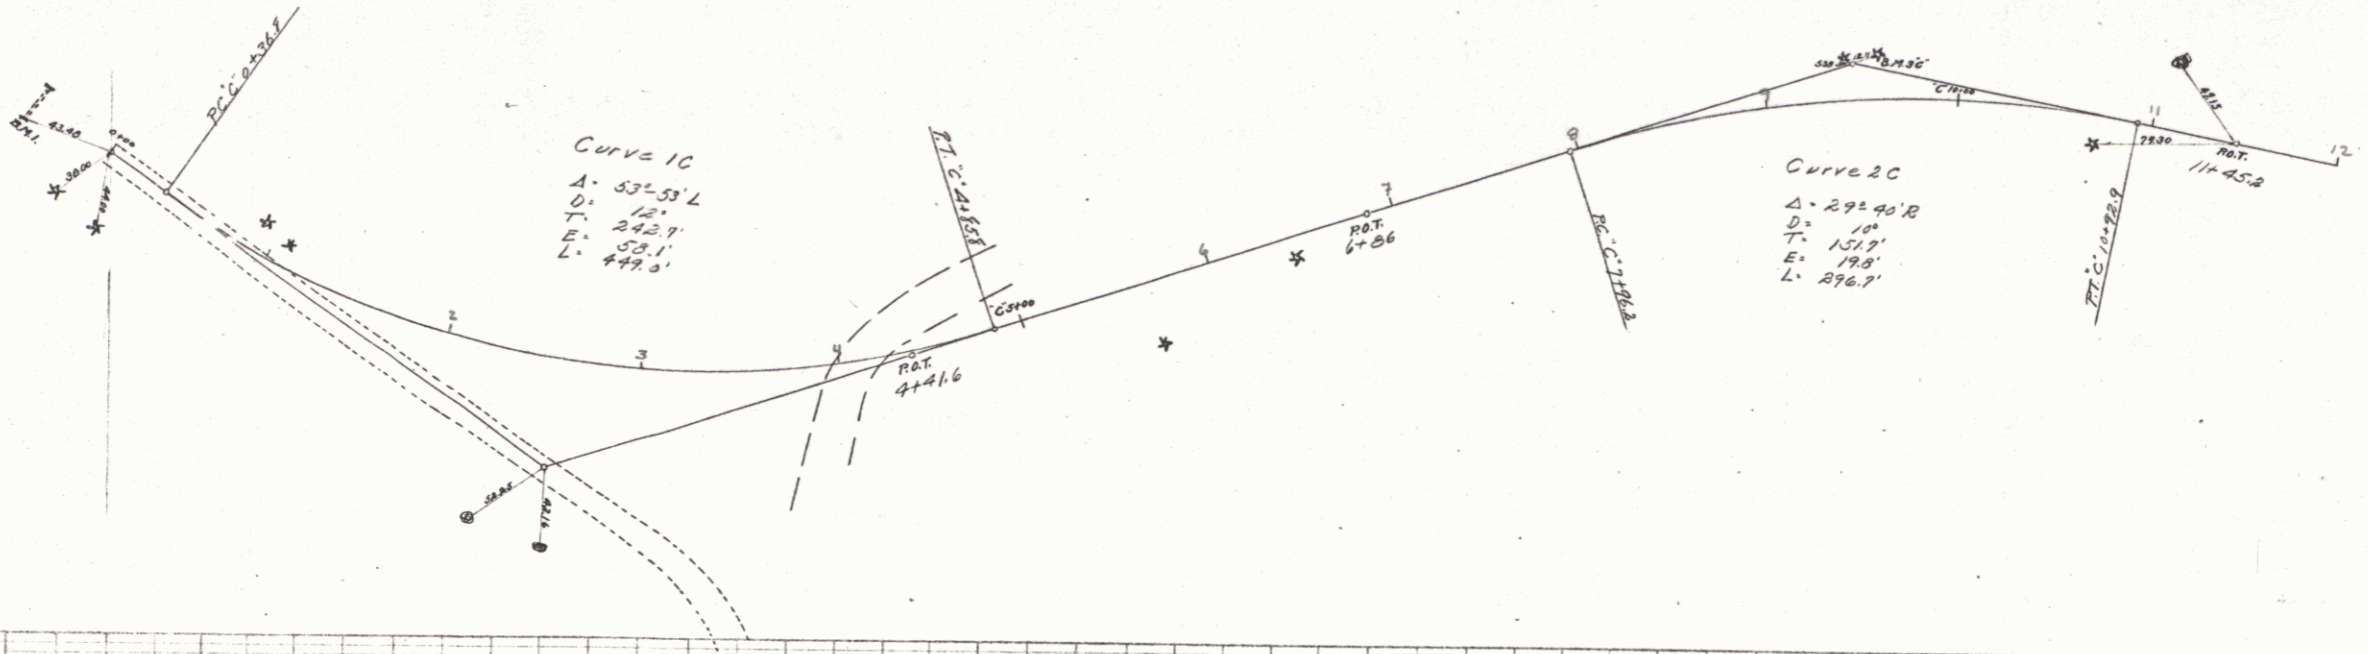


PLATE 2 - PLAN-PROFILE & VERTICAL CURVES
 NORTH BY LETTER OR REF. ONLY

Author: [Signature] 11/11/58