
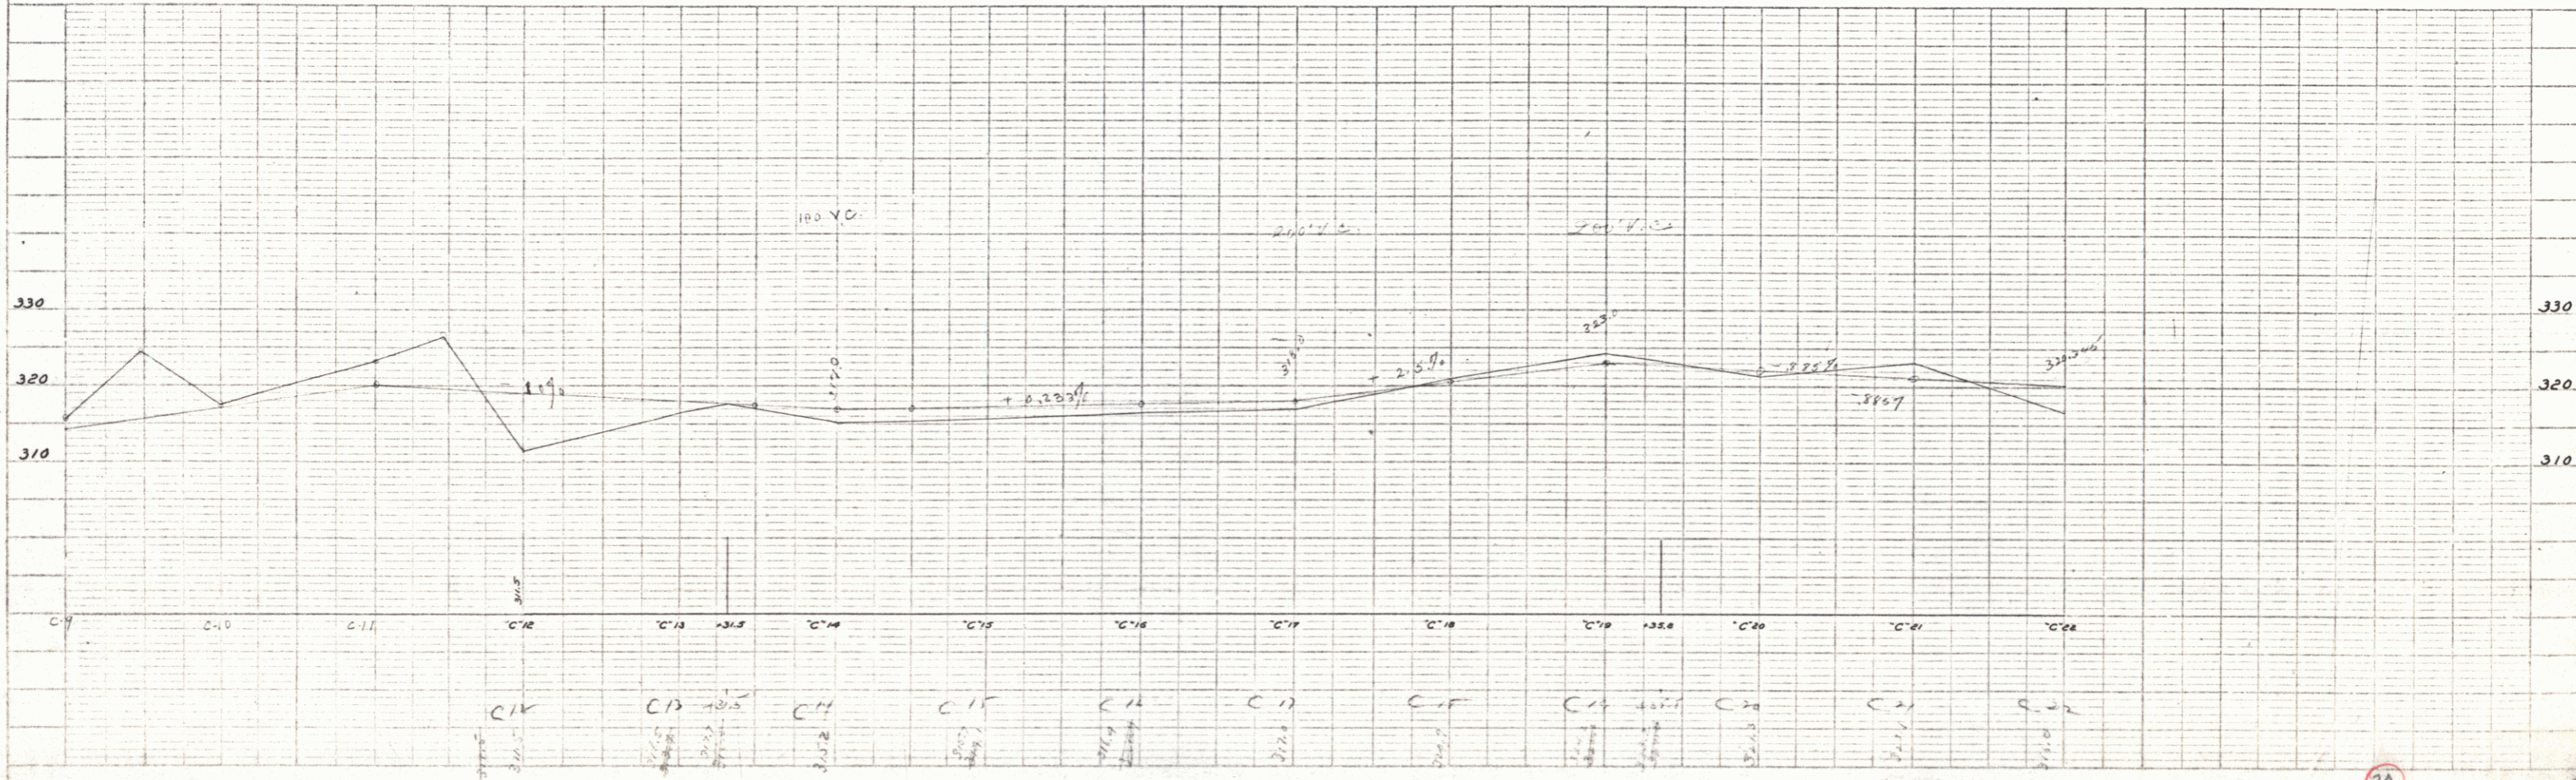


FED. ROAD DIST. NO.	STATE	FED. AID PROJ. NO.	FISCAL YEAR	SHEET NO.	TOTAL SHEETS

PROJECT: *W. 2nd St. Bridge*
 SHEET NO.: *2A*
 DATE: *10/1/58*
 DRAWN BY: *J. J. [unclear]*
 CHECKED BY: *[unclear]*

PROJECT: *W. 2nd St. Bridge*
 SHEET NO.: *2A*
 DATE: *10/1/58*
 DRAWN BY: *J. J. [unclear]*
 CHECKED BY: *[unclear]*

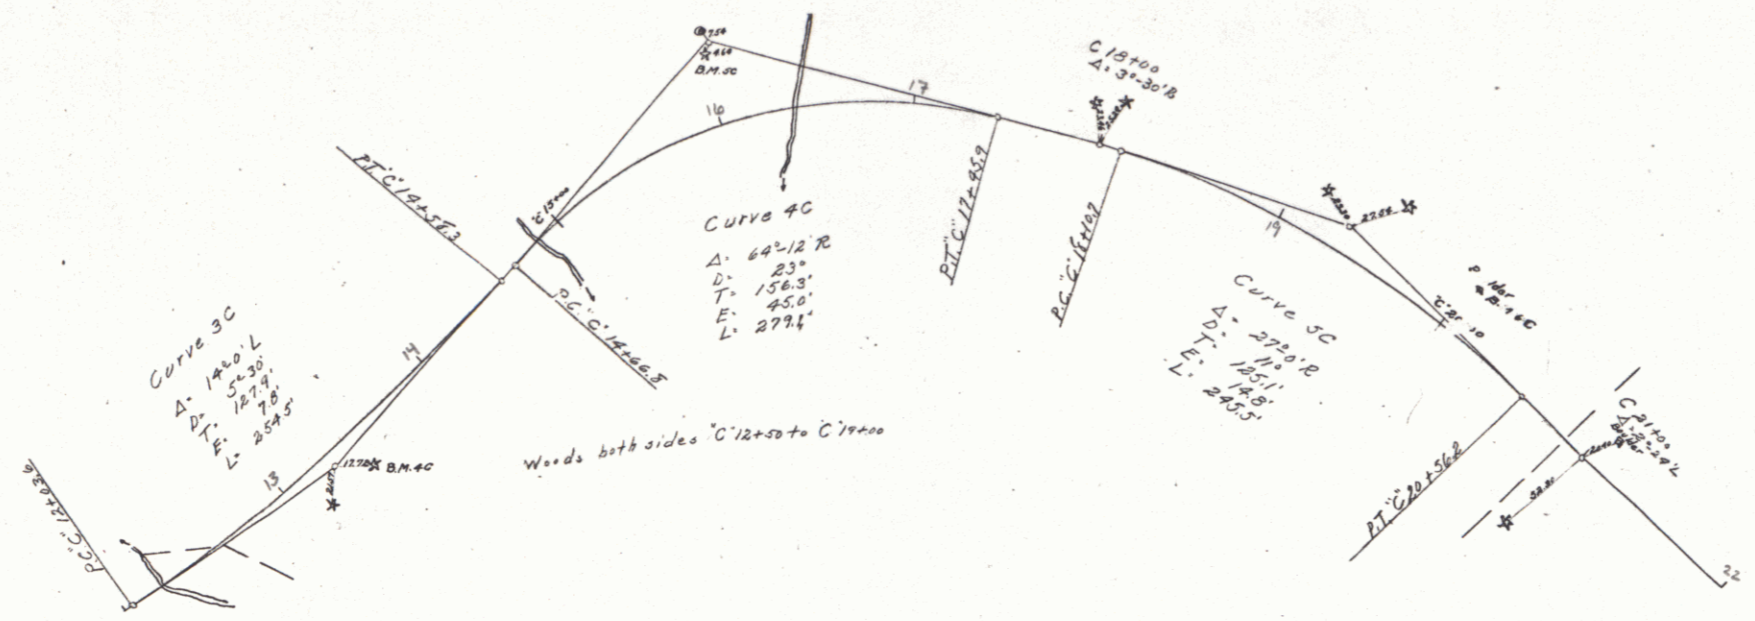

J. J. [unclear]