

FED. ROAD DIST. NO.	STATE	FED. PROJ. NO.	FISCAL YEAR	SHEET NO.	TOTAL SHEETS

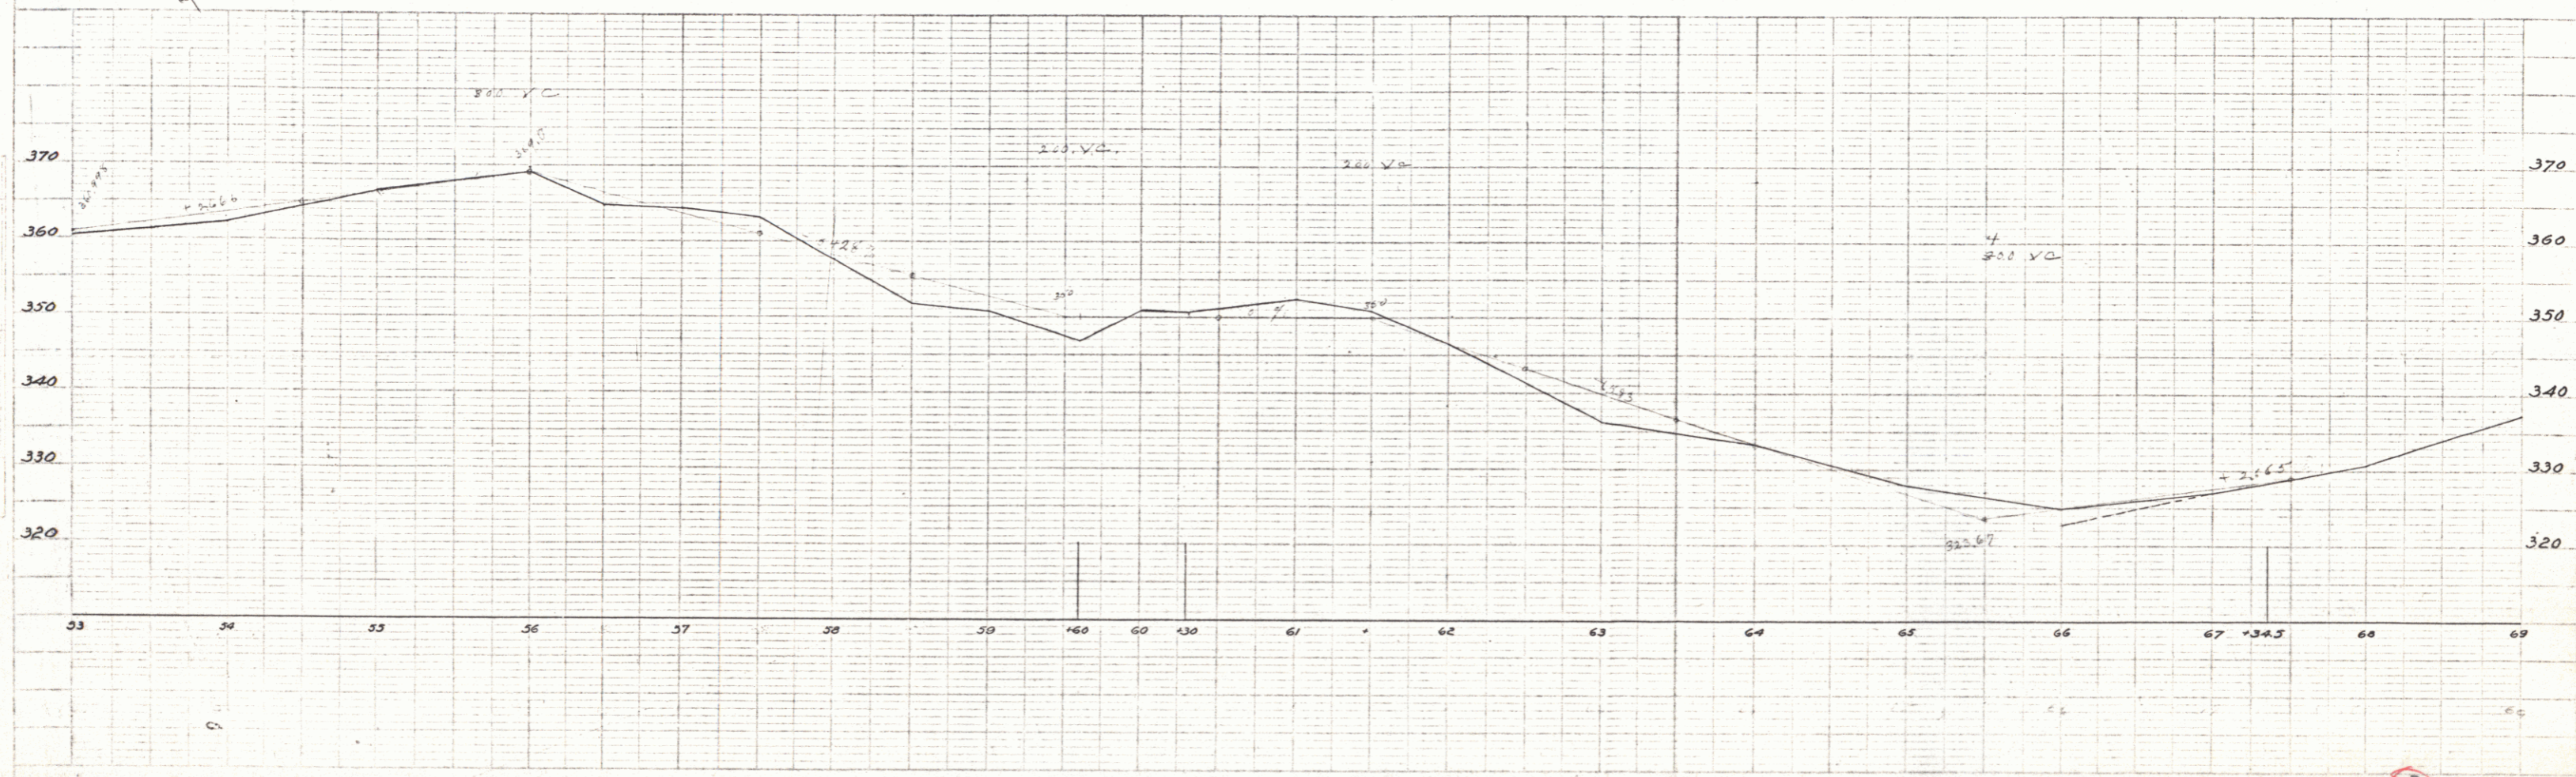
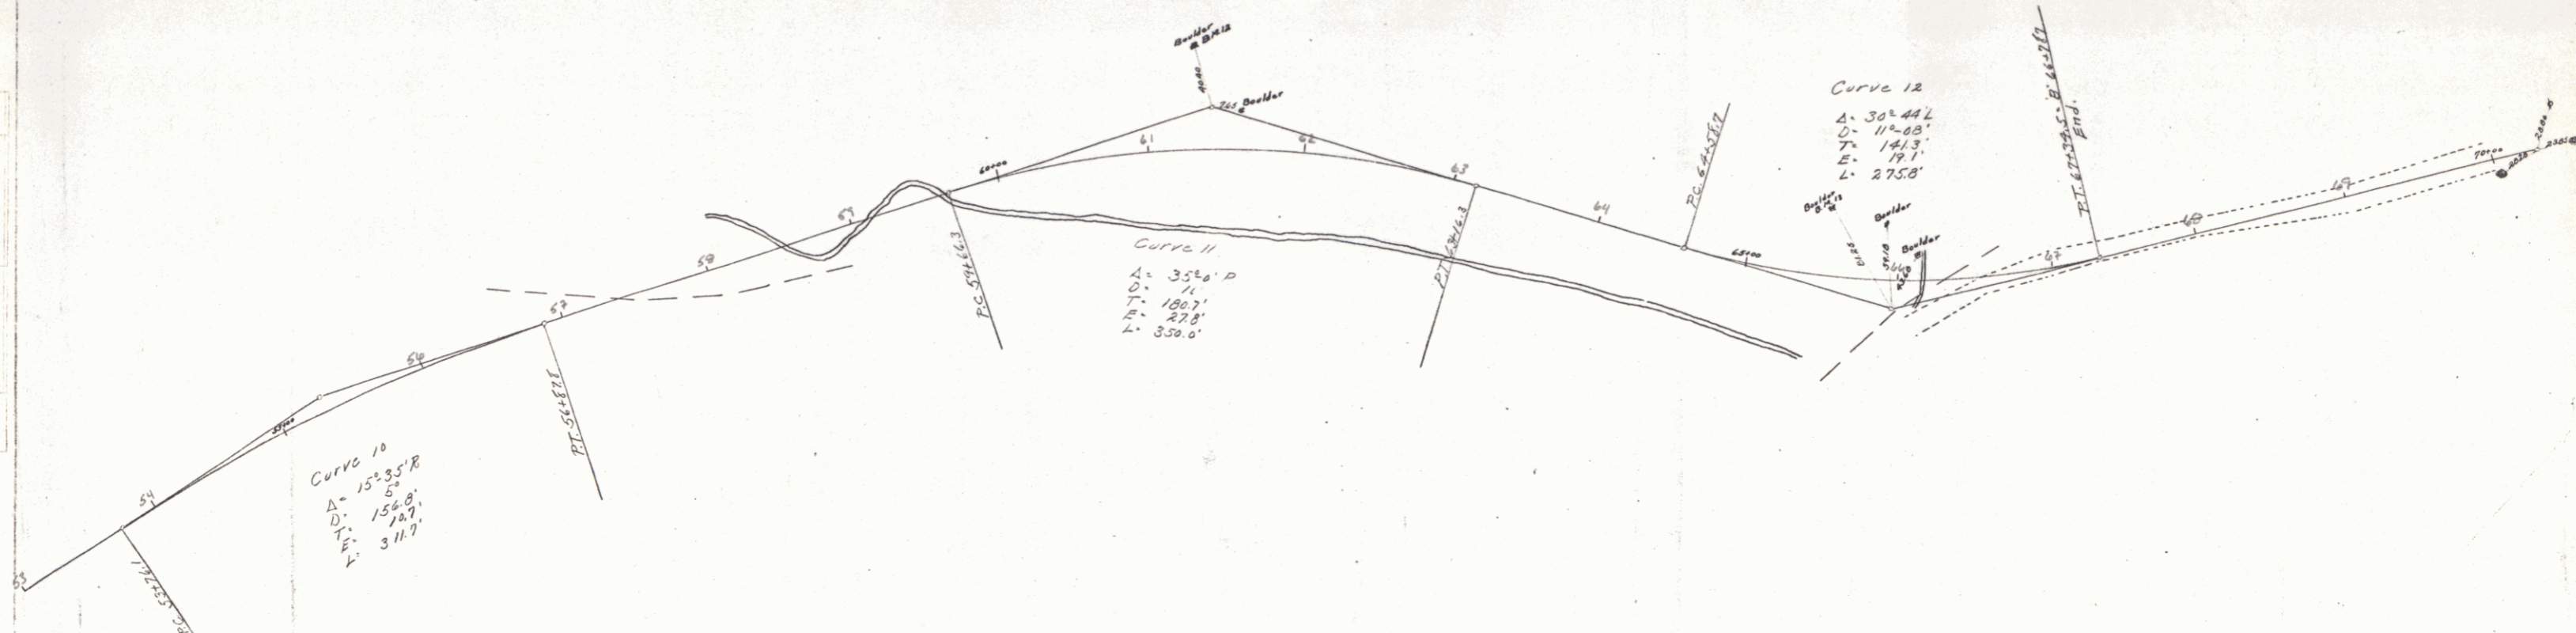


PLATE 10-11-10-11-12-99-100

20

Station 500' 0" 12