
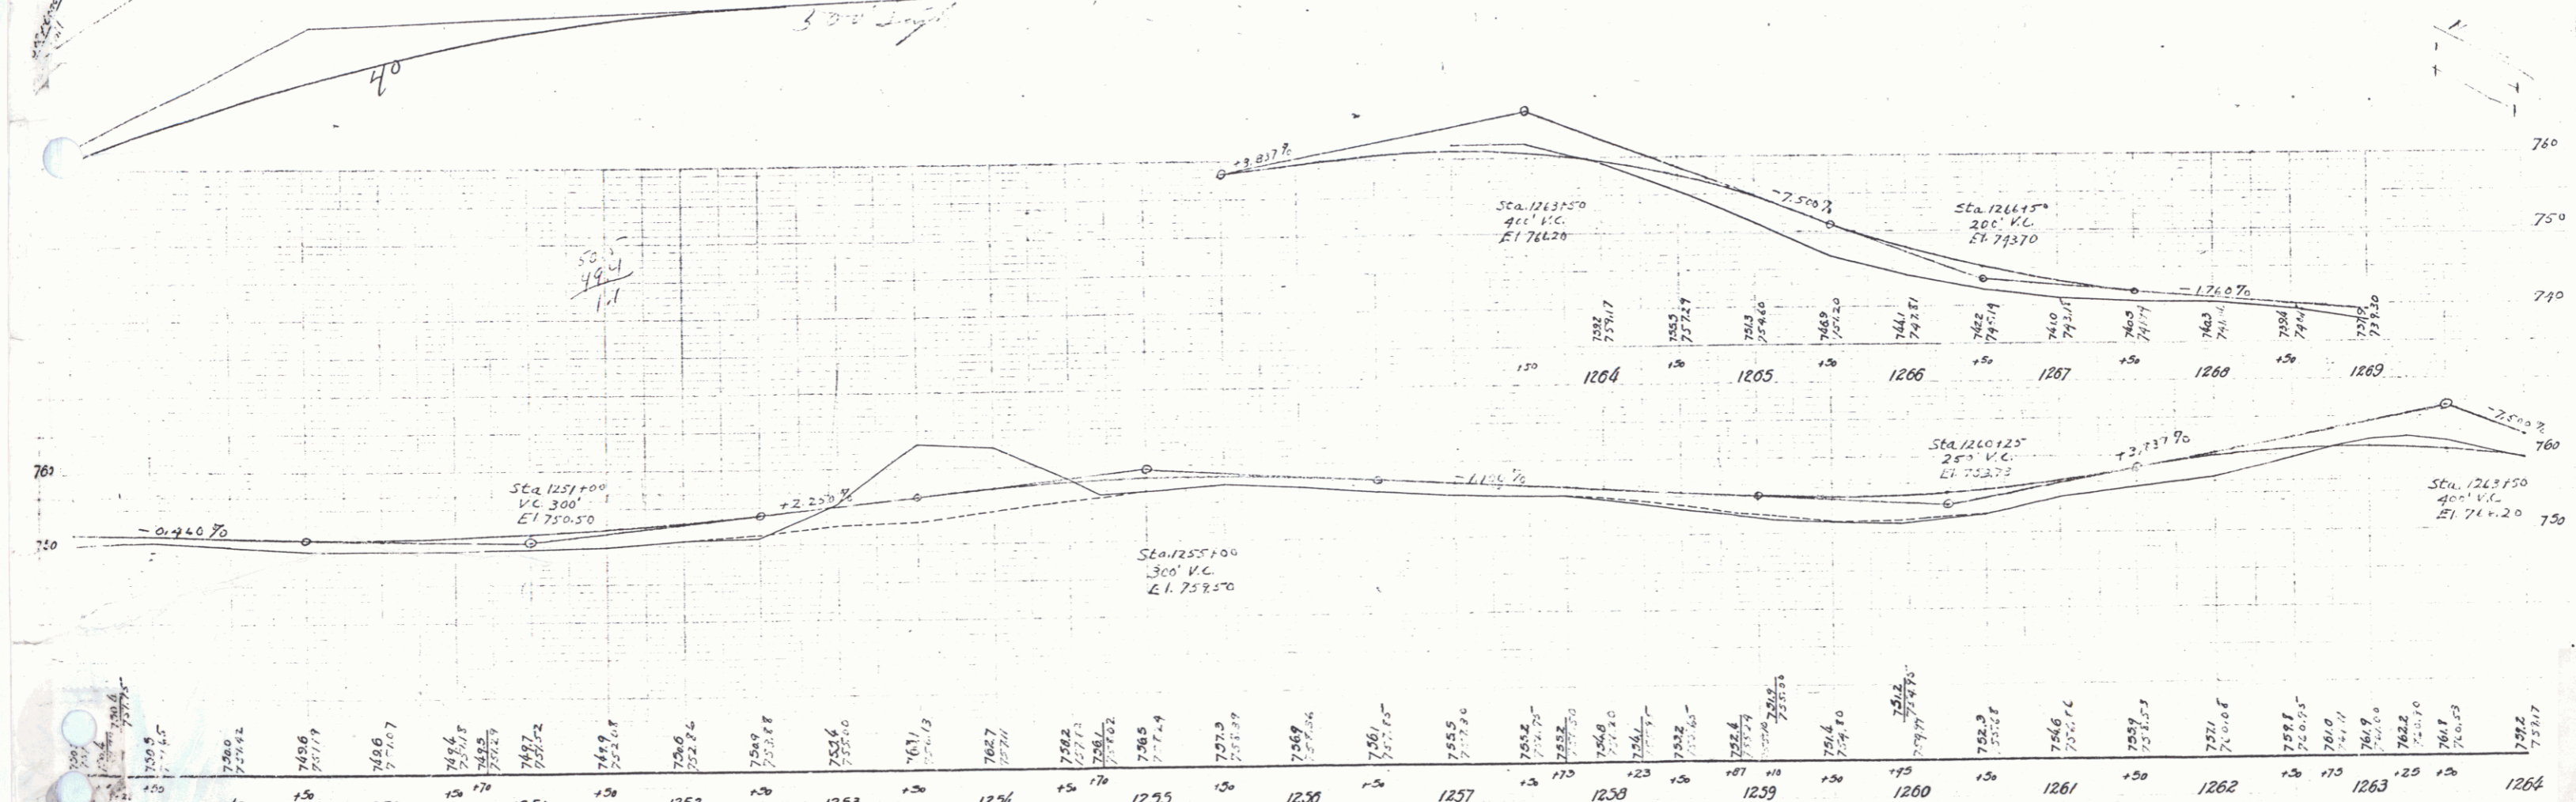


Parcel	Kind of Instrument	Date of Instrument	Grantor	Grantee	Recorded	Remarks
A-B	G.C.D.	1-19-32	G.M. Hecker Est.	St. of Vt. No. 267	Book Page Date	1-31-33
A, B, C, D	G.C.D.	1-19-32	E.H. Tibbets	No. 40	Page 266	1-31-33

13.3.110 FISCAL SHEET TOTAL  
 DIST. STATE NO. YEAR NO. SHEET  
 11 E-55F 1932

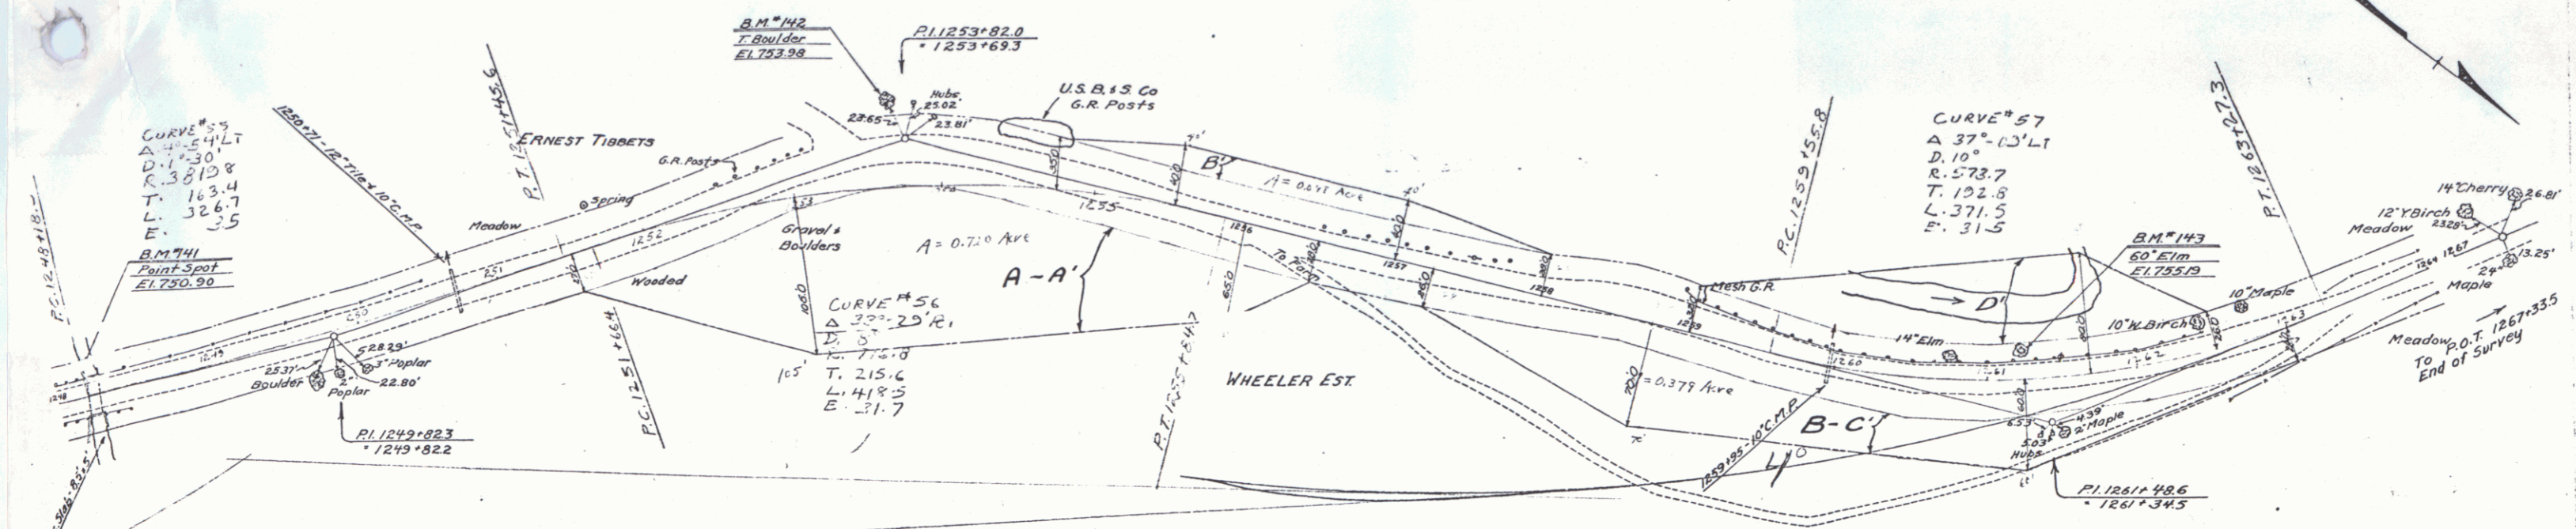

Station	Elevation
1249	750.0
1250	750.2
1251	750.7
1252	751.0
1253	751.5
1254	752.0
1255	752.5
1256	753.0
1257	753.5
1258	754.0
1259	754.5
1260	755.0
1261	755.5
1262	756.0
1263	756.5
1264	757.0

B.M. #141 Point Spot on Conc. Well Wall 13' Lt. Sta. 1248+19 Elev. 750.90  
 B.M. #142 Point Spot on Boulder 53' Lt. Sta. 1253+68 Elev. 753.98  
 B.M. #143 Spike in Root 60' Elm 14' Lt. Sta. 1266+25 Elev. 755.19

SUTTON  
 SERIES E-55F  
 SHEET 13 OF 5