
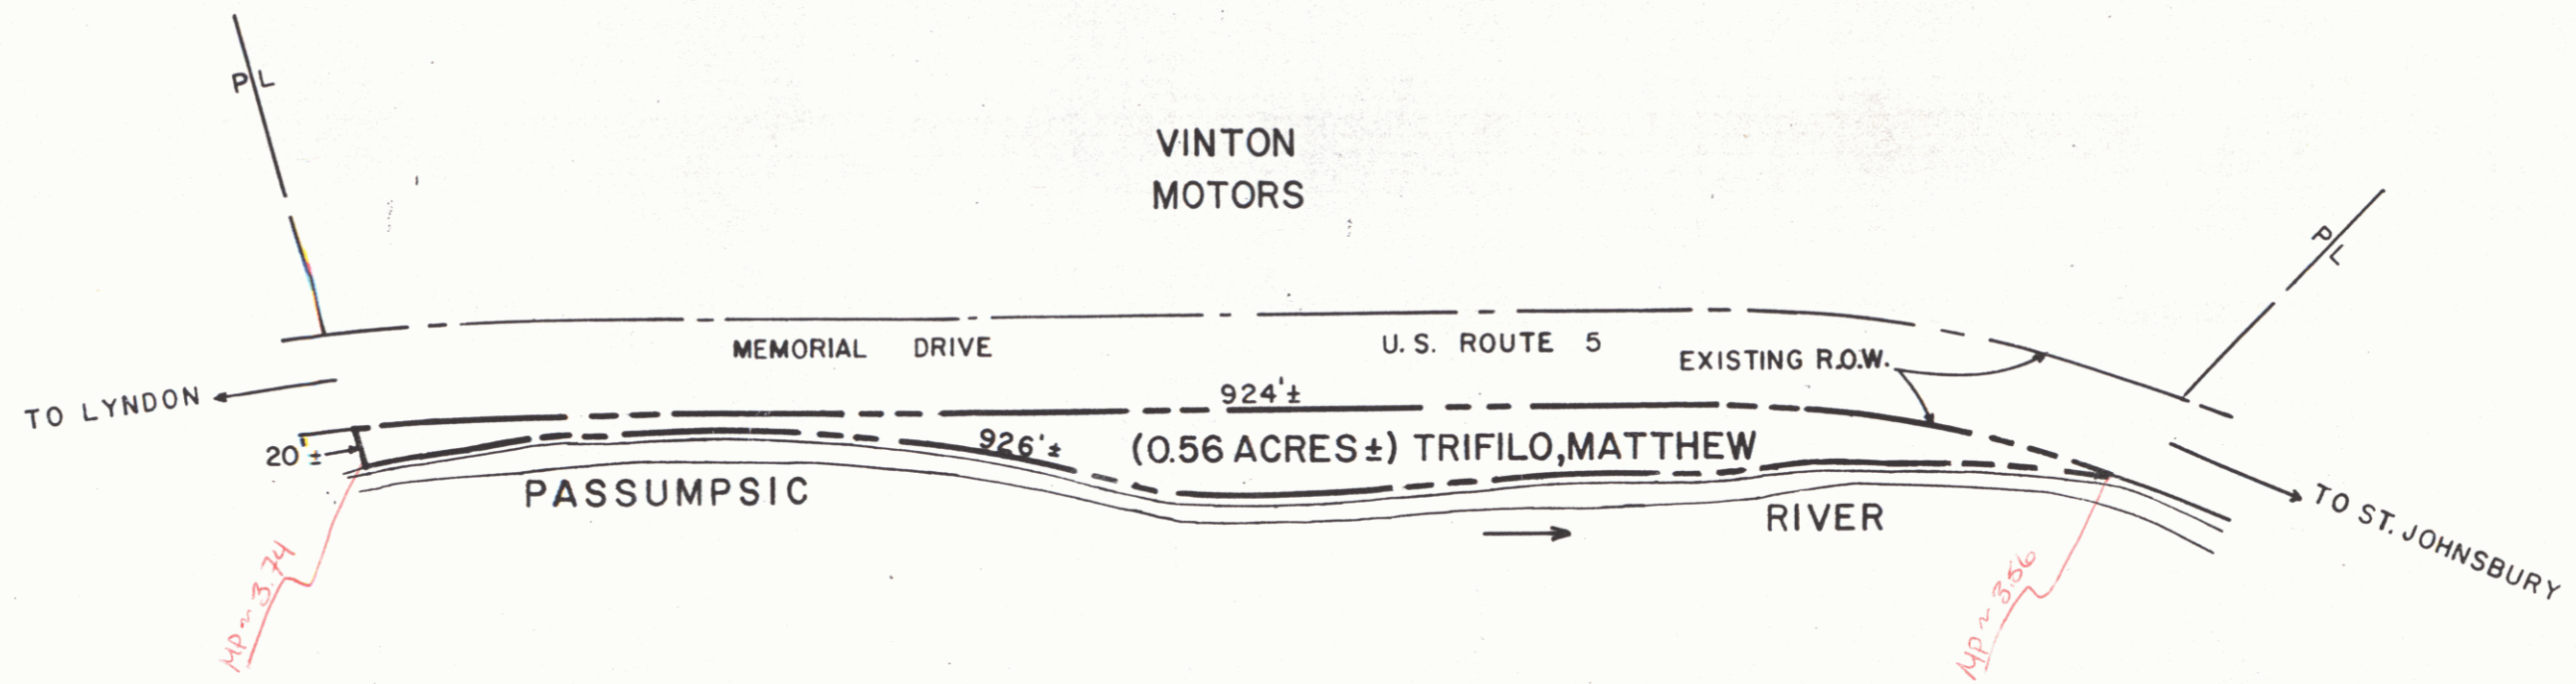


TRIFILO TO STATE OF VERMONT
WD DATED MAY 18, 1979
RECORDED IN BK. 164 PG. 475/476

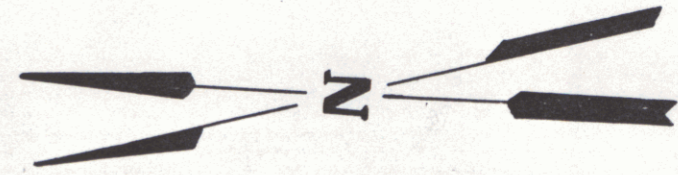

Pin # 992229

REF. ST. JOHNSBURY-LYNDON F 115A
SHEETS 7 & 8 OF 123

STATE OF VERMONT
AGENCY OF TRANSPORTATION

TOWN OF ST. JOHNSBURY

Route: US5

PROJECT MA 3952

SHEET 1

APPROX. SCALE 1"=100'

DATE 3-26-79

DRAWN BY
D.O. NEWHALL

