


STA. 100+50
100' VC.
ELEV. 157.20

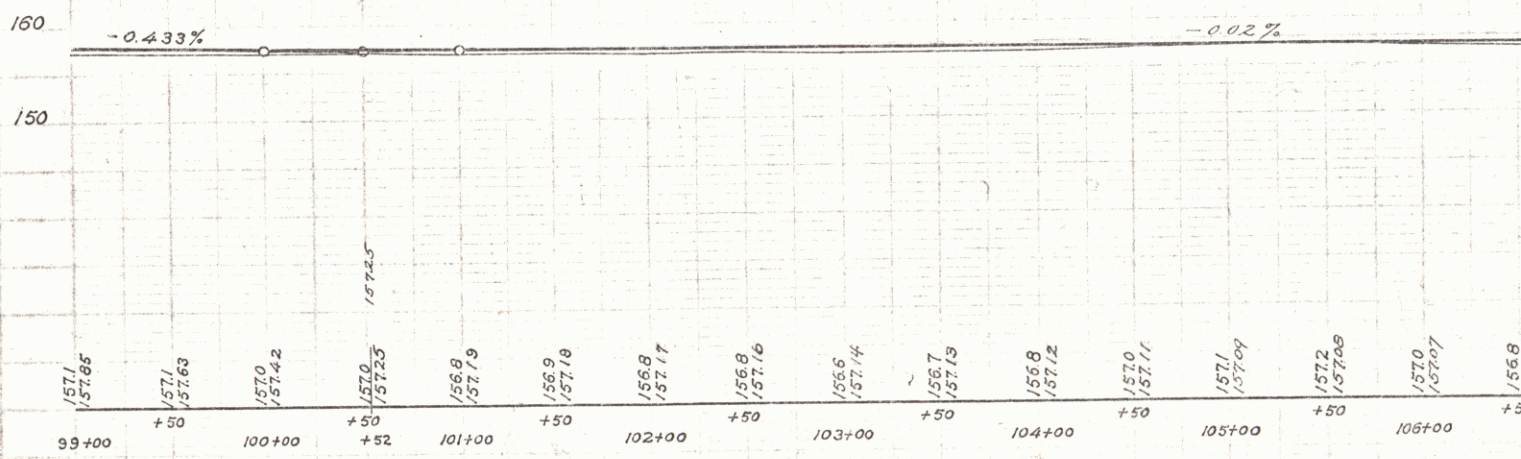

BM II S.E. COR. GAS PUMP FOUNDATION LT. STA. 109+79 ELEV. 157.85