

130+90.0


REV. P.C. 1/3

F 381.7
E 6.3

653

Section Sta
to be recross
15 5

STA. 131+25
200' V.C.
ELEV. 163.08

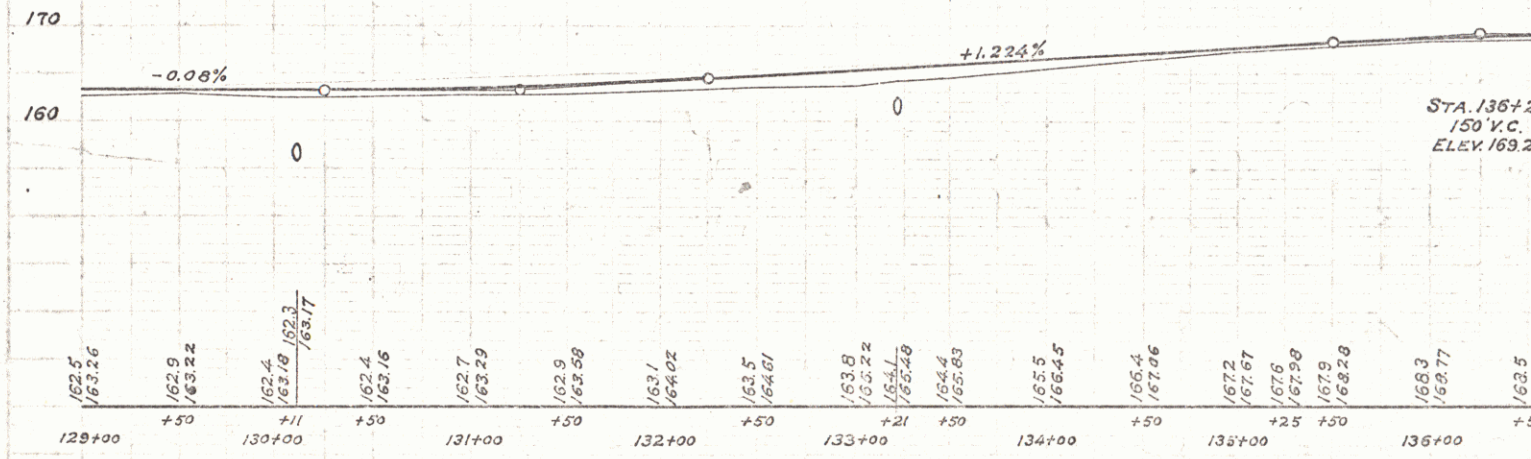

STA. 136+25
150' V.C.
ELEV. 169.20

B.M. 12 SPIKE IN TRUNK 12° ELM 17 FT. LT. STA. 130+42 ELEV. 162.74
B.M. 13 DRILL HOLE S.W. COR. BRIDGE ABUTMENT ELEV. 169.07