


L = 290.5
 E = 6.0
 Old
 Replace with
 See 50

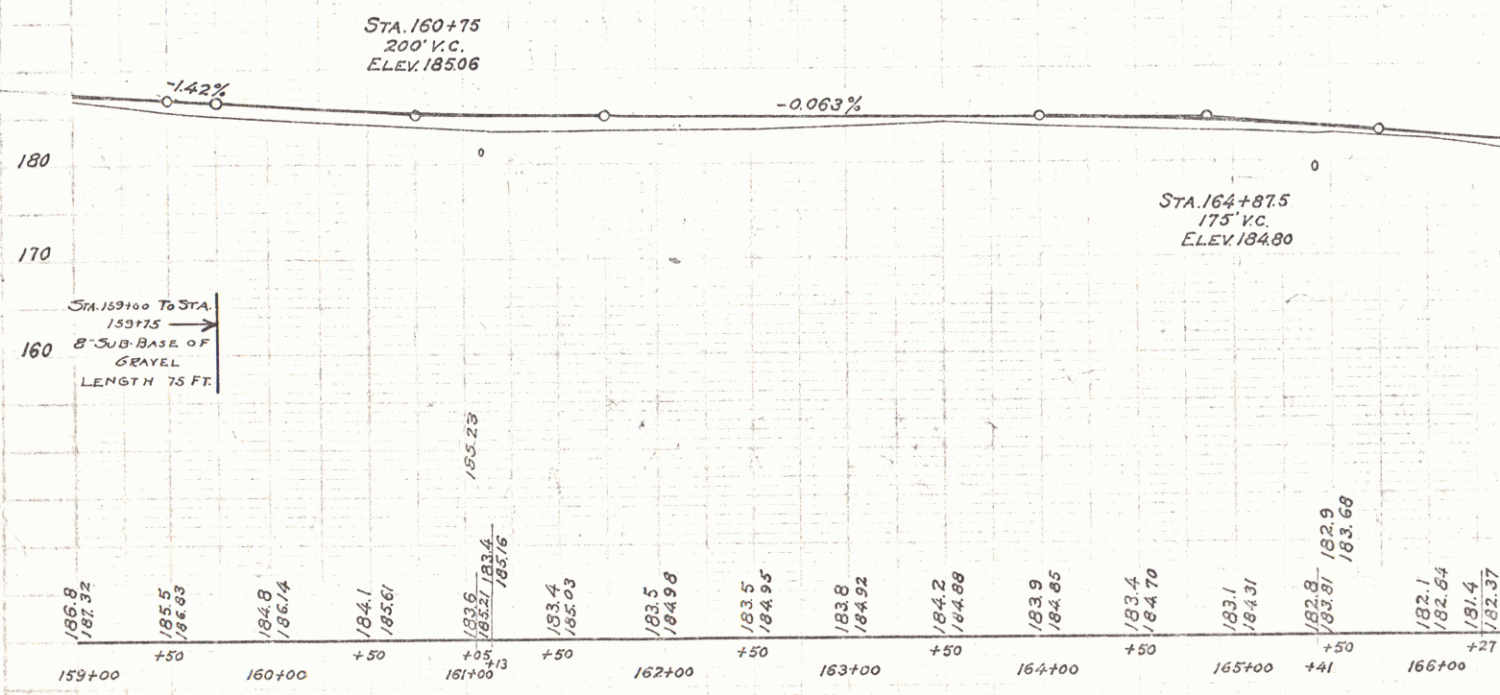

B.M. 15 N.E. COR. FOUNDATION SIGNAL TOWER #648 LT. STA. 160+28 ELEV 188.58
 B.M. 16 SPIKE IN ROOT 17" ELM 16 FT. RT. STA. 165+95 ELEV 181.27