


BITUMINOUS MACADAM

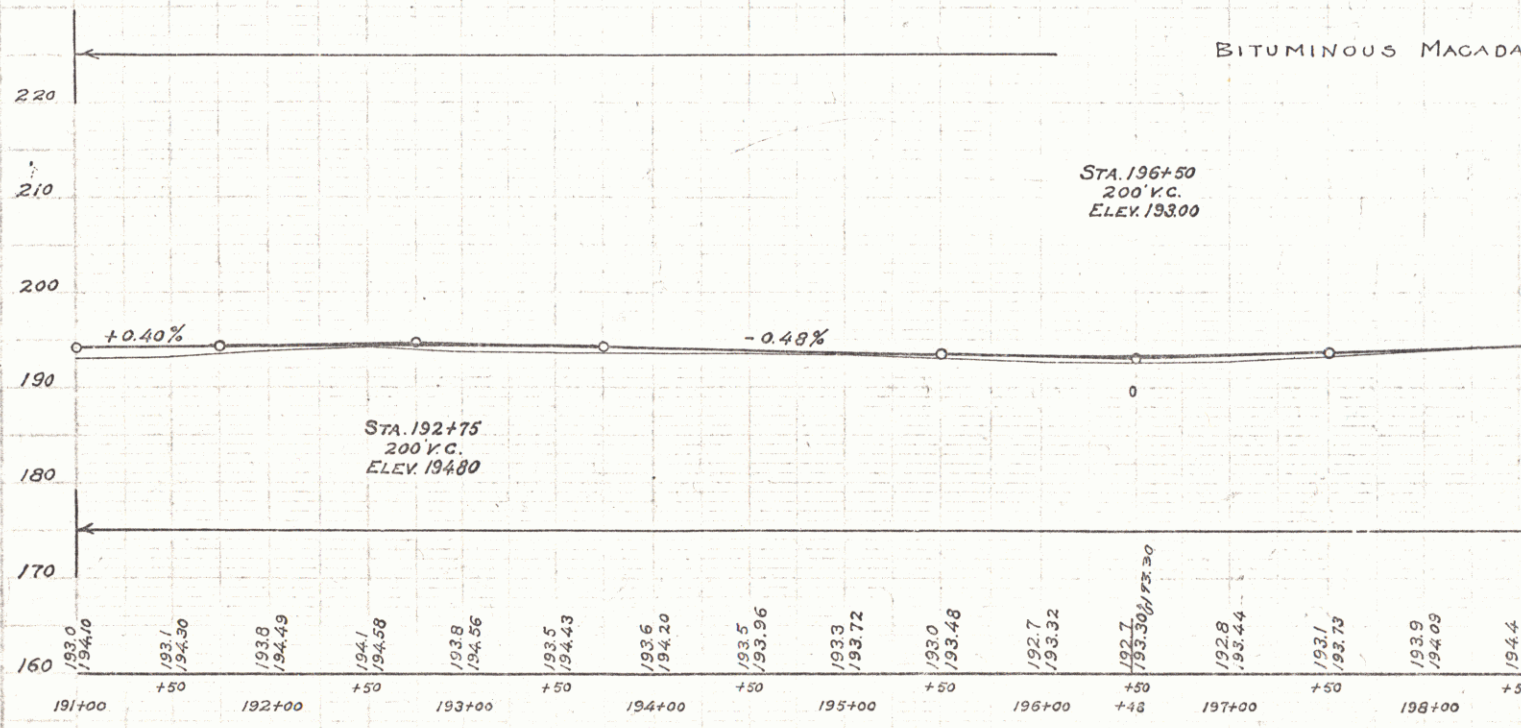

B.M. 20 SPIKE IN ROOT 30" ELM RT. STA. 198+15 ELEV. 195.46
 B.M. 21 SPIKE IN TRUNK 12" ELM 13 FT. LT. STA. 205+21 ELEV. 209.33