


Note - 46' of 6" drain @ Sta 266+50 ±
North of R.R. X. at Sta 204+10

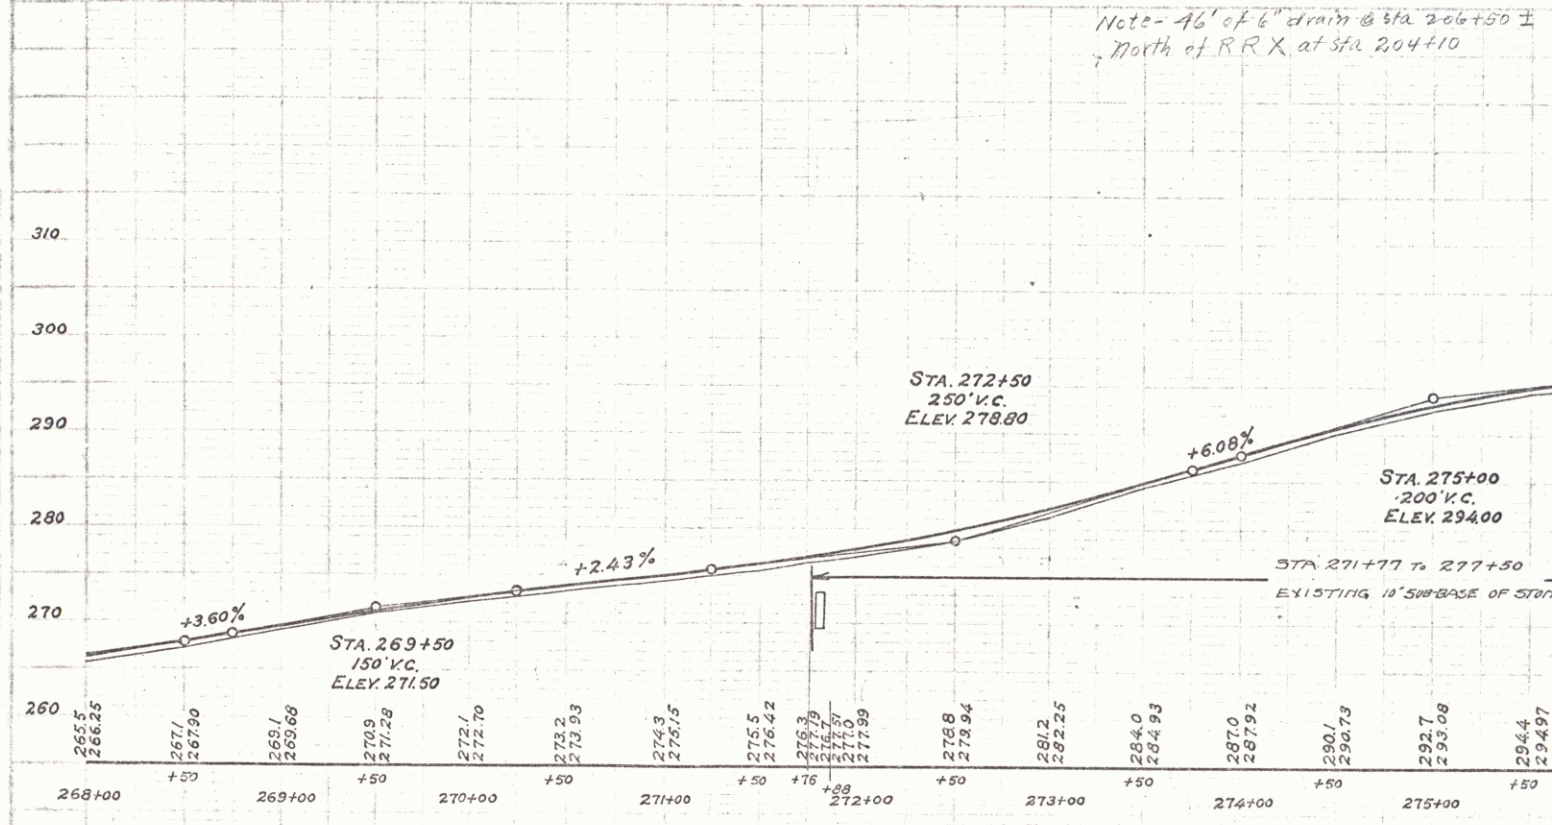

B. M. No. 28 Spike in Root of 12" Elm. Left of Sta. 271+28 Elev. 274.66