


#121
Oct. 1961
Oct. 1961
Oct. 1961

A.A.D.
A.W.C.
A.W.C.
A.W.C.

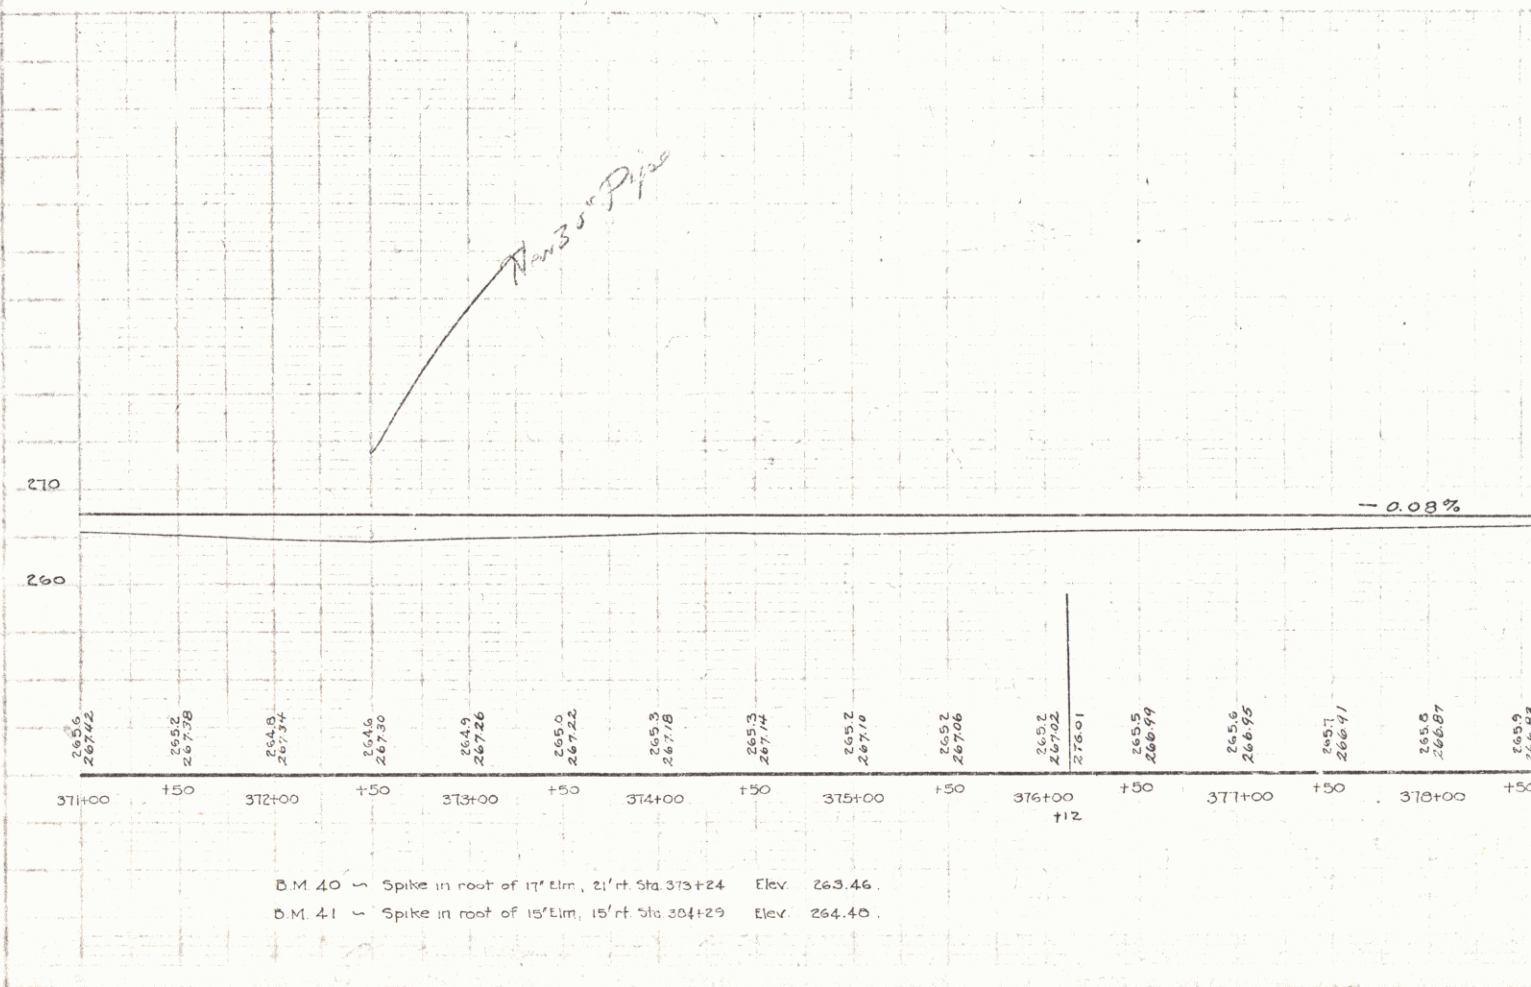

B.M. 40 ✓ Spike in root of 17' Elm, 21' rt Sta 373+24 Elev. 263.46.
B.M. 41 ✓ Spike in root of 15' Elm, 15' rt Sta 374+29 Elev. 264.40.