


1981
 Oct. 1981
 Oct. 1981
 Oct. 1981

A.A.D.
 A.M.C.
 E.M.N.
 A.M.C.

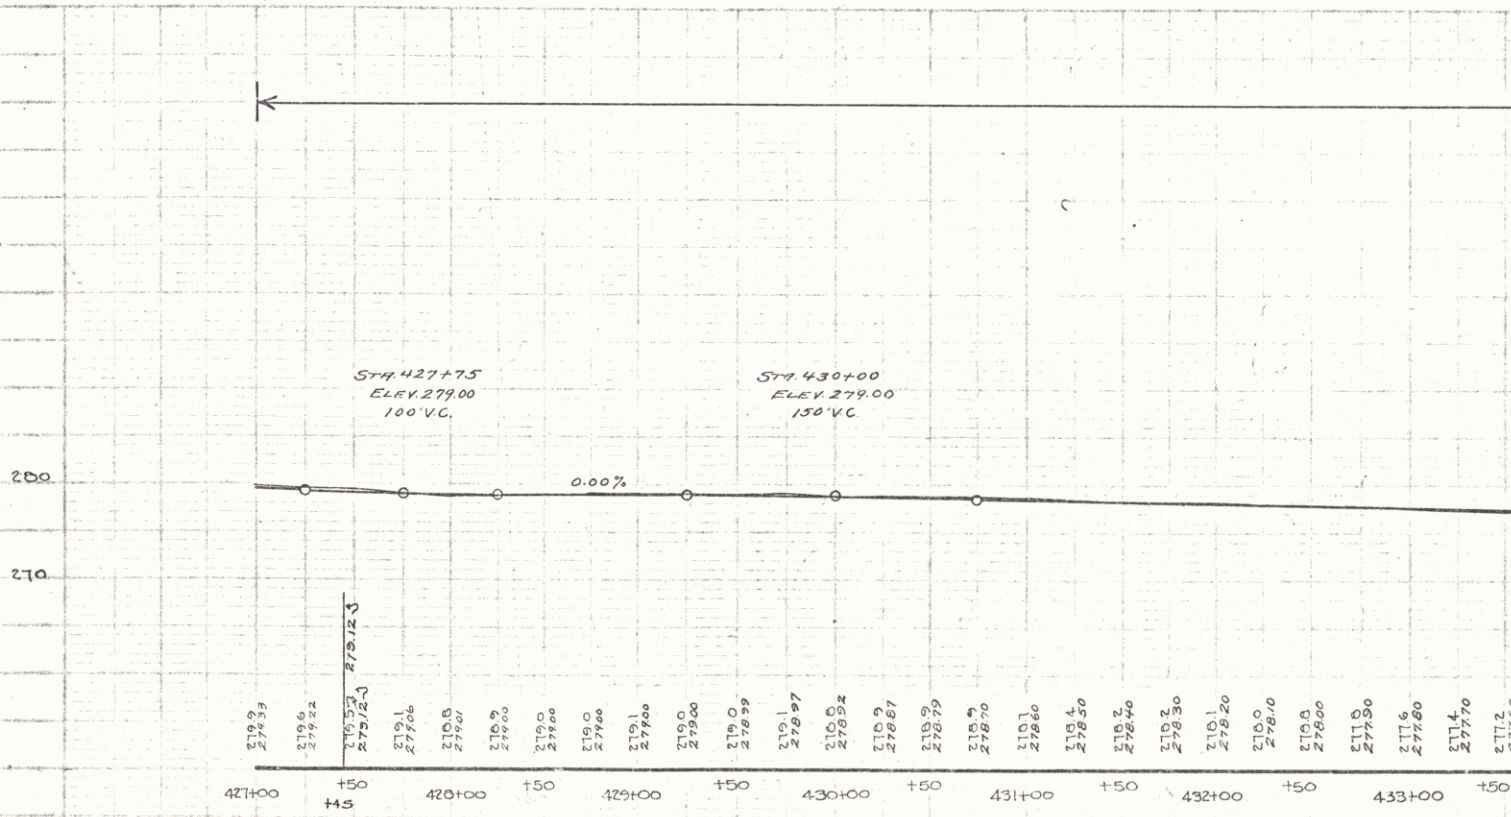

B.M. 47 Spike in root of 15' Elm, 26' ft. S. 433+16 - Elev. 278.98