



PLAN  
 DRAWN BY  
 CHECKED BY  
 DATE

PROFILE  
 DRAWN BY  
 CHECKED BY  
 DATE

WOOD GUIDE POSTS  
 0+00 L.A. & R.R. 2.

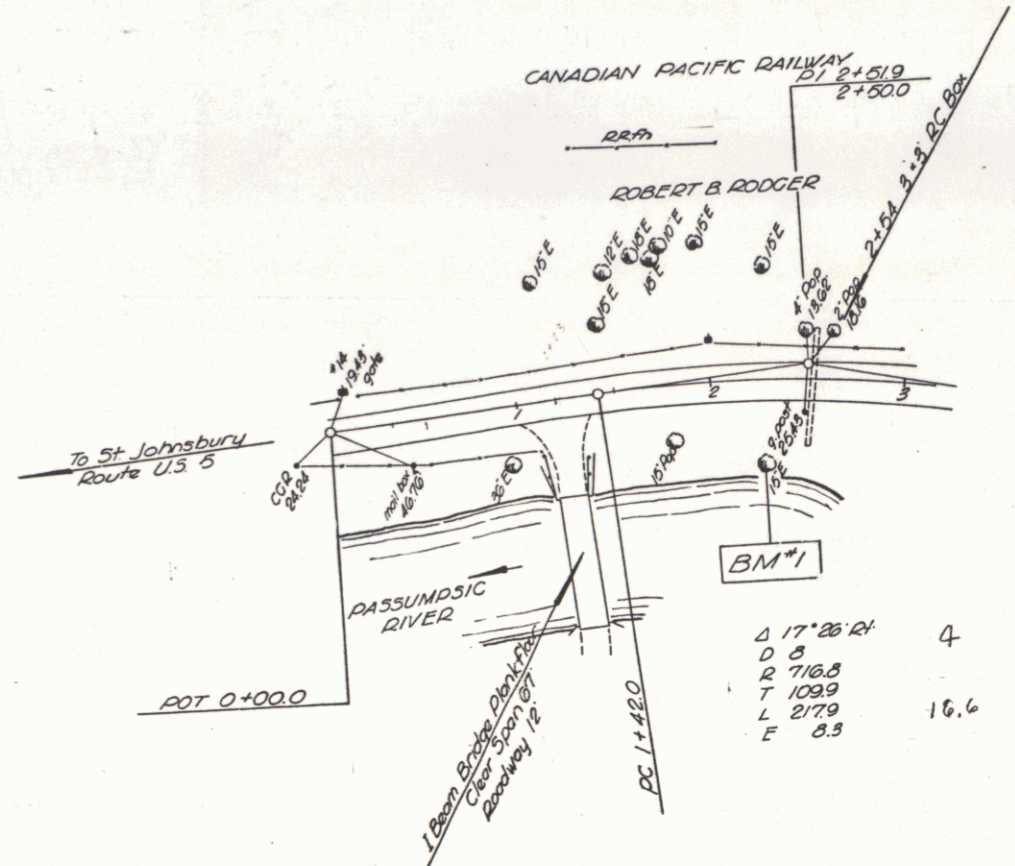

$\Delta$  17° 26' 24" 4  
 D 8  
 R 716.8  
 T 109.9  
 L 217.9  
 E 3.5 16.6

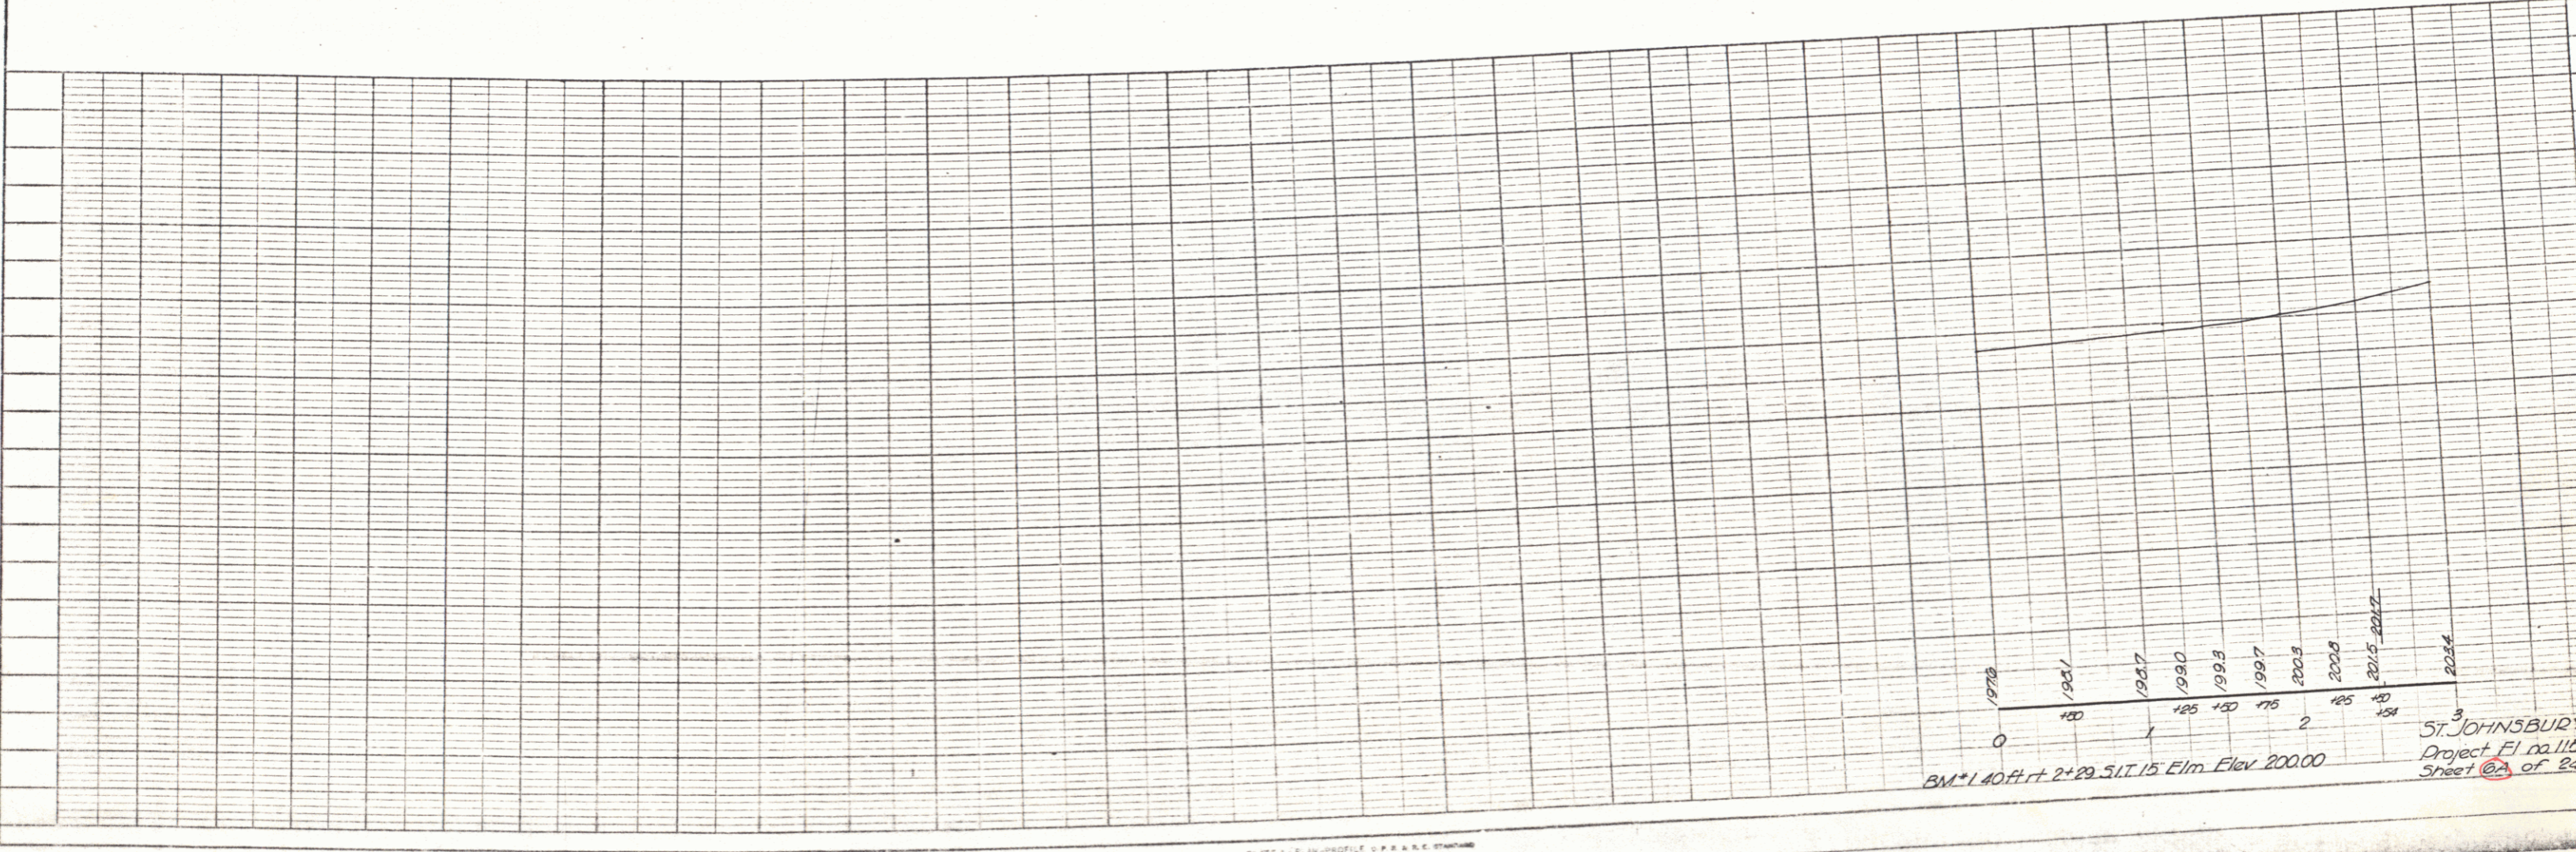

1978  
 1981  
 1987  
 1990  
 1998  
 1997  
 2003  
 2005  
 2012  
 2014

ST. JOHNSBURY  
 Project E1 no. 115  
 Sheet 23 of 24

PLATE 1 - PLAN - PROFILE - C.P. & R.R. STATIONING  
 ENGINEER & ARCHITECTS  
 115 N. STATE ST. ST. JOHNSBURY, VT. 05490  
 U.S.G. CO. NO. 348-15