
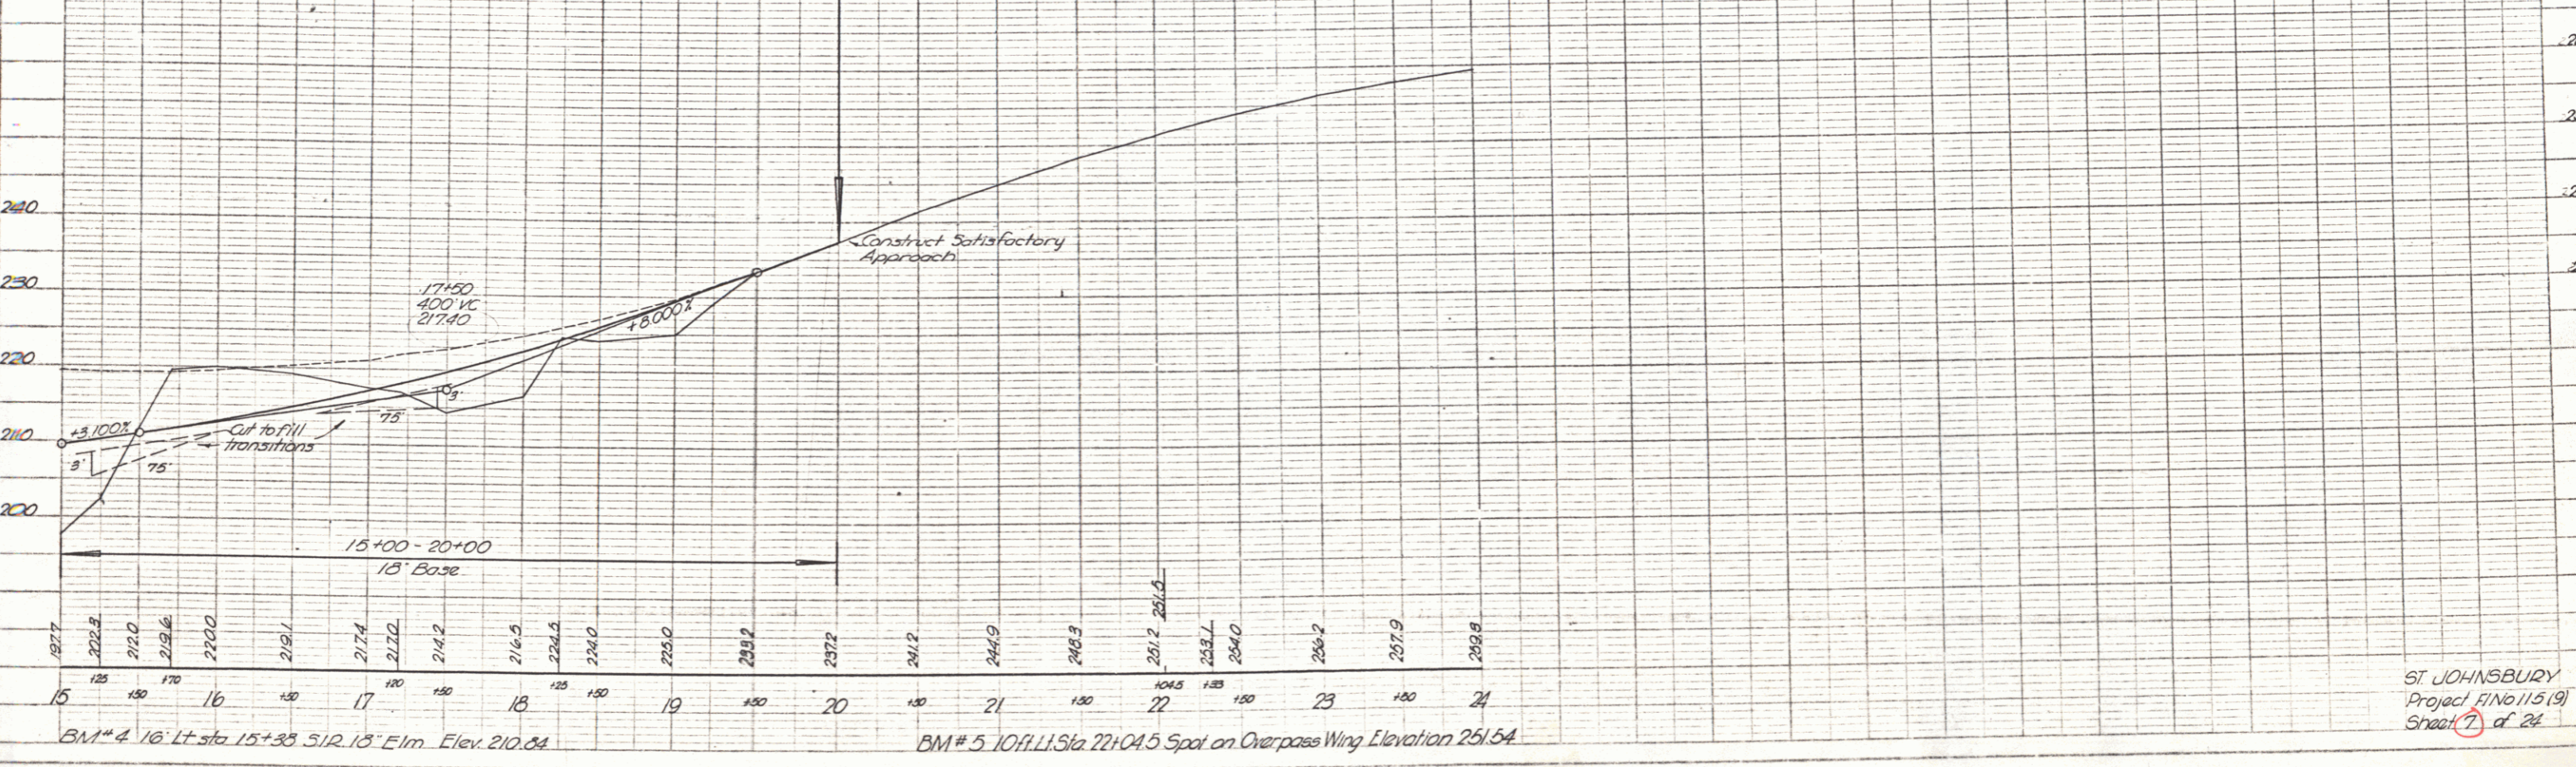


PLAN  
 DRAWN BY: Hurby  
 CHECKED BY: Hurby  
 DATE: 1/31/54  
 PROJECT: ST. JOHNSBURY  
 SHEET: 7 of 24

PROFILE  
 DRAWN BY: Hurby  
 CHECKED BY: Hurby  
 DATE: 1/31/54  
 PROJECT: ST. JOHNSBURY  
 SHEET: 7 of 24

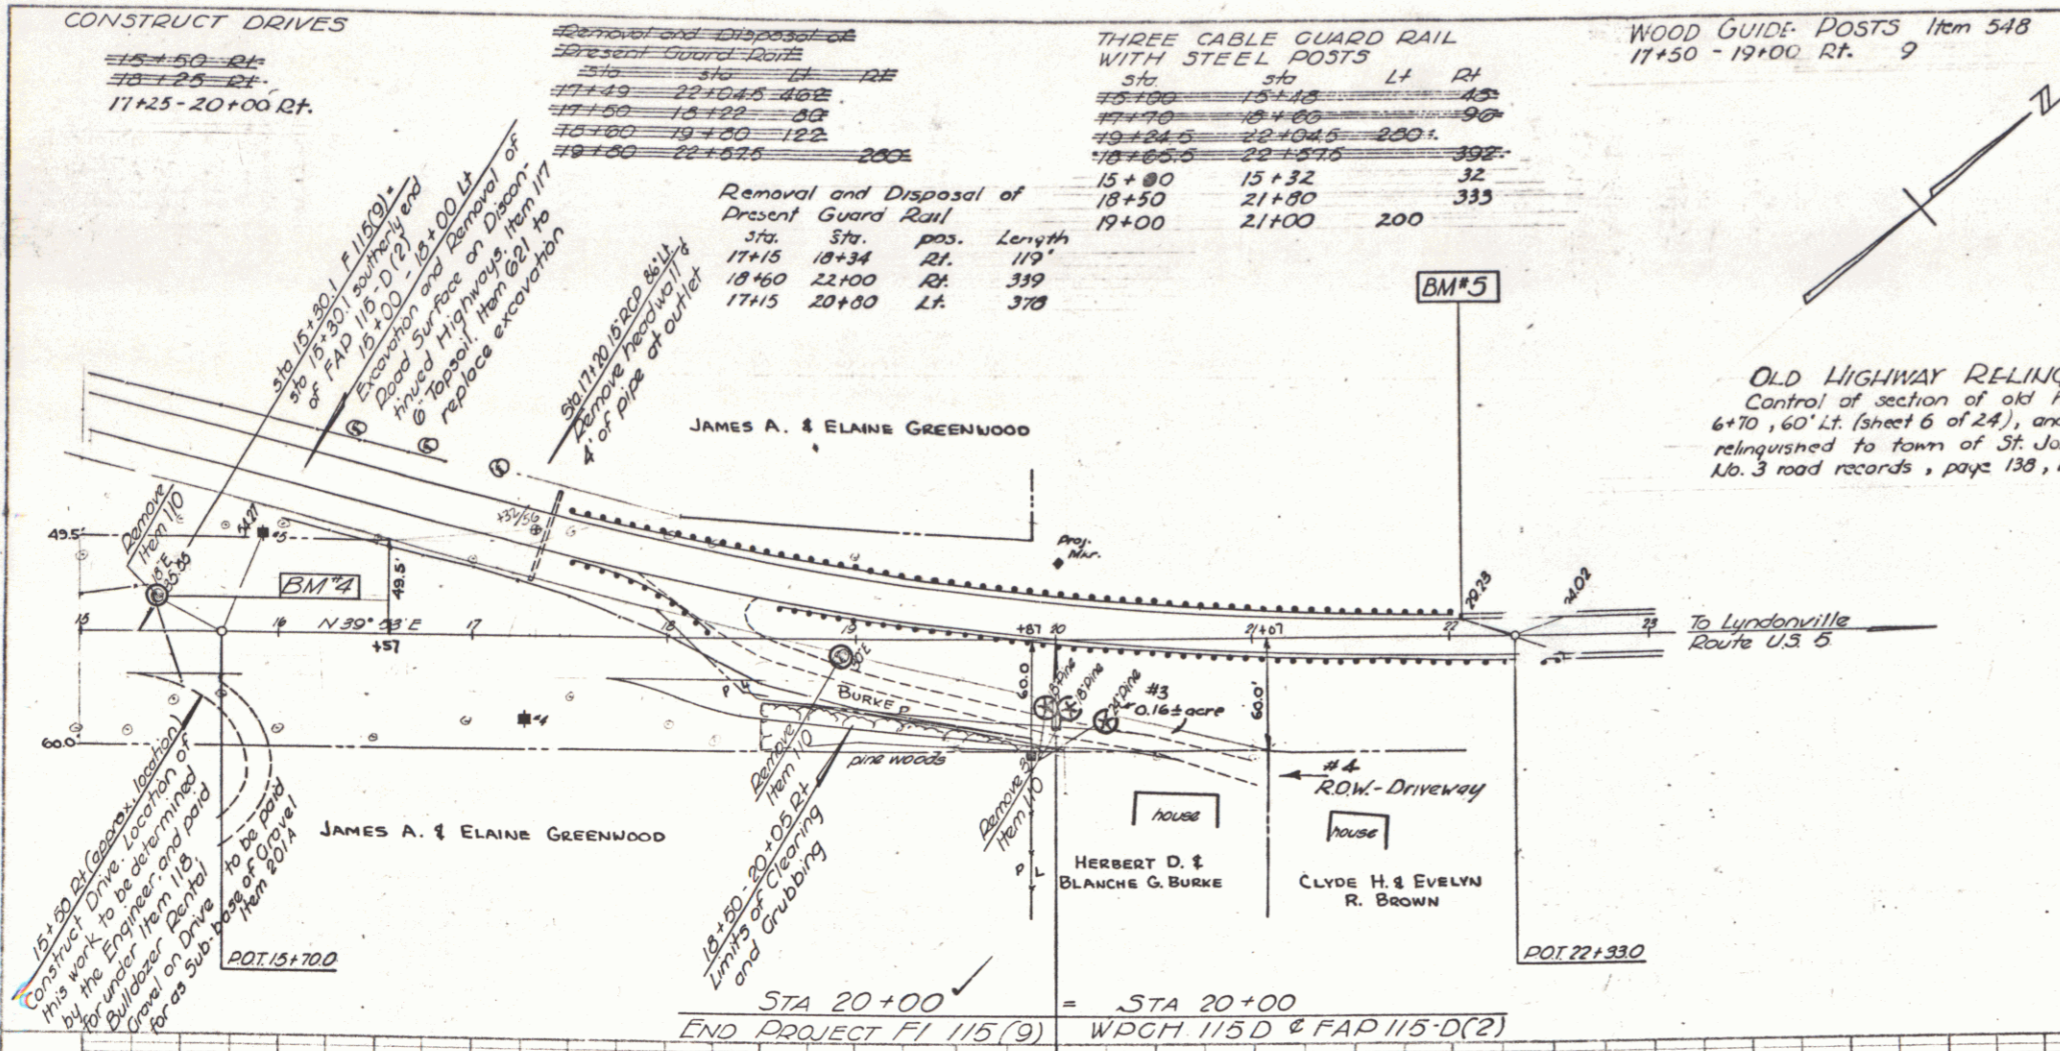

ST. JOHNSBURY  
 Project #115(9)  
 Sheet 7 of 24

PLATE 1 - PLAN-PROFILE OF R.R. & ST. JOHNSBURY  
 DRAWN BY: HURBY  
 CHECKED BY: HURBY  
 DATE: 1/31/54