


DRAWER # 129

INDEX OF SHEETS

- 1- TITLE PAGE
- 2- TYPICAL CROSS SECTION OF IMPROVEMENT
- 3- DRAINAGE & ITEM QUANTITY SHEET
- 4- EARTHWORKS
- 5- PLAN & PROFILE SHEET
- 6- BRIDGE PLAN SHEET
- 7- SUPERSTRUCTURE DETAILS
- 8- ABUTMENT #1
- 9- PIER #1
- 10- PIER #2
- 11- ABUTMENT #2
- 12- STEEL REINFORCING SHEET
- 13- STANDARD BRIDGE SHEET SCB-30-58
- 14- STANDARD BRIDGE SHEET SB-20-56
- 15- STANDARD BRIDGE SHEET SB-22-58
- 16- STANDARD BRIDGE SHEET SB-56-57
- 17- STANDARD SHEET A-61 (DRILLING & BLASTING)
- 18- STANDARD SHEET B-1 (BANKING TABLES)
- 19- STANDARD SHEET C-1 (CURBS)
- 20- STANDARD SHEET D-2 (DRAINAGE)
- 21- STANDARD SHEET D-8 (RCDL)
- 22- STANDARD SHEET D-9 (RCDL TOP)
- 23- STANDARD SHEET D-11 (STEEL GRATE)
- 24- STANDARD SHEET E-1 (BARRICADES, SIGNS & LIGHTS)
- 25- STANDARD SHEET E-2 (BARRICADES, SIGNS & LIGHTS)
- 26- STANDARD SHEET G-3 (GUARD RAIL)
- 27- STANDARD SHEET G-4 (GUIDE POSTS)
- 28- STANDARD SHEET J-1 (MARKERS)
- 29- STANDARD SHEET H-1a (METAL BIN-TYPE RETAINING WALL)
- 30- STANDARD SHEET H-1b (METAL BIN-TYPE RETAINING WALL)
- 31-38 CROSS SECTIONS
- 39-43 CHANNEL SECTIONS

STATE OF VERMONT
DEPARTMENT OF HIGHWAYS
PROPOSED IMPROVEMENT
TOWN OF ST. JOHNSBURY
COUNTY OF CALEDONIA *Pin# 99R233*
U.S. ROUTE 5
ST. JOHNSBURY-LYNDONVILLE ROAD

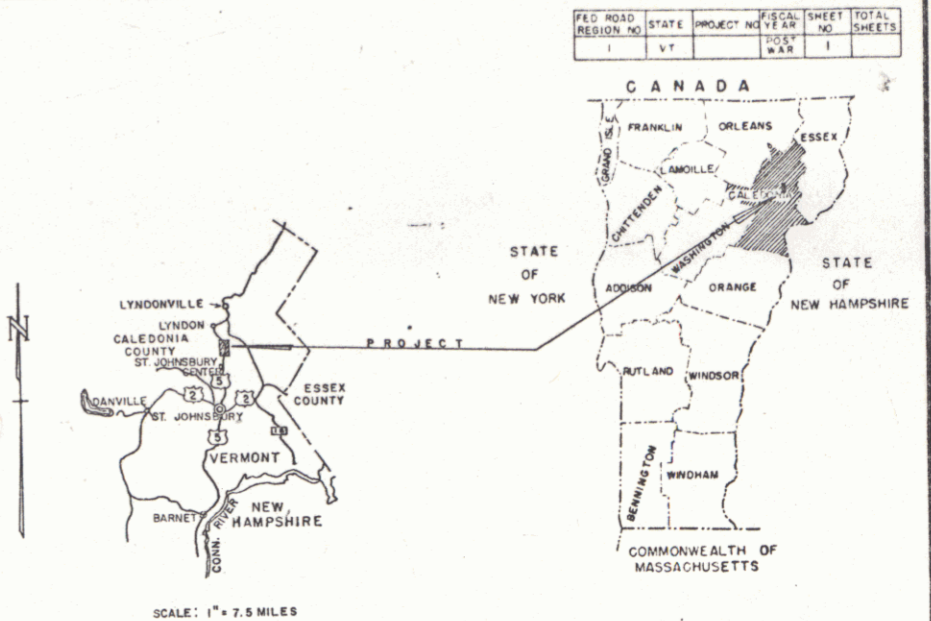

BEGINNING AT A POINT 5974.2 FEET SOUTHWESTERLY OF THE ST. JOHNSBURY-LYNDON TOWN LINE AND EXTENDING NORTHEASTERLY 1000.0 FEET.

LENGTH OF ROADWAY	1302.00	0.247
	752.05 FT.	0.142 MILES
LENGTH OF BRIDGE	247.95 FT.	0.047 MILES
LENGTH OF PROJECT	1000.00 FT.	0.189 MILES
	1,549.95	0.294


1960 ADT	3275
1980 ADT	2900
1980 DHV	420
D	62%
T	6%
V	40 MPH

PROJECT-NAME-&NUMBER-TYPE-PAVEMENT-AREA
ST. JOHNSBURY-F041-5(1)-BIT-CONC. 4,009 SY
RECORD PLANS MATERIALS

SUB-BASE OF GRAVEL - BEGIN PIT - LYNDON, VT.
CRUSHED GRAVEL BASE COURSE - CALEDONIA SAND & GRAVEL CO. WATERFORD, VERMONT.
GRANITE BRIDGE-CURB-ROCK OF AGES CORP BARRE, VERMONT.
TAR EMULSION - KOPPERS CO. INC. - PITTSBURG, PA.
ASPHALTIC CEMENT - SOCONY VACUUM - E. PROVIDENCE R.I.
ASPHALTIC ASBESTOS COATING - BARRETT CO. MALDEN, MASS.
BITUMINOUS CONCRETE - L.M. PIKE & SON LISBON, N.H.
CONCRETE CLASS "B" CARPENTER'S REDDY MIX CONCRETE - ST. JOHNSBURY, VT.
REINFORCING STEEL - BETHLEHEM STEEL CO. - BETHLEHEM, PA.
STRUCTURAL STEEL, BRIDGE RAILING & CAST IRON DROP INLET GRATES - VERMONT STRUCTURAL STEEL CO. BURLINGTON, VT.
BRIDGE PAINT - WATERPROOF PAINT & VARNISH CO. WATERTOWN, MASS.
18" ASPH. CLD. CORR. GALV. METAL PIPE - NORTHEASTERN CULVERT CO. - WESTMINSTER, VERMONT.
METAL BIN TYPE RETAINING WALL - NEW-ENGLAND METAL PIPE CORP. BOS. MASS.
THREE CABLE GUARD RAIL, STEEL MARKER POSTS & TREATED TIMBER-CURB - ST. GRISWOLD & CO. INC. - ESSEX JUNCTION, VT.

CONTRACTOR: OLSON CONSTRUCTION CORP. MONTPELIER, VT.
RES. ENG. FRANK E. ALDRICH
RECORD PLANS - A.G. SPIDLE

CONTRACT DATED - JULY 25, 1961
STARTED - JULY 31, 1961
COMPLETED - JUNE 28, 1962
ACCEPTED - JUNE 28, 1962

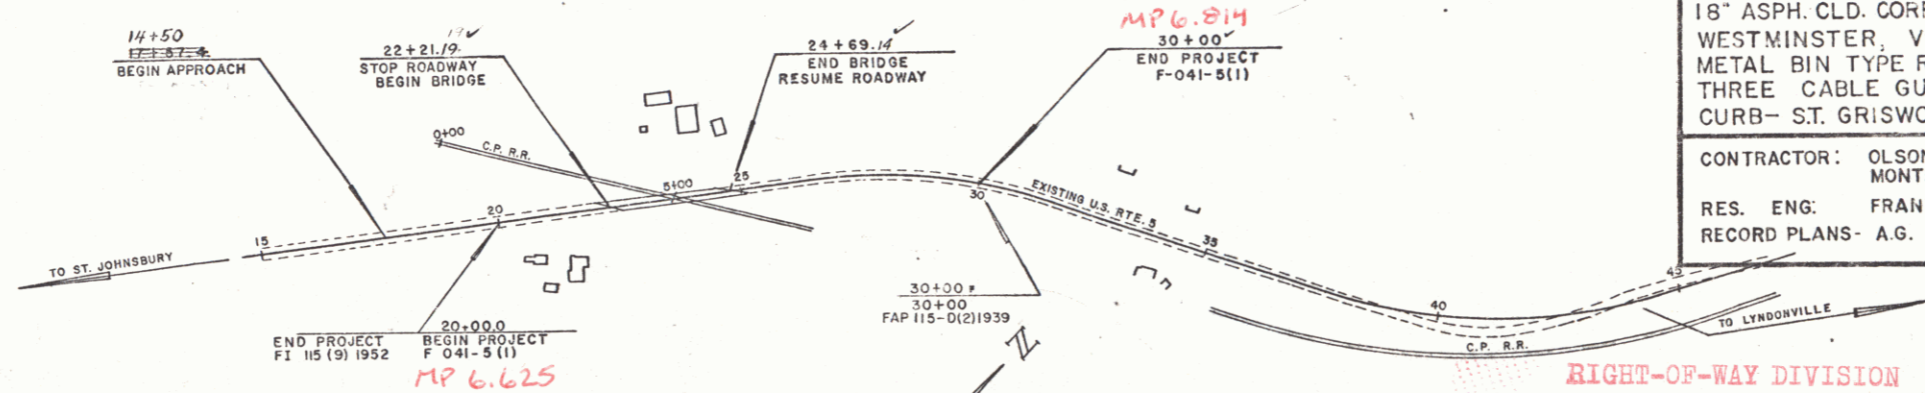

COUNT	ST. JOHNSBURY	LENGTH 1,549.95 M.L. 0.294
TOWN	ST. JOHNSBURY	
FENCE		
STONE		
UNFEN		
GUARD		
TRAVE		
RAILRC		
RETAIN		
CENTER		
SURVEY		
CULVER		
DROP I		
TROLLE		
POWER		
TELEPH		
TREES		
HEDGE		

ST. JOHNSBURY F 041-5(1)
CONTRACTOR: OLSON CONSTRUCTION CORP. MONTPELIER, VT.
RECORD PLANS - A.G. SPIDLE
CONST. COMPLETED JUNE 28, 1962

SCALES

TITLE	1" = 200'
TYPICAL	1" = 3'
PLAN	1" = 50'
PROFILE HORIZONTAL	1" = 50'
PROFILE VERTICAL	1" = 10'
CROSS-SECTIONS	1" = 10'

RIGHT-OF-WAY DIVISION
TOWN FILE
PERPETUAL
Town of US5
(To Be Returned To R.O.W. Division)

REVISED PLANS AUGUST 8, 1961 W.M.S.

NOTE: ANY FURTHER INFORMATION CONCERNING FINAL QUANTITIES, AMOUNTS OR OTHER DETAILS RELATIVE TO THIS PROJECT MAY BE FOUND IN EITHER THE FIELD BOOKS OR THE ESTIMATE FILE.

THESE PLANS ARE SUBJECT TO SUCH REVISIONS AS MAY BE REQUIRED BY THE BUREAU OF PUBLIC ROADS OR THE COMMISSIONER OF HIGHWAYS.
CONSTRUCTION IS TO BE CARRIED ON IN ACCORDANCE WITH THE PLANS AND THE STANDARD SPECIFICATIONS FOR HIGHWAY AND BRIDGE CONSTRUCTION OF JANUARY 1958 SUBMITTED TO THE BUREAU OF PUBLIC ROADS AS APPROVED JULY 5, 1956, INCLUDING ALL SUBSEQUENT APPROVED REVISIONS AND SUCH REVISED SPECIFICATIONS AND SPECIAL PROVISIONS AS ARE SUBMITTED WITH THE PLANS.

DEPARTMENT OF COMMERCE
BUREAU OF PUBLIC ROADS

APPROVED _____
DIVISION ENGINEER DATE _____

PROJECT F NO 041-5(1)
SHEET 1 OF 43 SHEETS

APPROVED _____ DATE _____ SECONDARY ENGINEER	APPROVED _____ DATE _____ CONSTRUCTION ENGINEER	APPROVED _____ DATE _____ BRIDGE ENGINEER	APPROVED _____ DATE _____ DISTRICT ENGINEER	APPROVED _____ DATE _____ HIGHWAY ENGINEER	APPROVED _____ DATE _____ CHIEF ENGINEER
--	---	---	---	--	--