


DETAILS OF NEW BRIDGE--  
 TYPE - I-Bm - 68' SKEW - CONC. FLOOR  
 CLEAR SPANS - 3-80'    L&TH OVERALL - 252'-0"  
 " ROADWAY - 20'-0"  
 " HEIGHT ABOVE TRACKS - 21'-1"

PROJECTED BY: [blank]  
 DESIGNED BY: [blank]  
 DRAWN BY: [blank]  
 CHECKED BY: [blank]  
 DATE: 11-5-36  
 SHEET NO. 48 OF 48

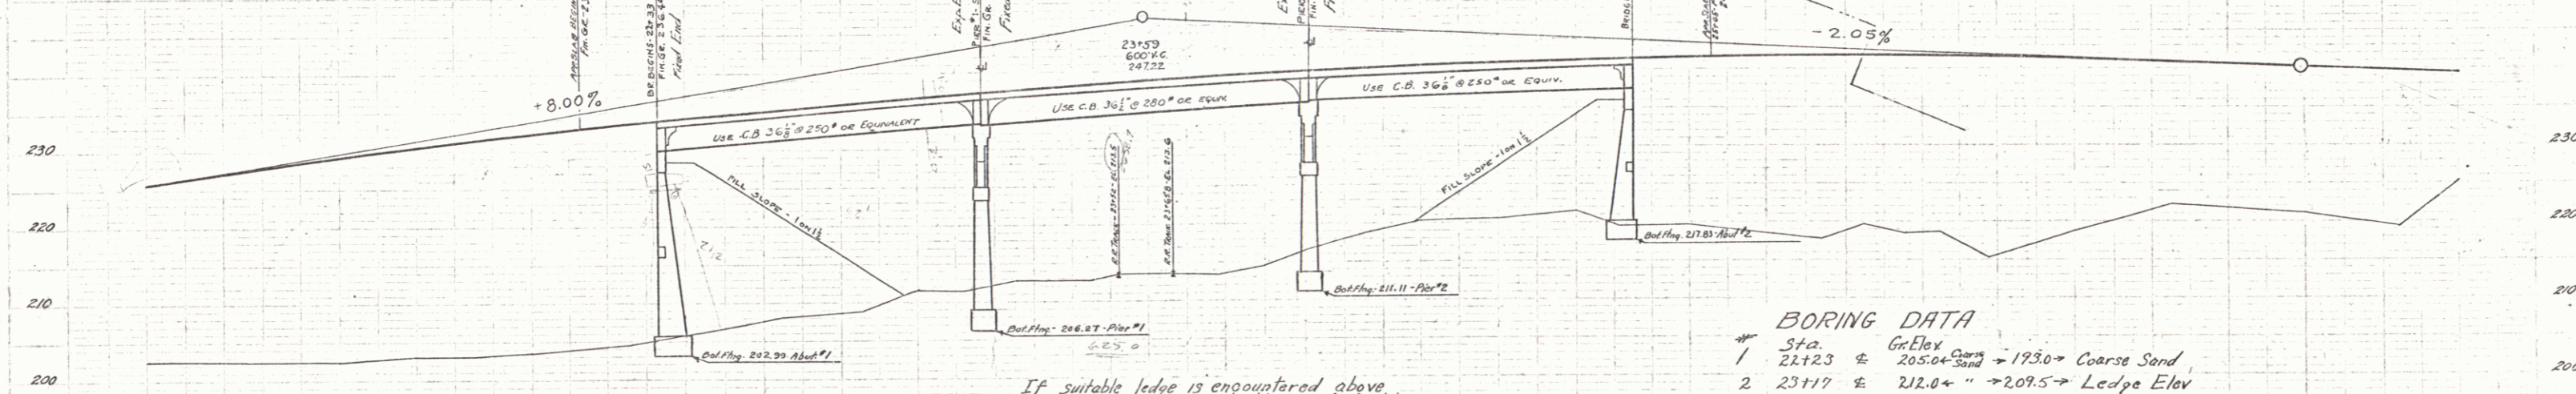


Parcel	Kind of Instrument	Date of Instrument	Grantor	Grantee	Recorded Book Page	Remarks
A.B.	N.D.	1-27-36	JOE & FANNIE HALL	ST. JOHNSBURY	100-1	1-31-36
A	N.D.	1-23-36	HANNAN CREAMER	"	78 178	1-28-36

If suitable ledge is encountered above elevation indicated for bottom of footings, the footing shall be raised to fit this condition and cut into ledge 6" after leveling.

**BORING DATA**

No.	Sta.	Gr. Elev.	Remarks
1	22+23	205.00	→ 193.0 → Coarse Sand
2	23+17	212.0	" → 209.5 → Ledge Elev
3A	23+90	214.0	" → 211.5 → " "
3B	24+05	218.0	" → 213.0 → " "
4	24+85	220.0	" → 218.0 → " "

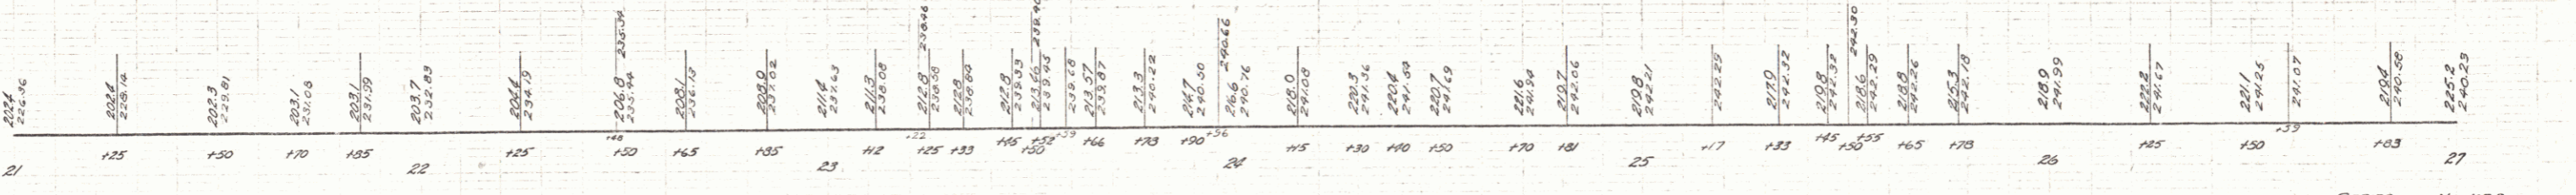

SERIES NO. 115-D  
 SHEET 5 OF 48