

Drawn # 129


INDEX OF SHEETS

1	TITLE SHEET
2	TYPICAL SHEET
3	DRAINAGE AND QUANTITY SHEET
4	EARTHWORK SHEET
5-6	PLAN AND PROFILE SHEETS
7	A-61 DRILLING AND BLASTING OF SOLID ROCK SUBGRADE
8	B-1 BANKING TABLES
9	B-5 TYPICAL SLOPE GRADING
10	B-10 EMBANKMENT ON A SLOPE
11	D-2 C.R.M. HEADWALLS
12	E-32 ROAD CONSTRUCTION APPROACH SIGNS
13	G-3 THREE CABLE GUARD RAIL
14	G-4 STEEL MARKER POSTS
15	J-1 PROJECT MARKERS AND BOUNDARY MARKERS
16	BLANK
17-24	CROSS SECTION SHEETS

FOR RIGHT-OF-WAY DETAILS, SEE RIGHT-OF-WAY PLANS

*Added Sheets
4-3 Earthworks
12-B-24-B Roadbed Specifications*

**STATE OF VERMONT
DEPARTMENT OF HIGHWAYS
PROPOSED IMPROVEMENT
TOWN OF ST. JOHNSBURY
COUNTY OF CALEDONIA
U.S. ROUTE 5
ST. JOHNSBURY-LYNDONVILLE ROAD**

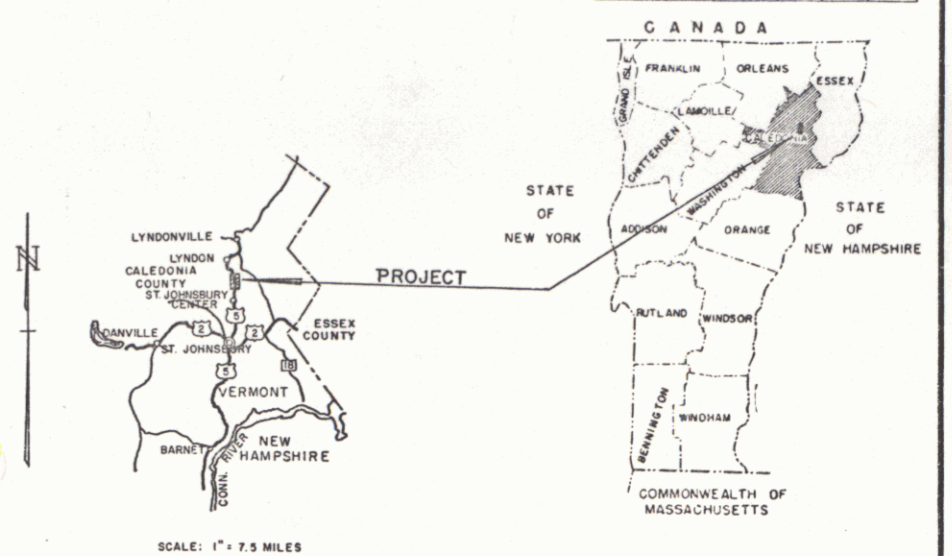


PROJECT NAME & NUMBER	TYPE	PAVEMENT	AREA
ST. JOHNSBURY SP 041-5-6505	BIT. CONC.	PAVT.	3,069 S.Y.
RECORD PLANS			
MATERIALS			
SUBBASE OF GRAVEL — HAMMAN PIT — LYNDONVILLE, VT.			
PLANT MIXED BASE COURSE & BITUMINOUS CONCRETE PAVEMENT			
— L.M. PIKE & SON INC. (PLANT) — WATERFORD, VT.			
ASPHALT — HUMBLE OIL — EVERETT, MASS.			
METAL CULVERT PIPE — NEW ENGLAND METAL CULVERT CO. — WHITE R. JCT., VT.			
REINFORCED CONC. PIPE & GUARD RAIL ITEMS — S.T. GRISWOLD & CO., INC. — WILLISTON, VT.			
CONTRACTOR — COOLEY CONSTR. CO., INC. & AFFILIATE MONTPELIER, VT.		CONTRACT:	
RESIDENT ENGINEER — HERBERT J. WASHER.		DATED — MAY 29, 1967.	
INSPECTOR — B. G. FISSETTE.		STARTED — MAY 24, 1967.	
RECORD PLANS — A. G. SPIDLE.		COMPLETED — SEPT. 1, 1967.	
		ACCEPTED — SEPT. 2, 1967.	

BEGINNING AT A POINT 4374.2 FEET SOUTHWESTERLY OF THE ST. JOHNSBURY-LYNDONVILLE TOWN LINE AND EXTENDING NORTHEASTERLY 1255.1 FEET.

LENGTH OF ROADWAY 1255.1 FT. 0.238 MILE
LENGTH OF PROJECT 1255.1 FT. 0.238 MILE

Project SP 041-5-6505

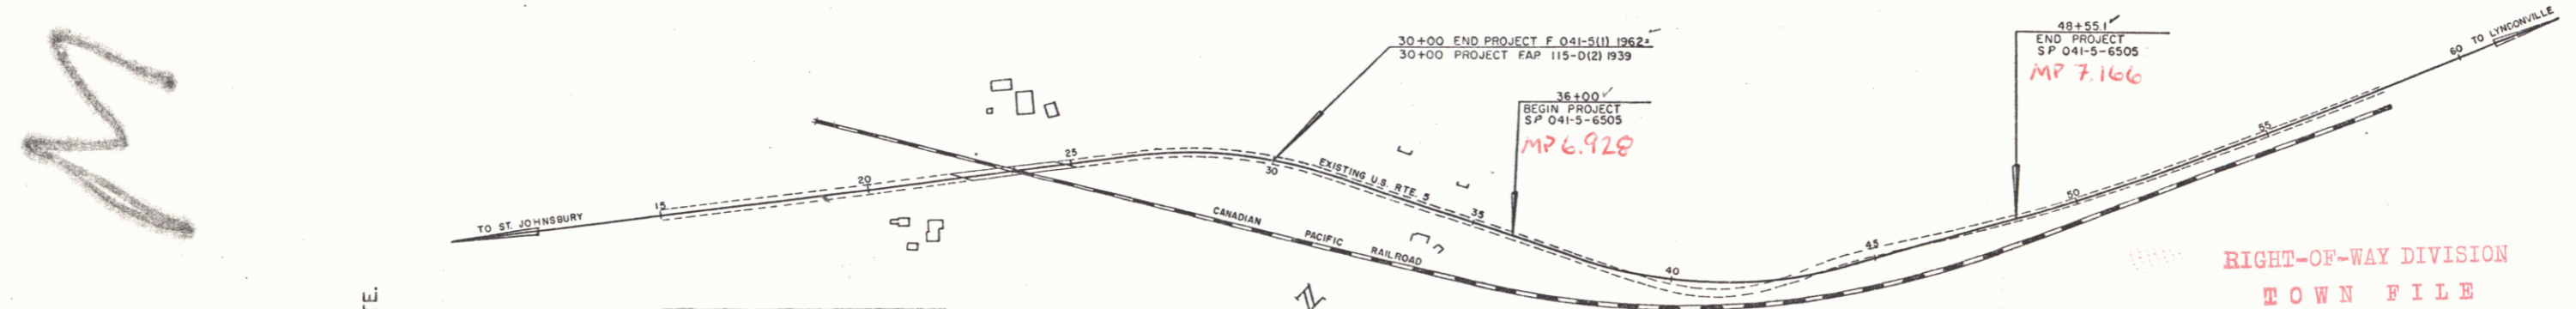

CONVENTIONAL SIGNS

COUNTY LINE	---
TOWN LINE	---
FENCE LINE	---
STONE WALL	---
UNFENCED PROPERTY	---
GUARD RAIL	---
TRAVELED WAY	---
RAILROAD	---
RETAINING WALL	---
CENTER LINE	---
SURVEY LINE	---
CULVERT	---
DROP INLET	---
ROLLY POLE	---
POWER POLE	---
TELEPHONE POLE	---
TREES	---
HEDGE	---

PROJECT	ST. JOHNSBURY
ROUTE	SP 041-5-6505
TYPE	BITUMINOUS CONCRETE PAVEMENT
CONTRACTOR	COOLEY CONSTRUCTION CO. INC. & AFFILIATE MONTPELIER, VT.
YEAR	1967
LOCATION	BEGINNING AT A POINT 4374.2 FEET SOUTHWESTERLY OF THE ST. JOHNSBURY-LYNDONVILLE TOWN LINE AND EXTENDING NORTHEASTERLY 1255.1 FEET.

RIGHT-OF-WAY DIVISION
TOWN FILE
PERPETUAL
Rte
Town of USS
(To Be Returned To R.O.W. Division)

THESE PLANS ARE SUBJECT TO SUCH REVISIONS AS MAY BE REQUIRED BY THE BUREAU OF PUBLIC ROADS OR THE COMMISSIONER OF HIGHWAYS.
CONSTRUCTION IS TO BE CARRIED ON IN ACCORDANCE WITH THESE PLANS AND THE STANDARD SPECIFICATIONS FOR HIGHWAY AND BRIDGE CONSTRUCTION, DATED APRIL, 1964, AS APPROVED BY THE BUREAU OF PUBLIC ROADS ON OCTOBER 12, 1964, INCLUDING ALL SUBSEQUENT APPROVED REVISIONS AND SUCH REVISED SPECIFICATIONS AND SPECIAL PROVISIONS AS ARE INCORPORATED IN THESE PLANS.

APPROVED <i>C. Washburn</i> ASST. CHIEF ENGINEER	APPROVED _____ CONSTRUCTION ENGINEER	APPROVED _____ BRIDGE ENGINEER	APPROVED <i>P. M. Stone</i> INSPECTOR	APPROVED <i>G. M. Lant</i> INSPECTOR	APPROVED <i>R. H. Curren</i> CHIEF ENGINEER
DATE 8/15/66	DATE	DATE	DATE 8/15/66	DATE 8/15/66	DATE 8/17/66

DEPARTMENT OF COMMERCE BUREAU OF PUBLIC ROADS	
APPROVED _____	DATE _____
PROJECT SP NO. 041-5-6505	
SHEET (1) OF 26 SHEETS	