


PLAN
 DATE: _____
 BY: _____
 CHECKED: _____
 IN CHARGE: _____
 PROJECT NO.: _____

PROFILE
 DATE: _____
 BY: _____
 CHECKED: _____
 IN CHARGE: _____
 PROJECT NO.: _____

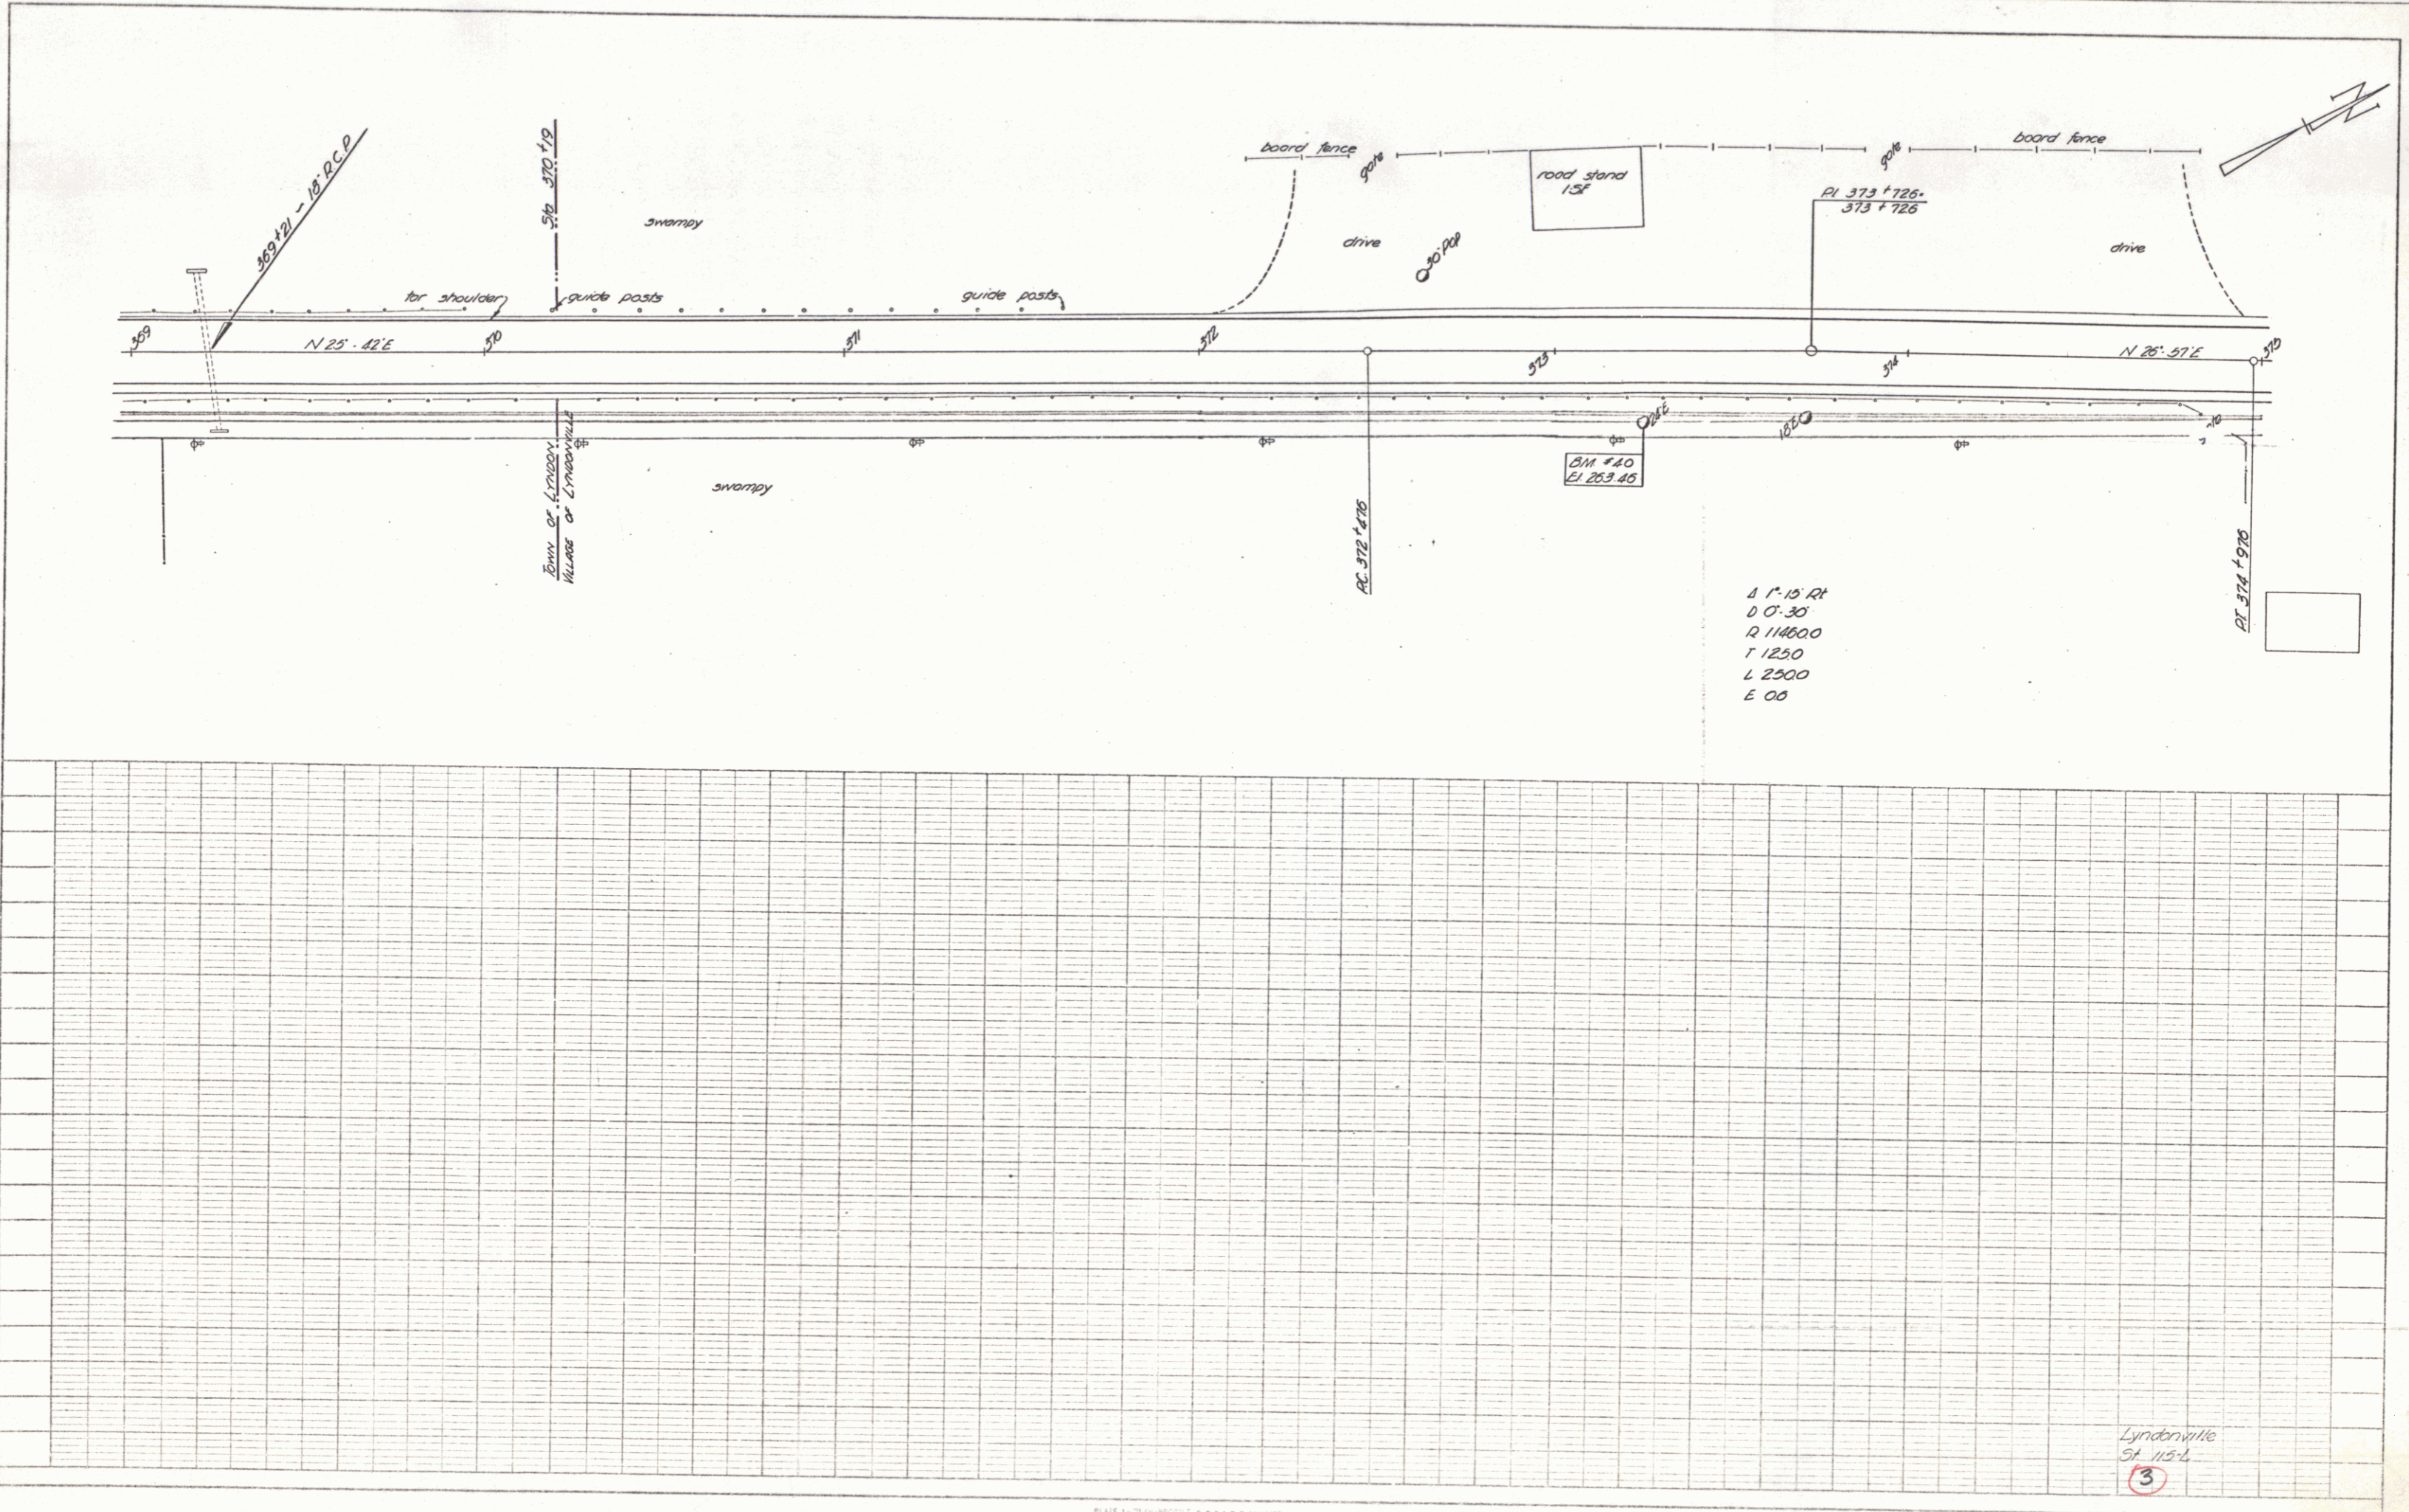

Lyndonville
 St. 113-4
 3

PLATE 1-774-PROFILE & PLAN SHEETS
 1957-1958 EAST COLLEGE ROAD
 N. S. L. & S. S. L.